


BM 155.50 SE Cor. Cone. Pave. 115' x 38' 3" Castle
 BM 150.55 NW Cor. Cone. Pave. 115' x 46' 0" Waverly

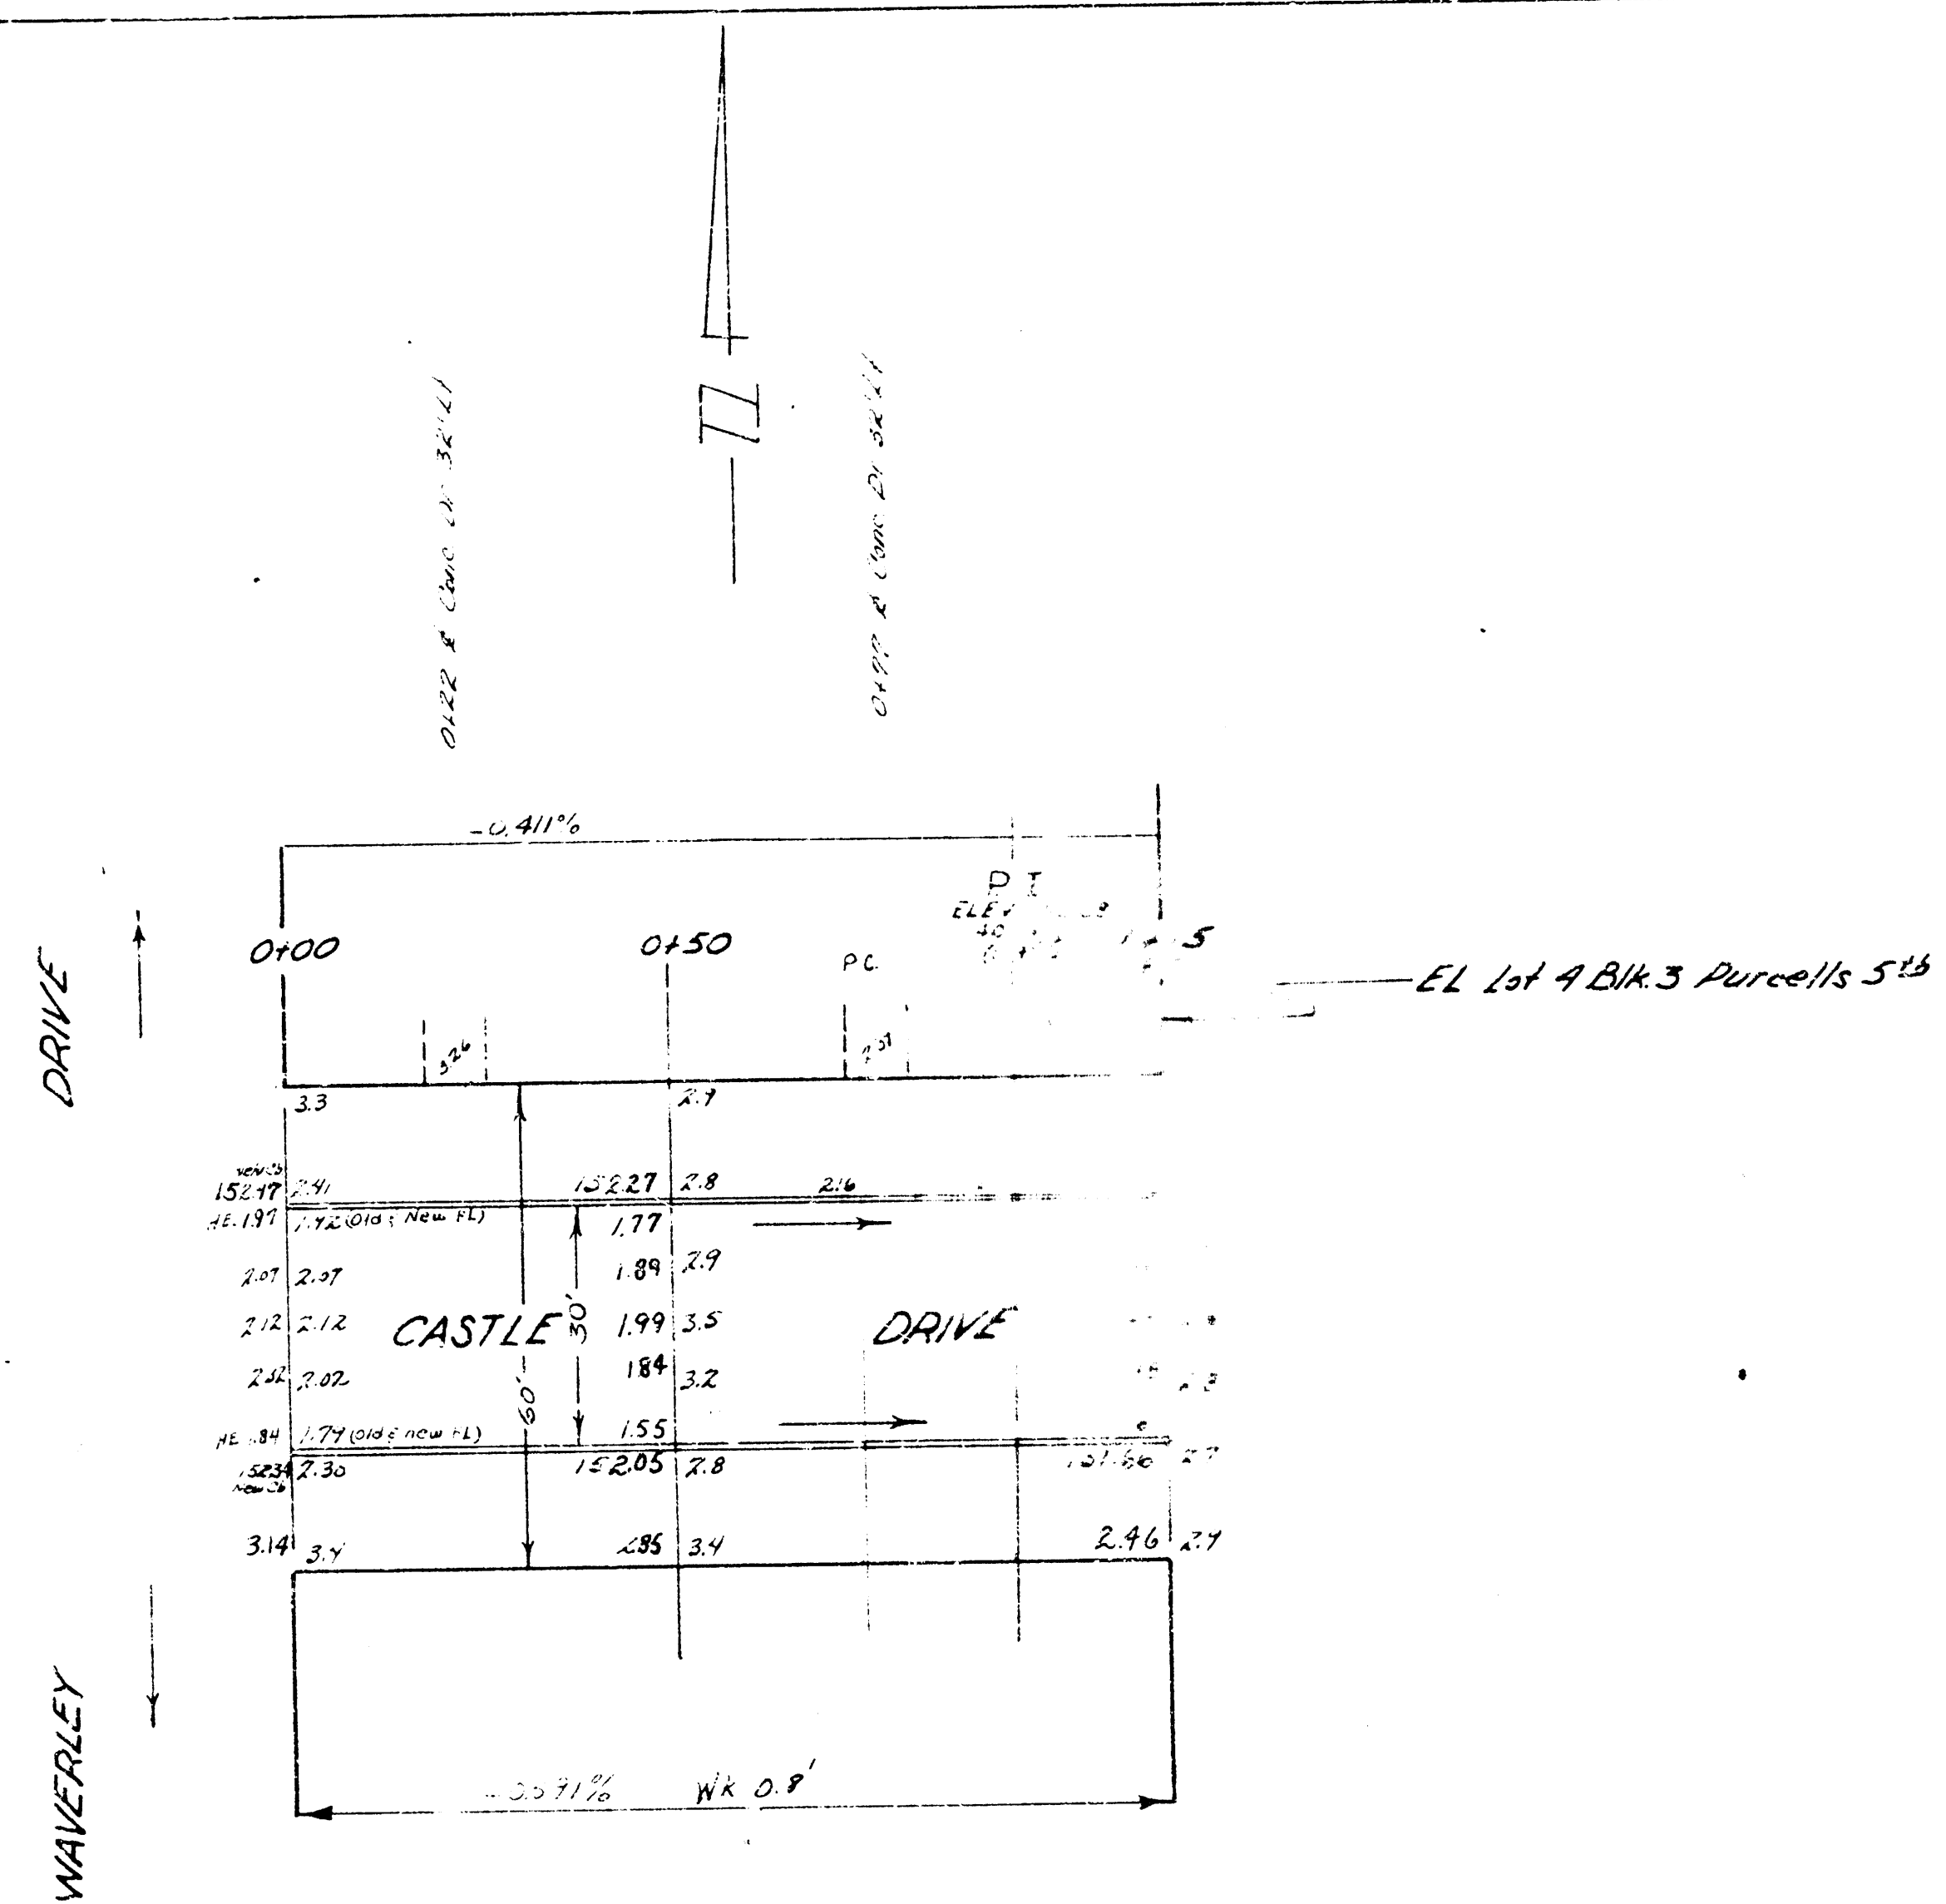

REVISED 3-29-52
 REVISED 3-17-52

CASTLE DRIVE
 EL Waverly - EL 114 Blk 3 Purcell's 5th
 30' Conc. & Cb.
 City of Wichita Kansas
 L. K. White City Engineer
 April, 1951 Proj. No. C11-48