



SCALE 1"=20'

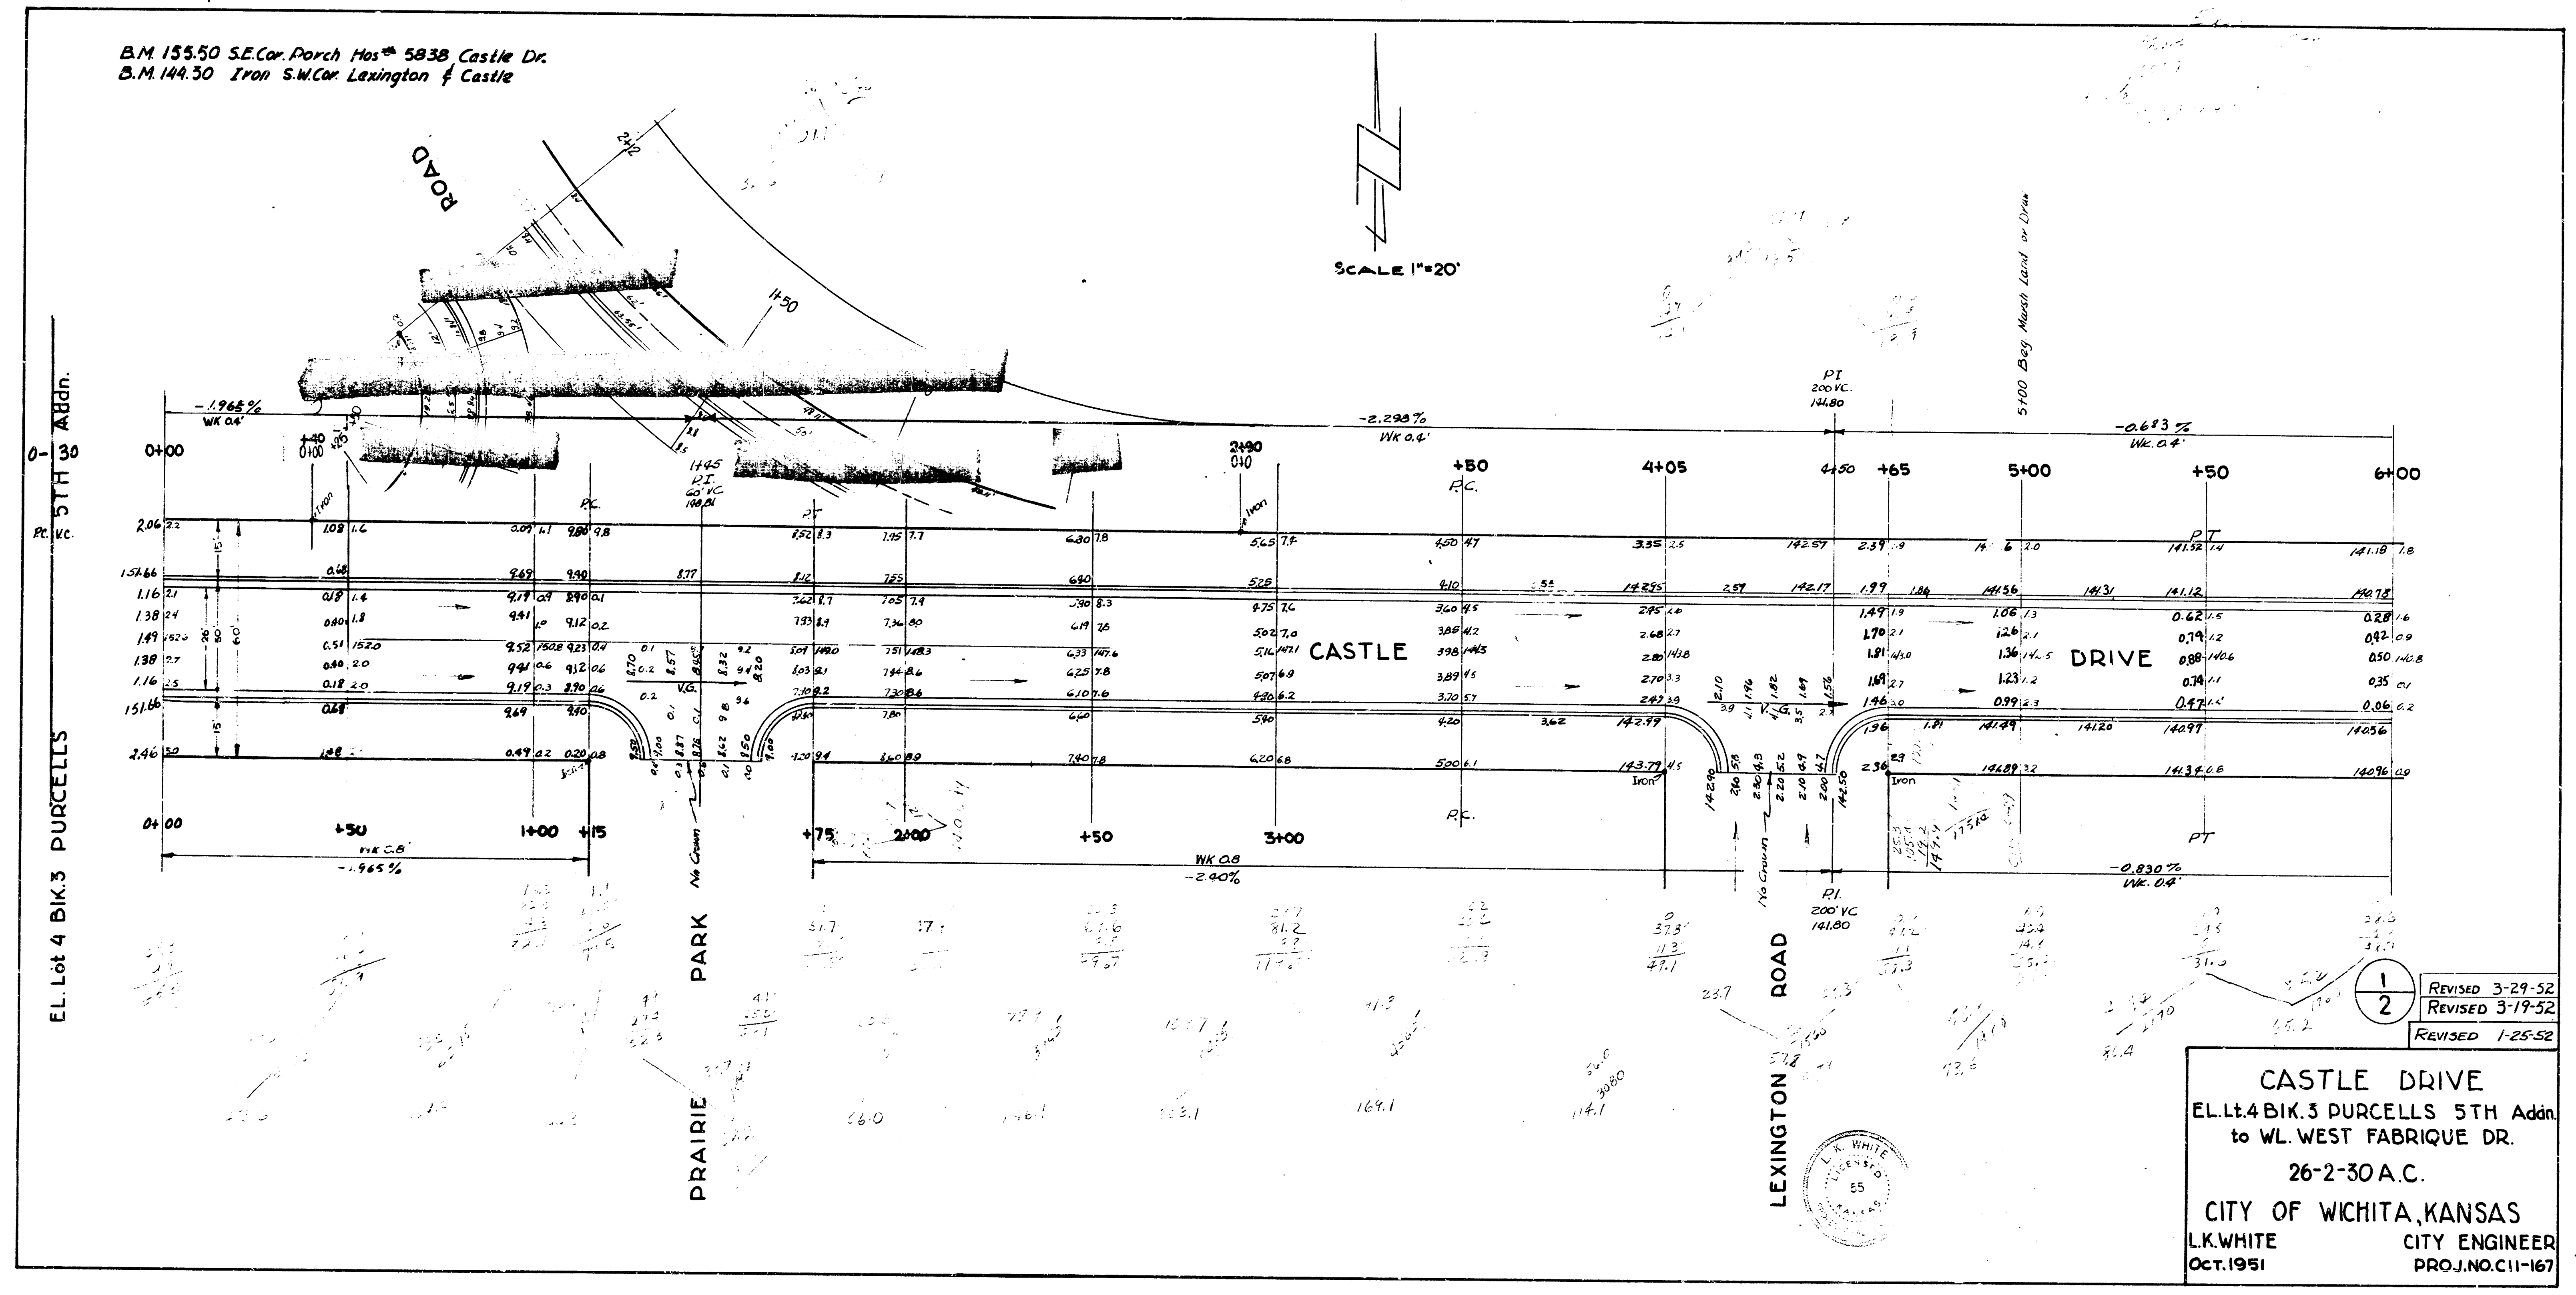

S-4

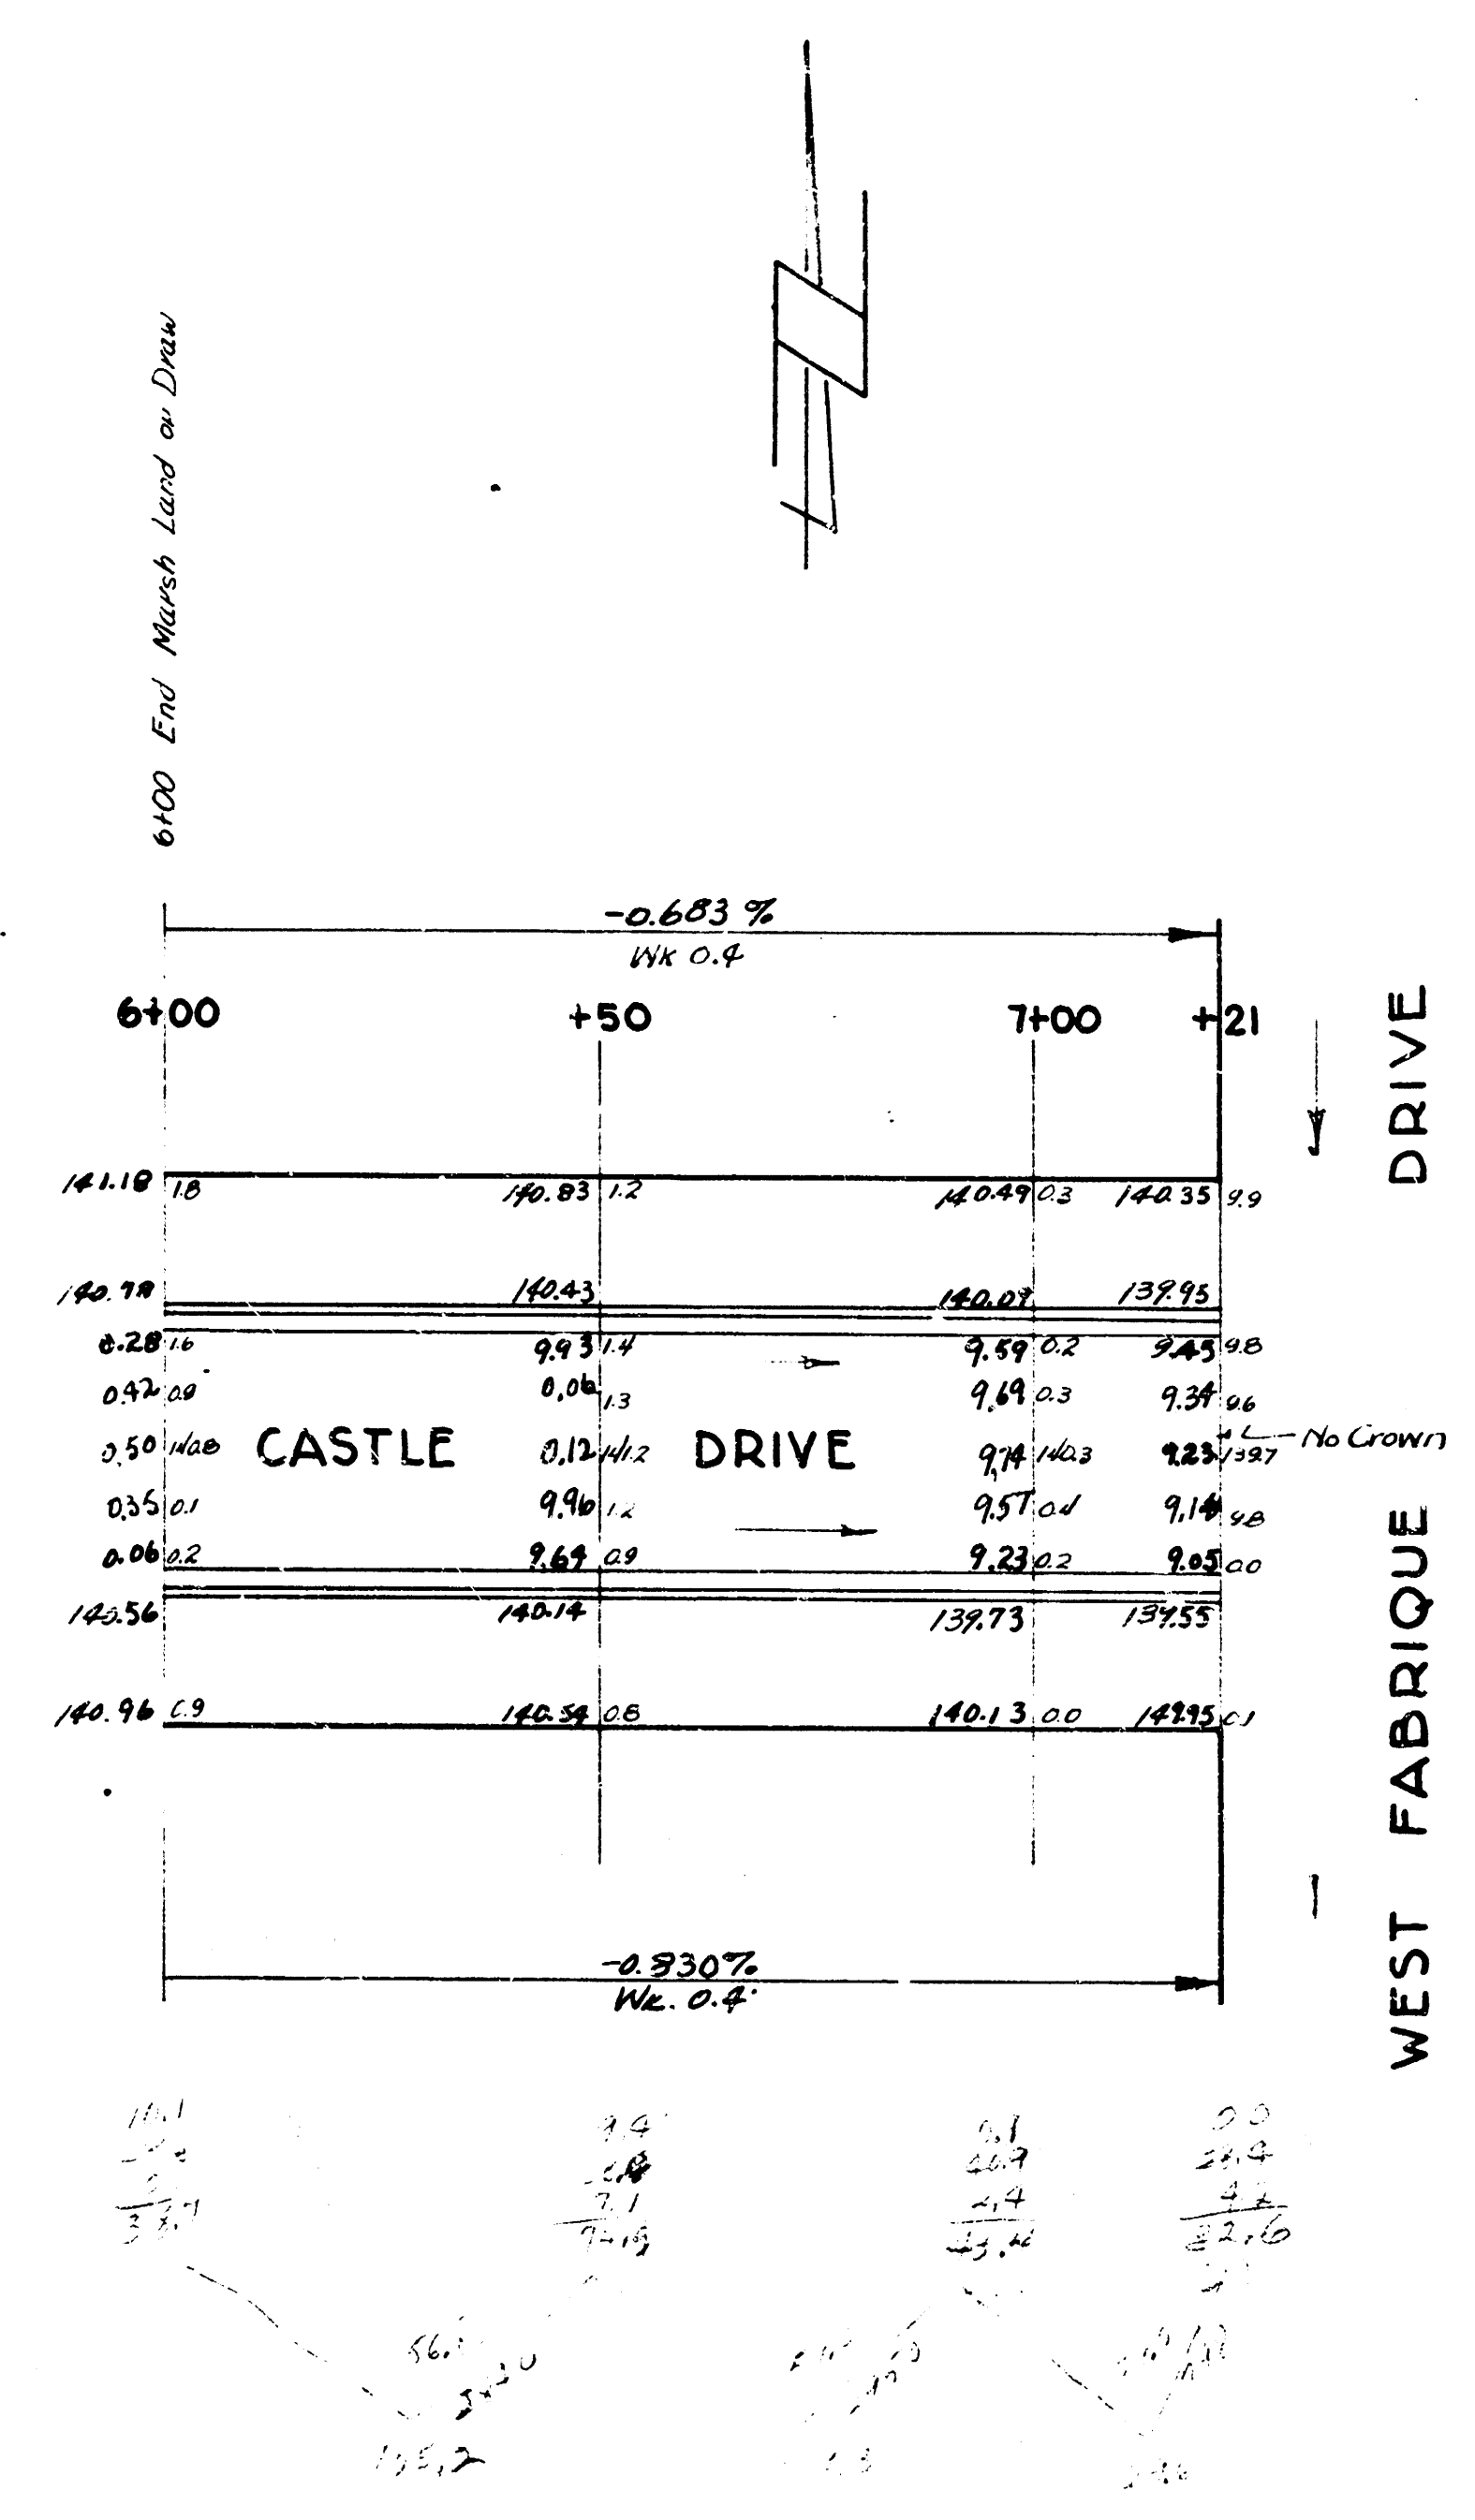

2
2

CASTLE DRIVE