


B.M. 199.76 SW corner concrete porch
House on S.E. corner Hirstead & Lamson.

NOTE: Contractor to clear R/W, grade parkings
and compact fill for proposed sidewalk.
Sidewalk to be constructed by others.

PROPERTY	
EXC.	COMP. FILL
952 Cu.Yds.	458 Cu.Yds.
+10' 95 "	46 "
Totals 1047 Cu.Yds.	504 Cu.Yds.

NOTE: Field Engineer to take
Sections prior to Construction.

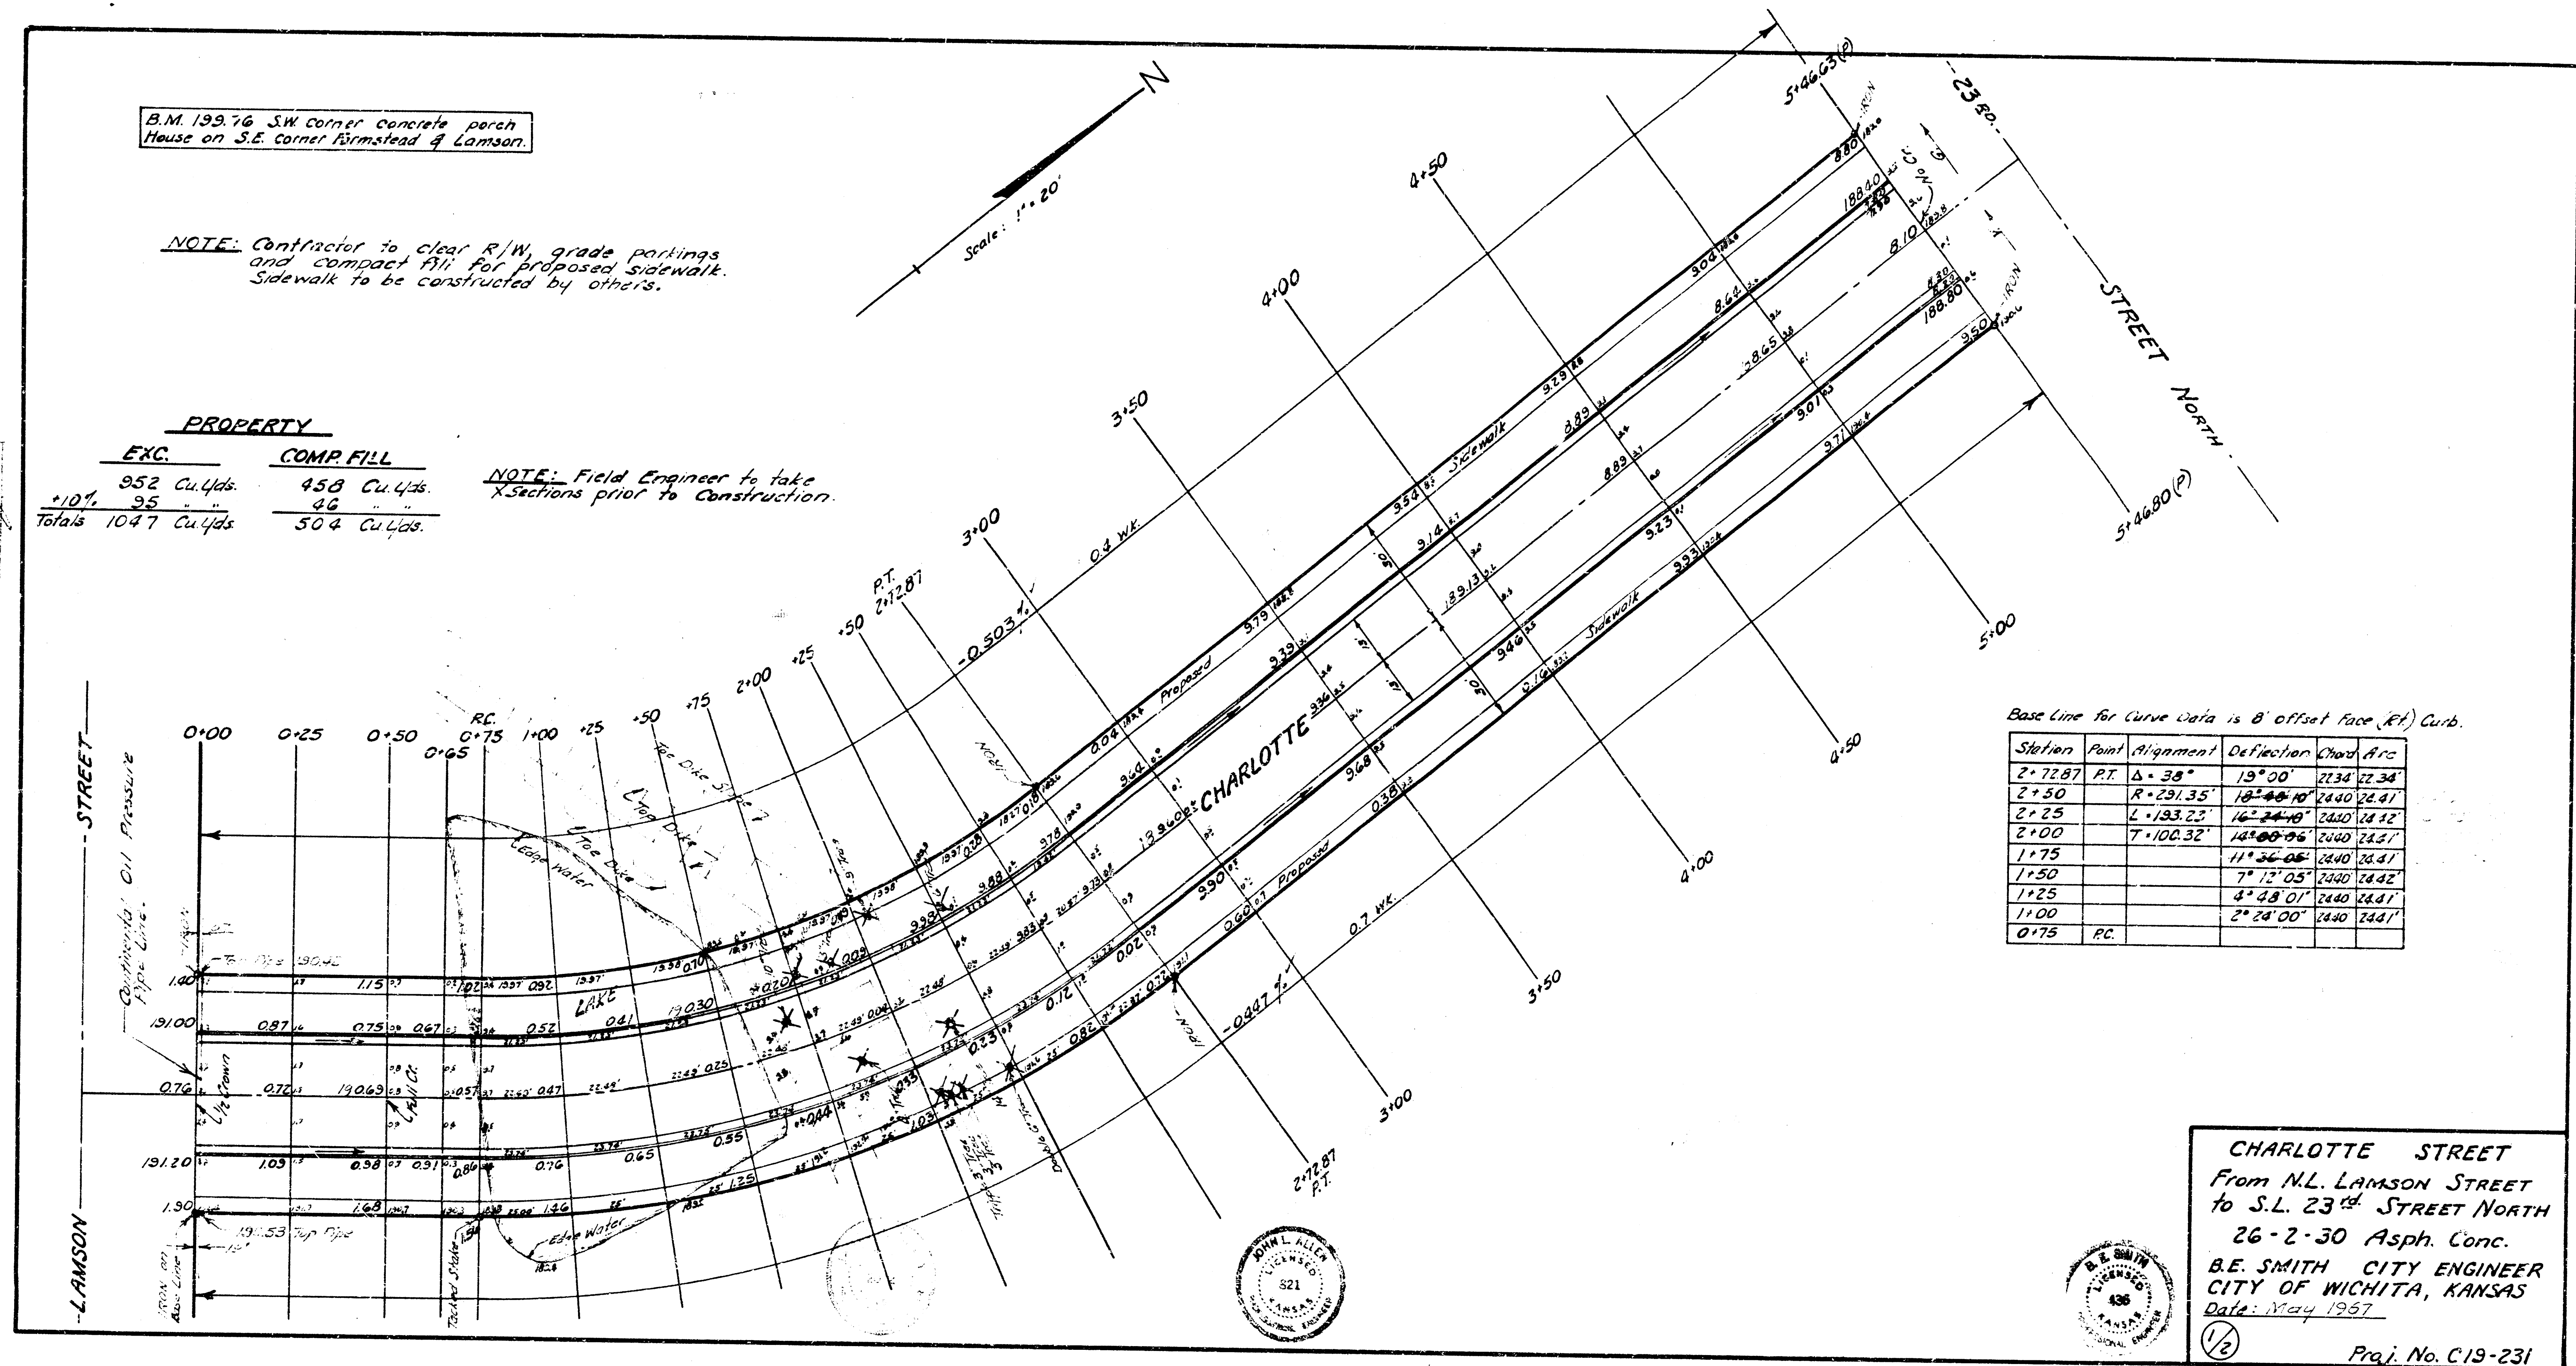

Base Line for Curve Data is 8' offset face (Rt) Curb.

Station	Point	Alignment	Deflection	Chord	Area
2+72.87	P.T.	$\Delta = 38^\circ$	$19^\circ 00'$	72.34	22.34
2+50		$R = 291.35'$	$18^\circ 44' 10''$	2440	24.41
2+25		$L = 183.23'$	$16^\circ 24' 10''$	2440	24.41
2+00		$T = 100.32'$	$14^\circ 00' 06''$	2440	24.41
1+75			$11^\circ 36' 06''$	2440	24.41
1+50			$7^\circ 12' 05''$	2440	24.42
1+25			$4^\circ 48' 01''$	2440	24.41
1+00			$2^\circ 24' 00''$	2440	24.41
0+75	P.C.				

CHARLOTTE STREET
From N.L. LAMSON STREET
to S.L. 23rd STREET NORTH
26'-2'-30" Asph. Conc.

B.E. SMITH CITY ENGINEER
CITY OF WICHITA, KANSAS
Date: May 1957

1/2

Proj. No. C19-231