


BK-CHM 65

BM. 154.50 "6" in Globe E. ch. Erie, SL. 21st
 BM. 146.45 "9" in 1942 E. ch. Chautauque, NL Shadybrook.
 BM. 151.72 NE. cor. conc. porch No. 2127 N. Chautauque.

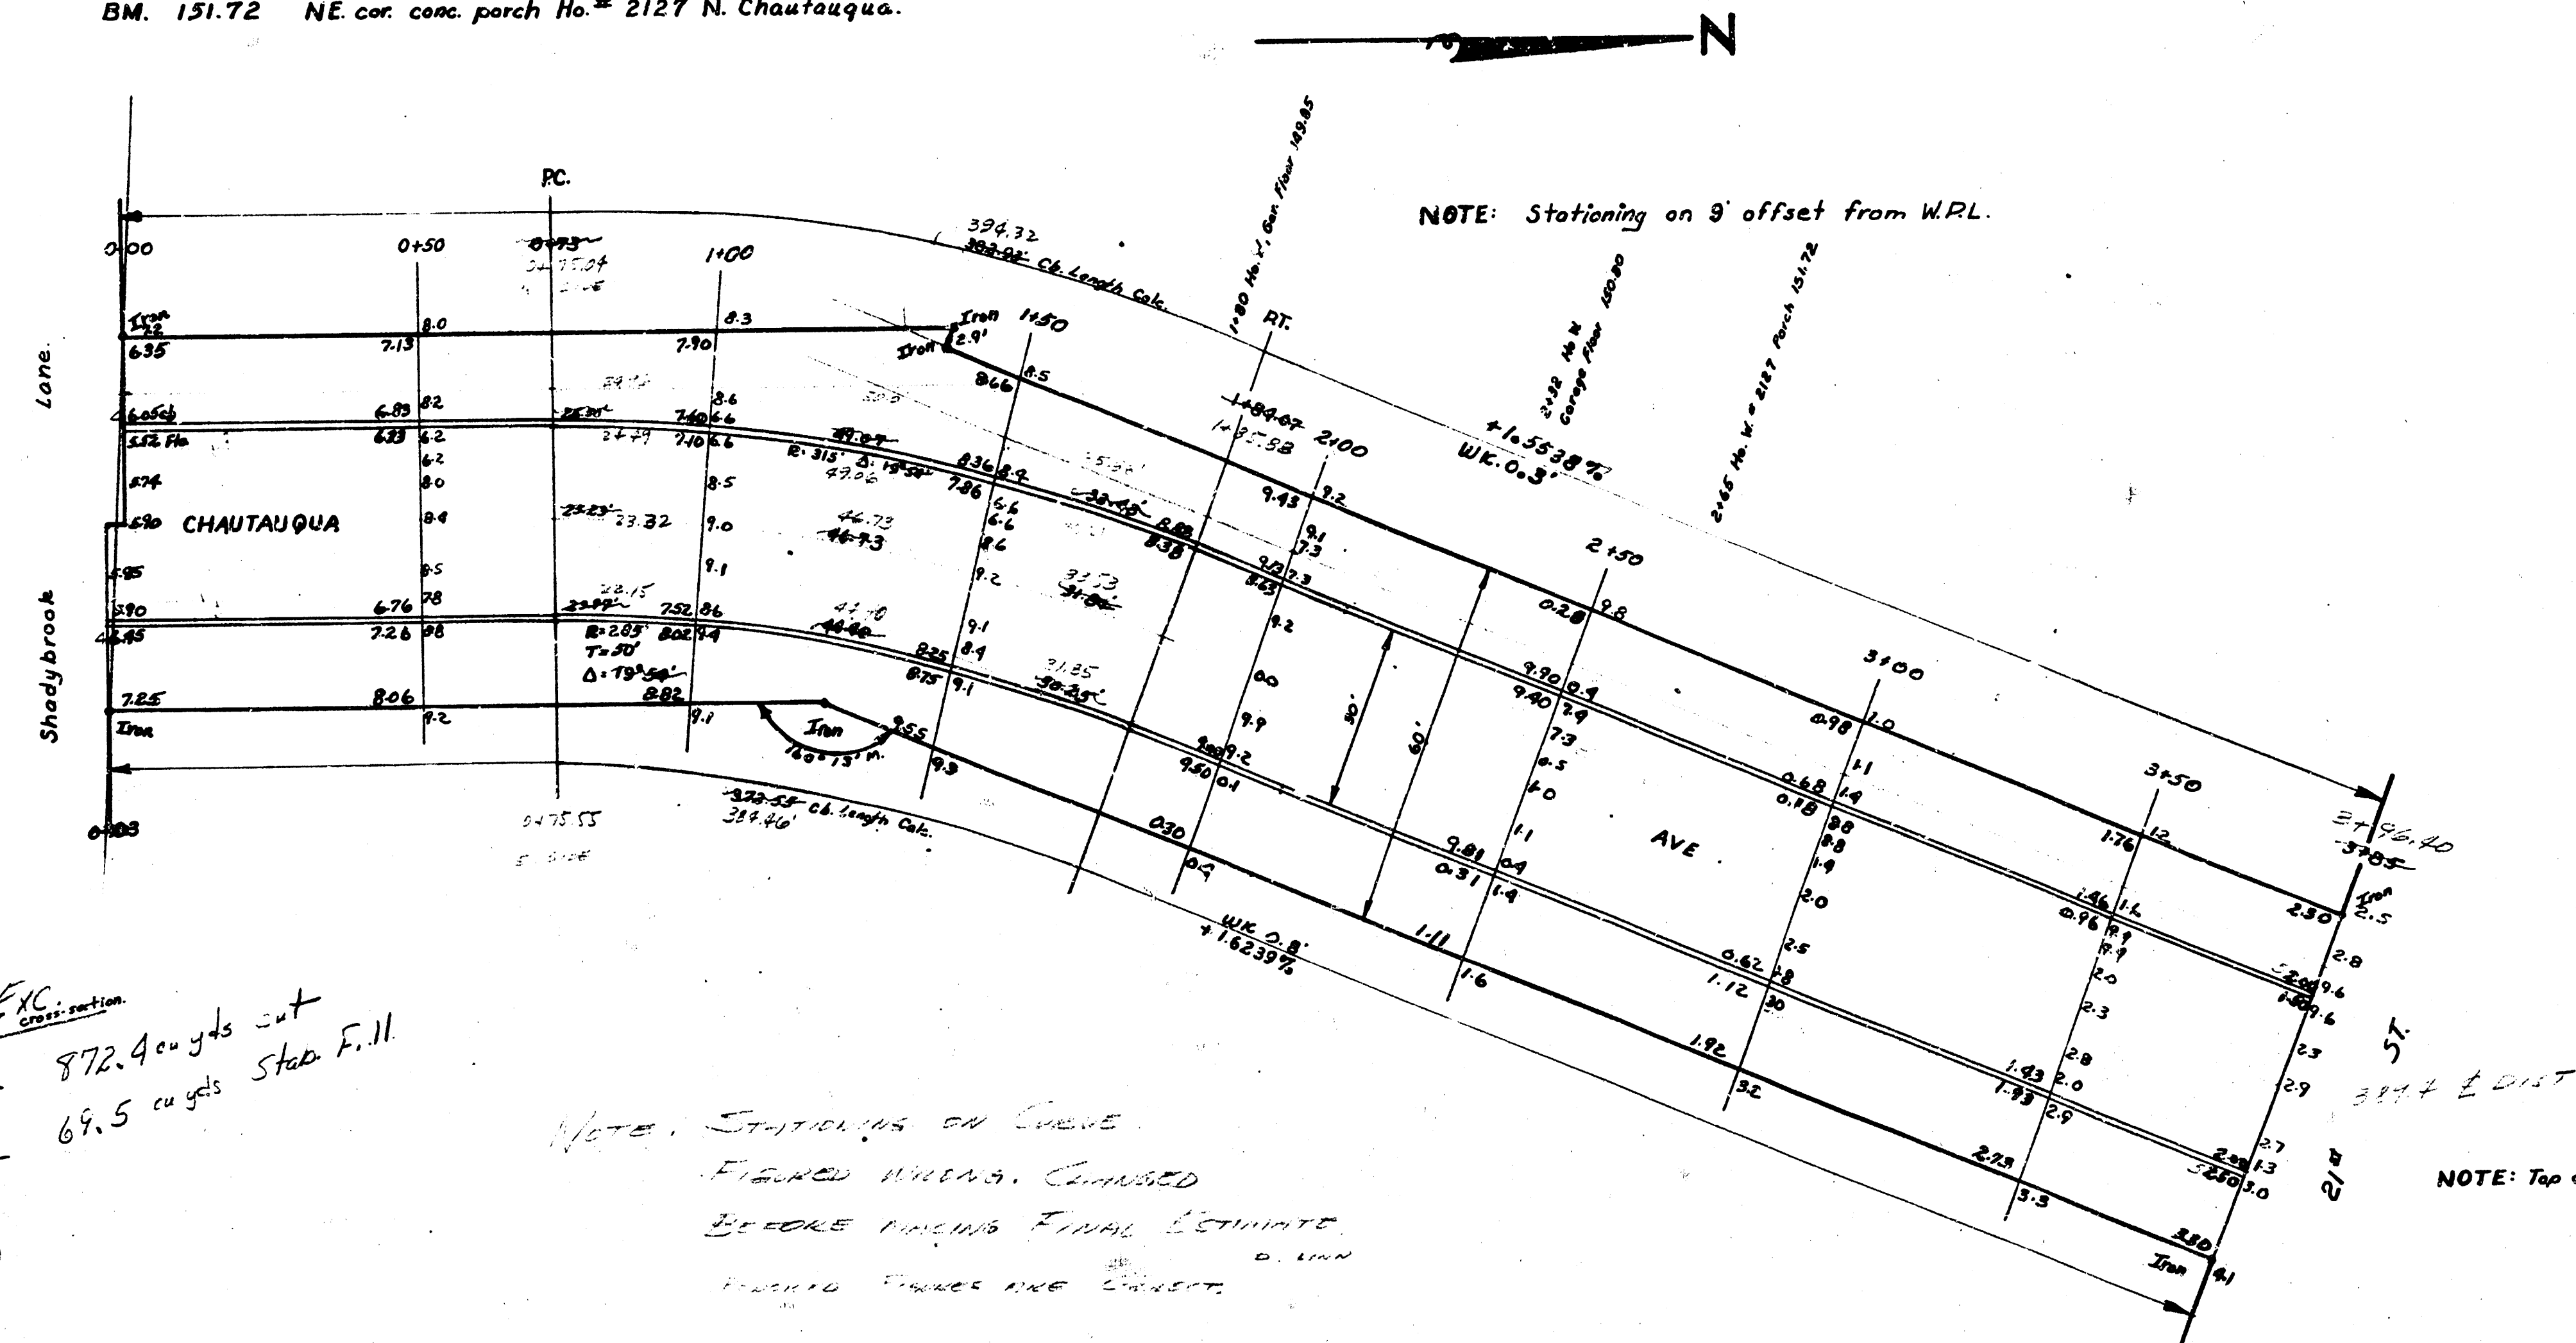

Total Exc. cut
 Property - 872.4 cu yds cut
 - 69.5 cu yds State Fill

City - 0

NOTE: STATIONING ON CURVE
 FIGURED MEANS. CHANGED
 BEFORE MAKING FINAL ESTIMATE
 PLACING PAVES ARE SHOWN

NOTE: Top of 3" Gas line (E & W) 151.20 - 8' N. of SL. 21st St.

Chautauque Ave.
 NL Shadybrook Lane to SL. 21st St
 30' Conc. & Ch
 City of Wichita, Kansas
 L. K. White City Engineer
 October 1950 Proj No. C10-113

146