
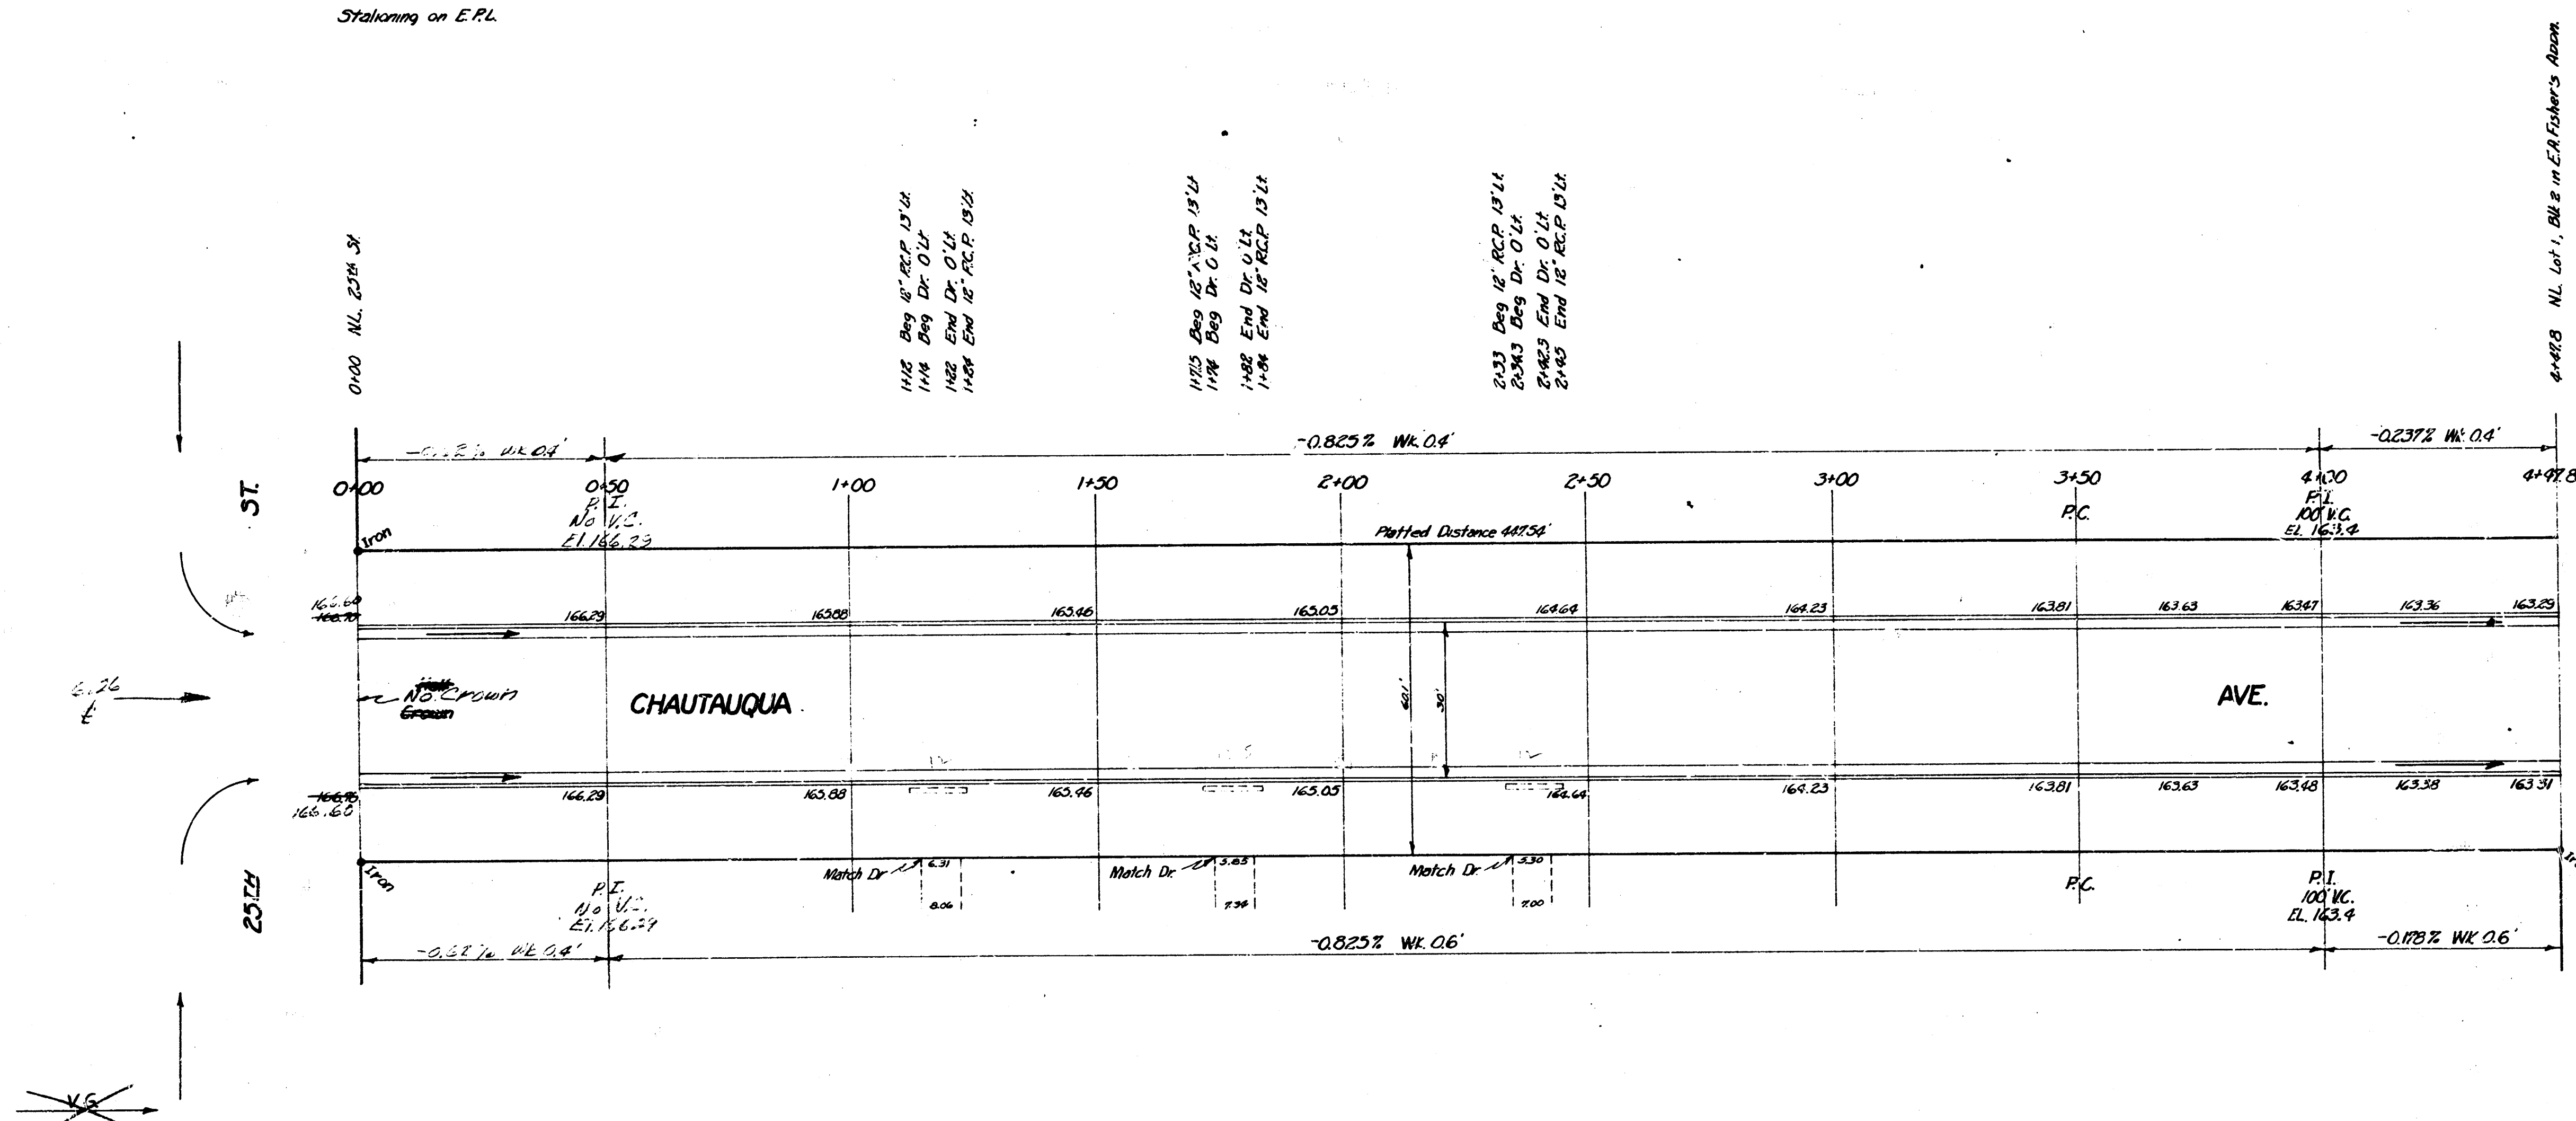



B.M. 174.71 *120 Spike N.S. P.P. 18' W. & 15' S. of N.E. cor. 25th & Lorraine
 B.M. 167.39 "G" in Globe center of pushblock, W.N. 3' W. cor. 25th & Lorraine
 B.M. 168.38 3' W. cor. conc. porch No. 2620 N. Chautauqua
 Stationing on E.P.L.

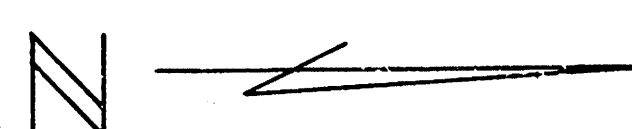

NOTE
 FIELD ENGINEER & CONTRACTOR: All entrance pipes are to be
 disposed of in accordance with dirt checker's instructions.



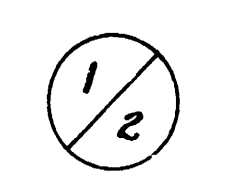

CHAUTAUQUA AVE.
 N.L. 25th to N.L. Lot 1, Blk 2
 in E.A. FISHER'S ADDN.
 26-2-30 A.C.
 CITY OF WICHITA, KANSAS
 B.E. SMITH CITY ENGINEER
 MARCH, 1934 Proj. No. C13-218