


SURNAME A. E. 1915 BX AR-1
 5-12-59
 5-13-59

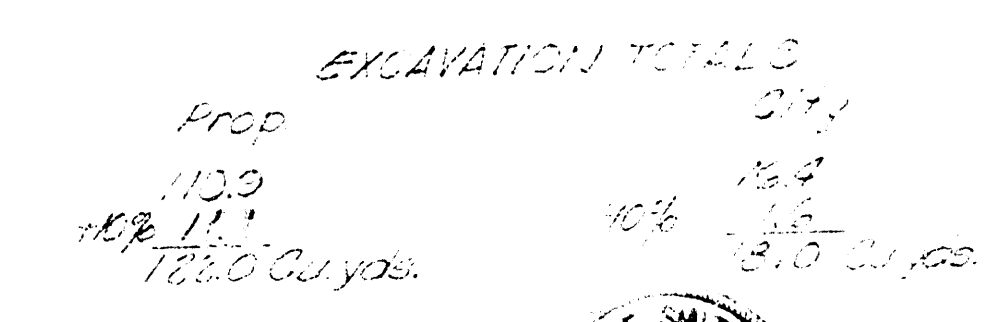

CLARK STREET
EL. KING MICHAELSON'S 3RD - EL. WICTORIA
26'-2'-30" ASPH. CONC.
CITY OF WICHITA, KANS.
B.E. SMITH CITY ENGINEER
DATE: June 1, '59 PROJECT NO. C19-70

