


B.M. 143.48 N.E. COR. BOTTOM CONC. STEP No. 827 W. ARMOUR DR.
 B.M. 144.97 N.E. COR. BOTTOM CONC. STEP No. 745 W. ARMOUR DR.
 B.M. 156.20 1/2" Sph. SS. H.P. 23" N. of N.E. CLAY 129° E. of W.L. ROCK ROAD.
 B.M. 150.69 1/2" Sph. SS. H.P. 100° N. of N.E. CLAY 129° E. of W.L. ROCK ROAD.


Sta. On 98' Offset From S.E.



CURVE DATA
 R = 448.72 6° 56' 30"

Sta.	Chord	Chord	Dist.	Dist.
0+00	PC			
0+25	25.00	22.65	1°35'46"	1°35'46"
0+50	25.00	22.65	1°35'46"	3°11'32"
0+75	25.00	22.65	1°35'46"	4°47'18"
1+00	25.00	22.65	1°35'46"	6°23'04"
1+25	25.00	22.65	1°35'46"	7°58'50"
1+32.68	7.68	6.96	0°27'25"	8°26'15"

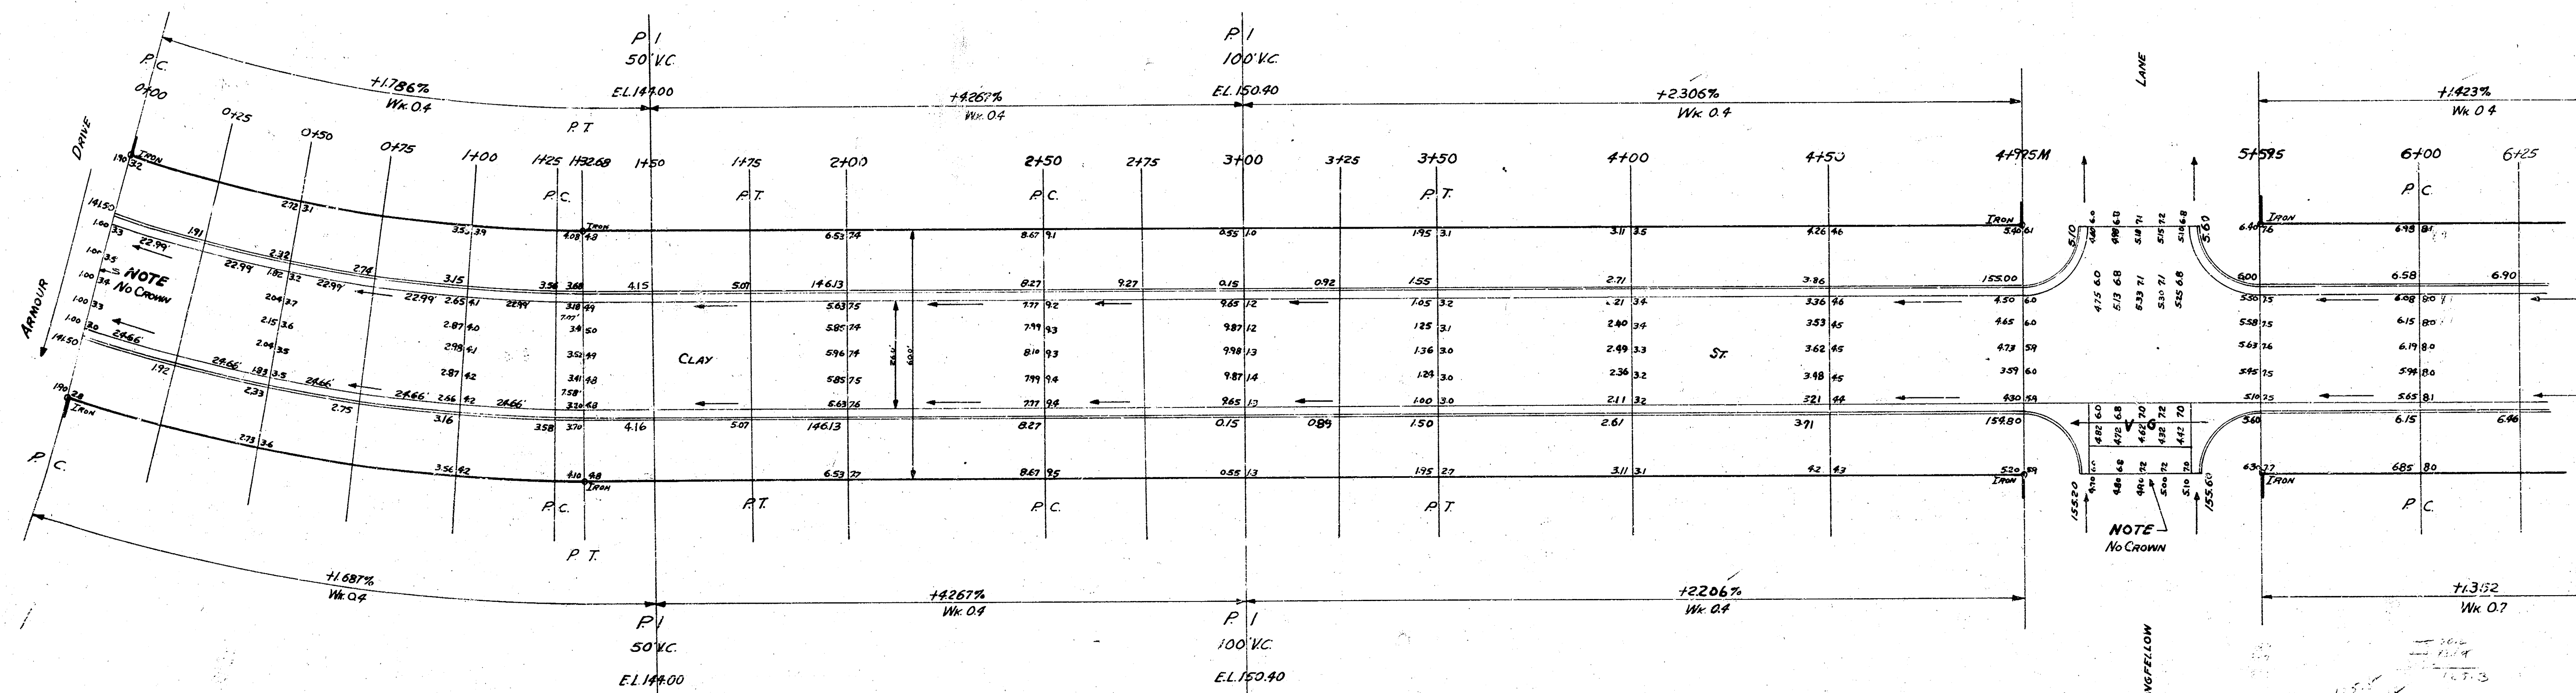


CLAY STREET
 EL. ARMOUR DR To W.L. ROCK ROAD
 26-2-30 A.C.
 CITY OF WICHITA, KANSAS
 B.E. SMITH
 1953
 CIVIL ENGINEER
 PROJ. No. C18-164

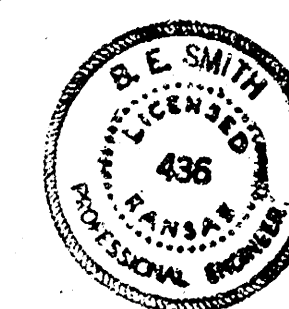

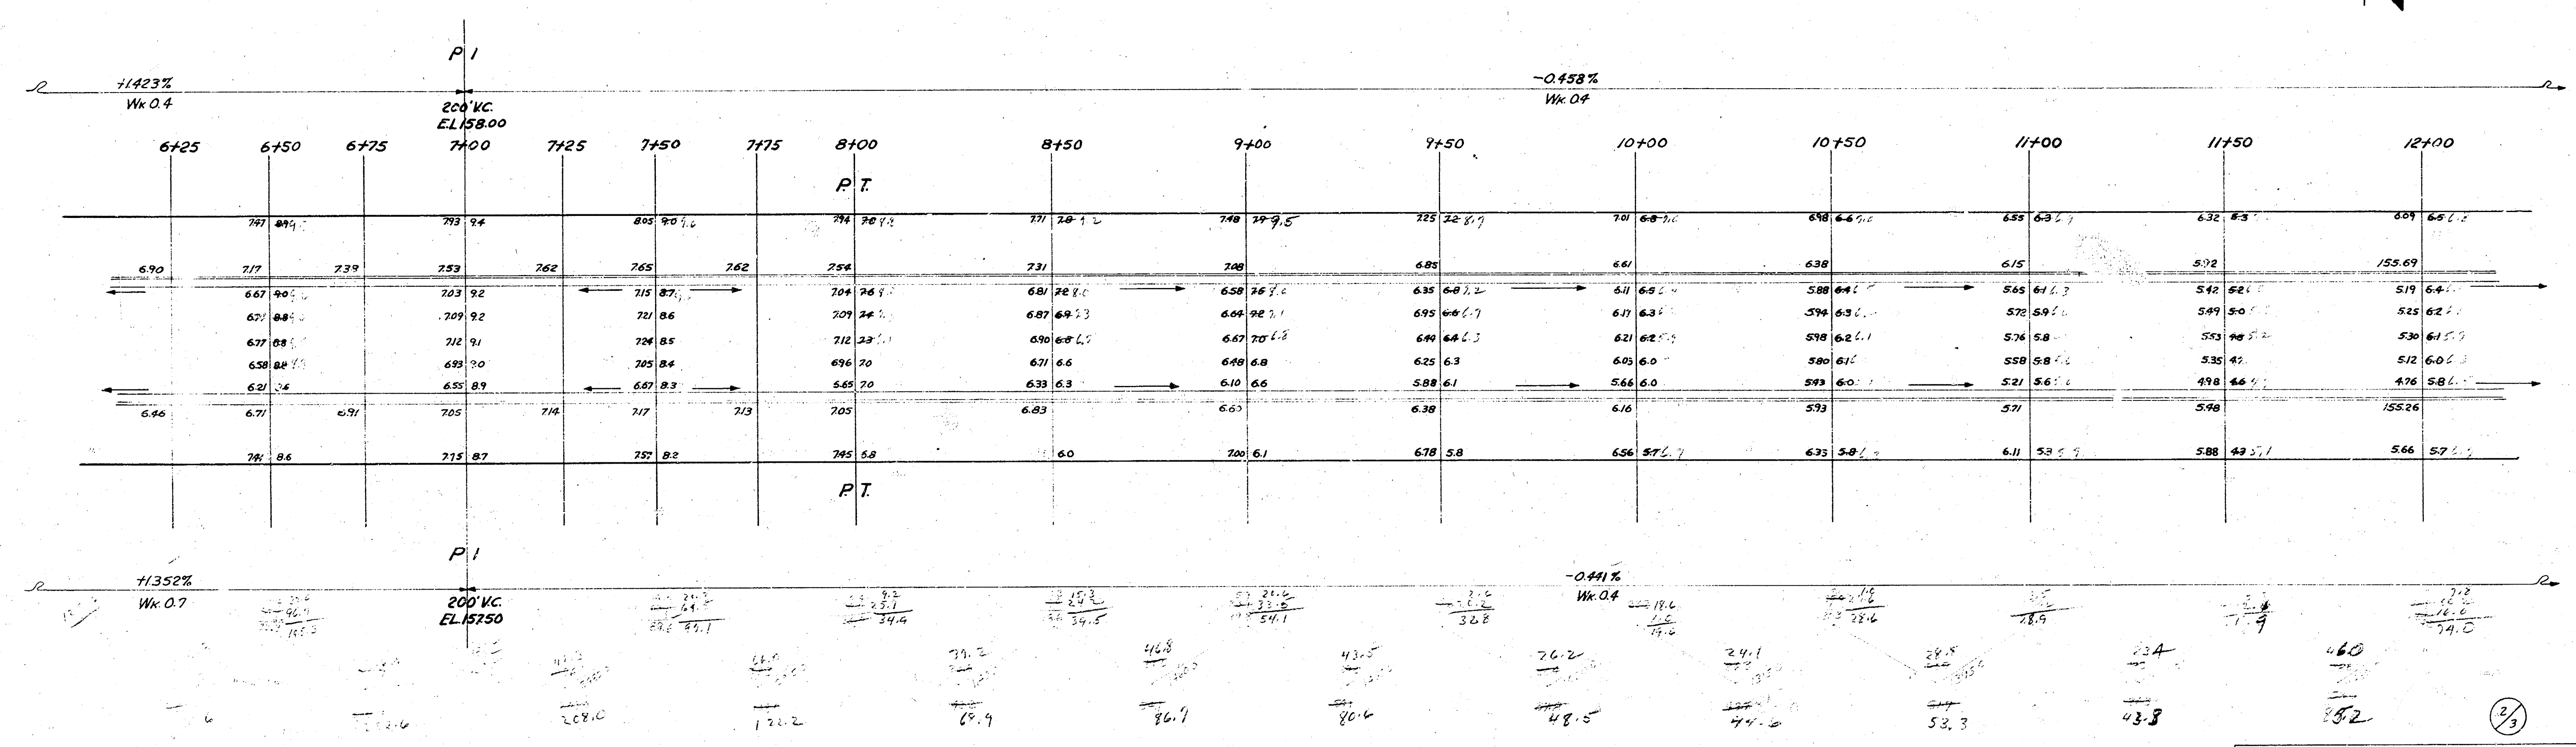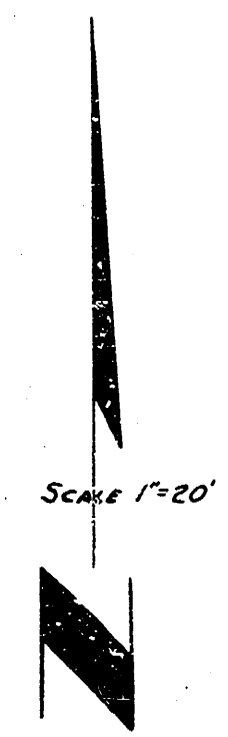

CLAY ST
Proj. No. C14-164

BM 15620 1/2" Spw S.S.H.L.P. 23° N. of N.E. Clay 129° E. of W.E. Rock Road.
 BM 15069 1/2" Spw S.S.H.L.P. 100° N. of N.E. Watson Lane, 128° E. of W.E. Rock Road.
 Sta on 9' Offset from S.R.

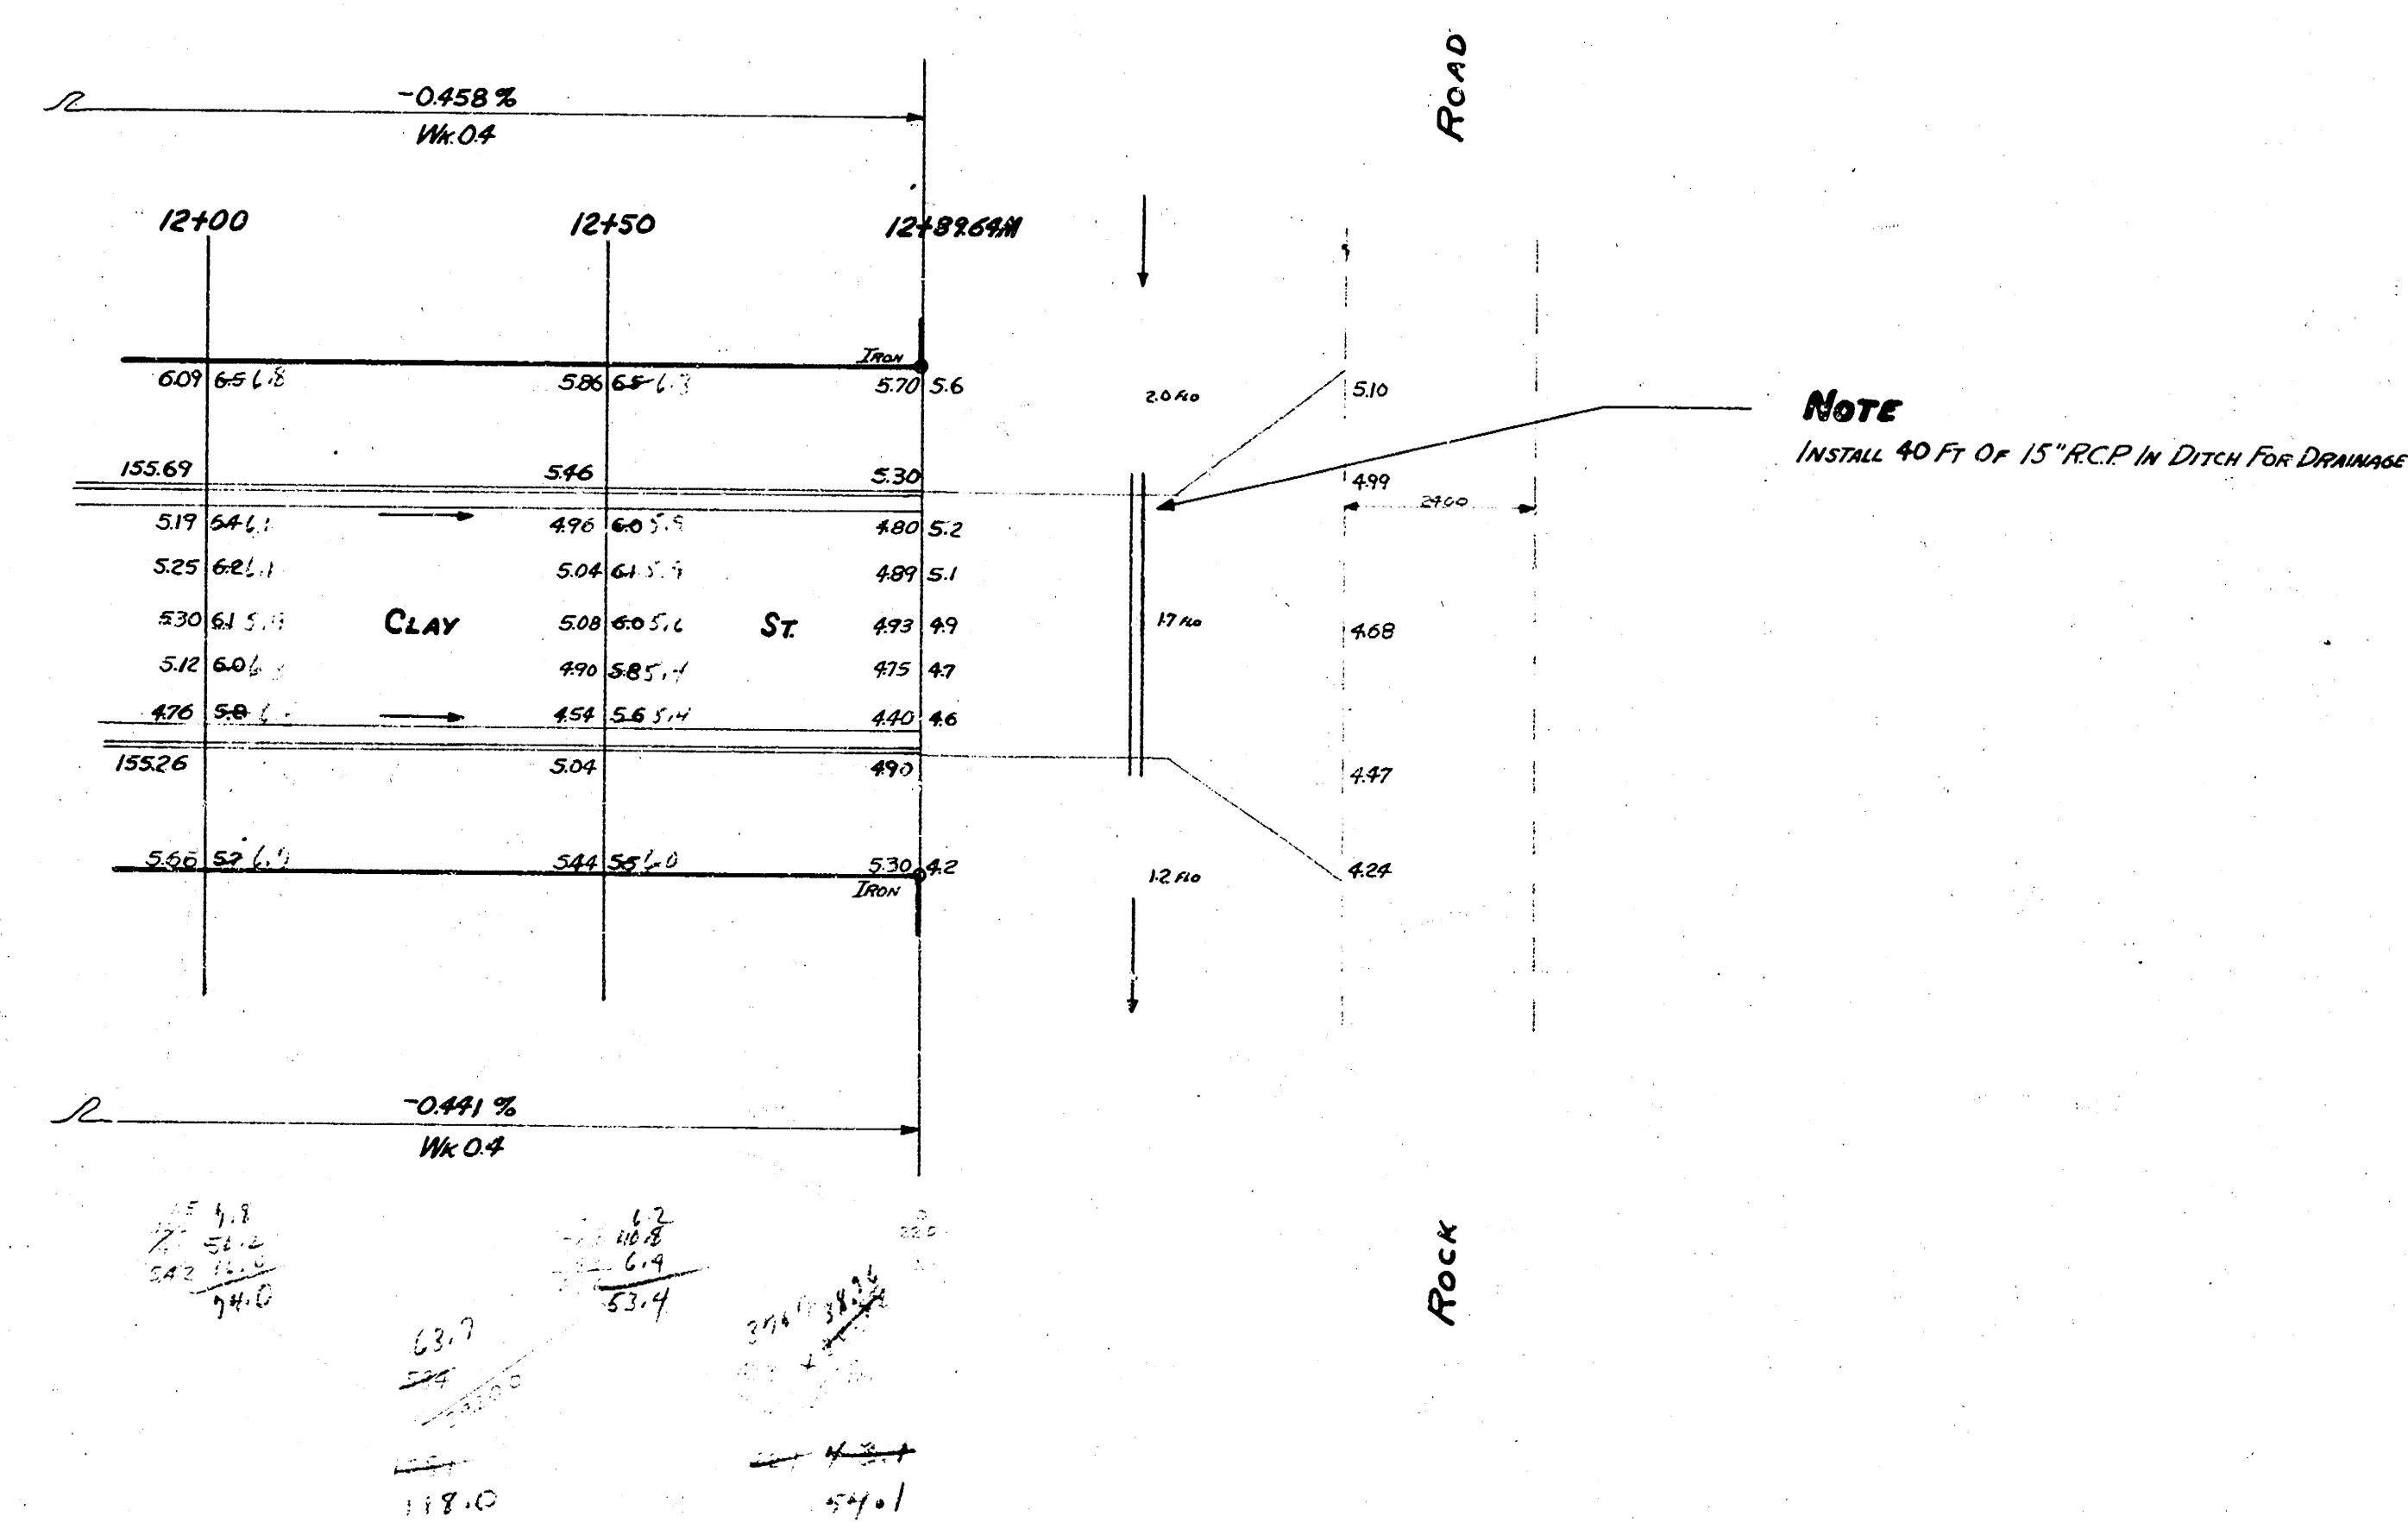

CLAY ST.
 PROJ. No. C 14-164