




Scale 1" = 20'
 BM 14413 50' cur. concrete Drive to Garage South of House 1314 Clifton
 5' x 12' x 14" 50' cur. on fringe, fire hydrant NE cur. Clifton and Dunham
 Roseville - east property line Clifton

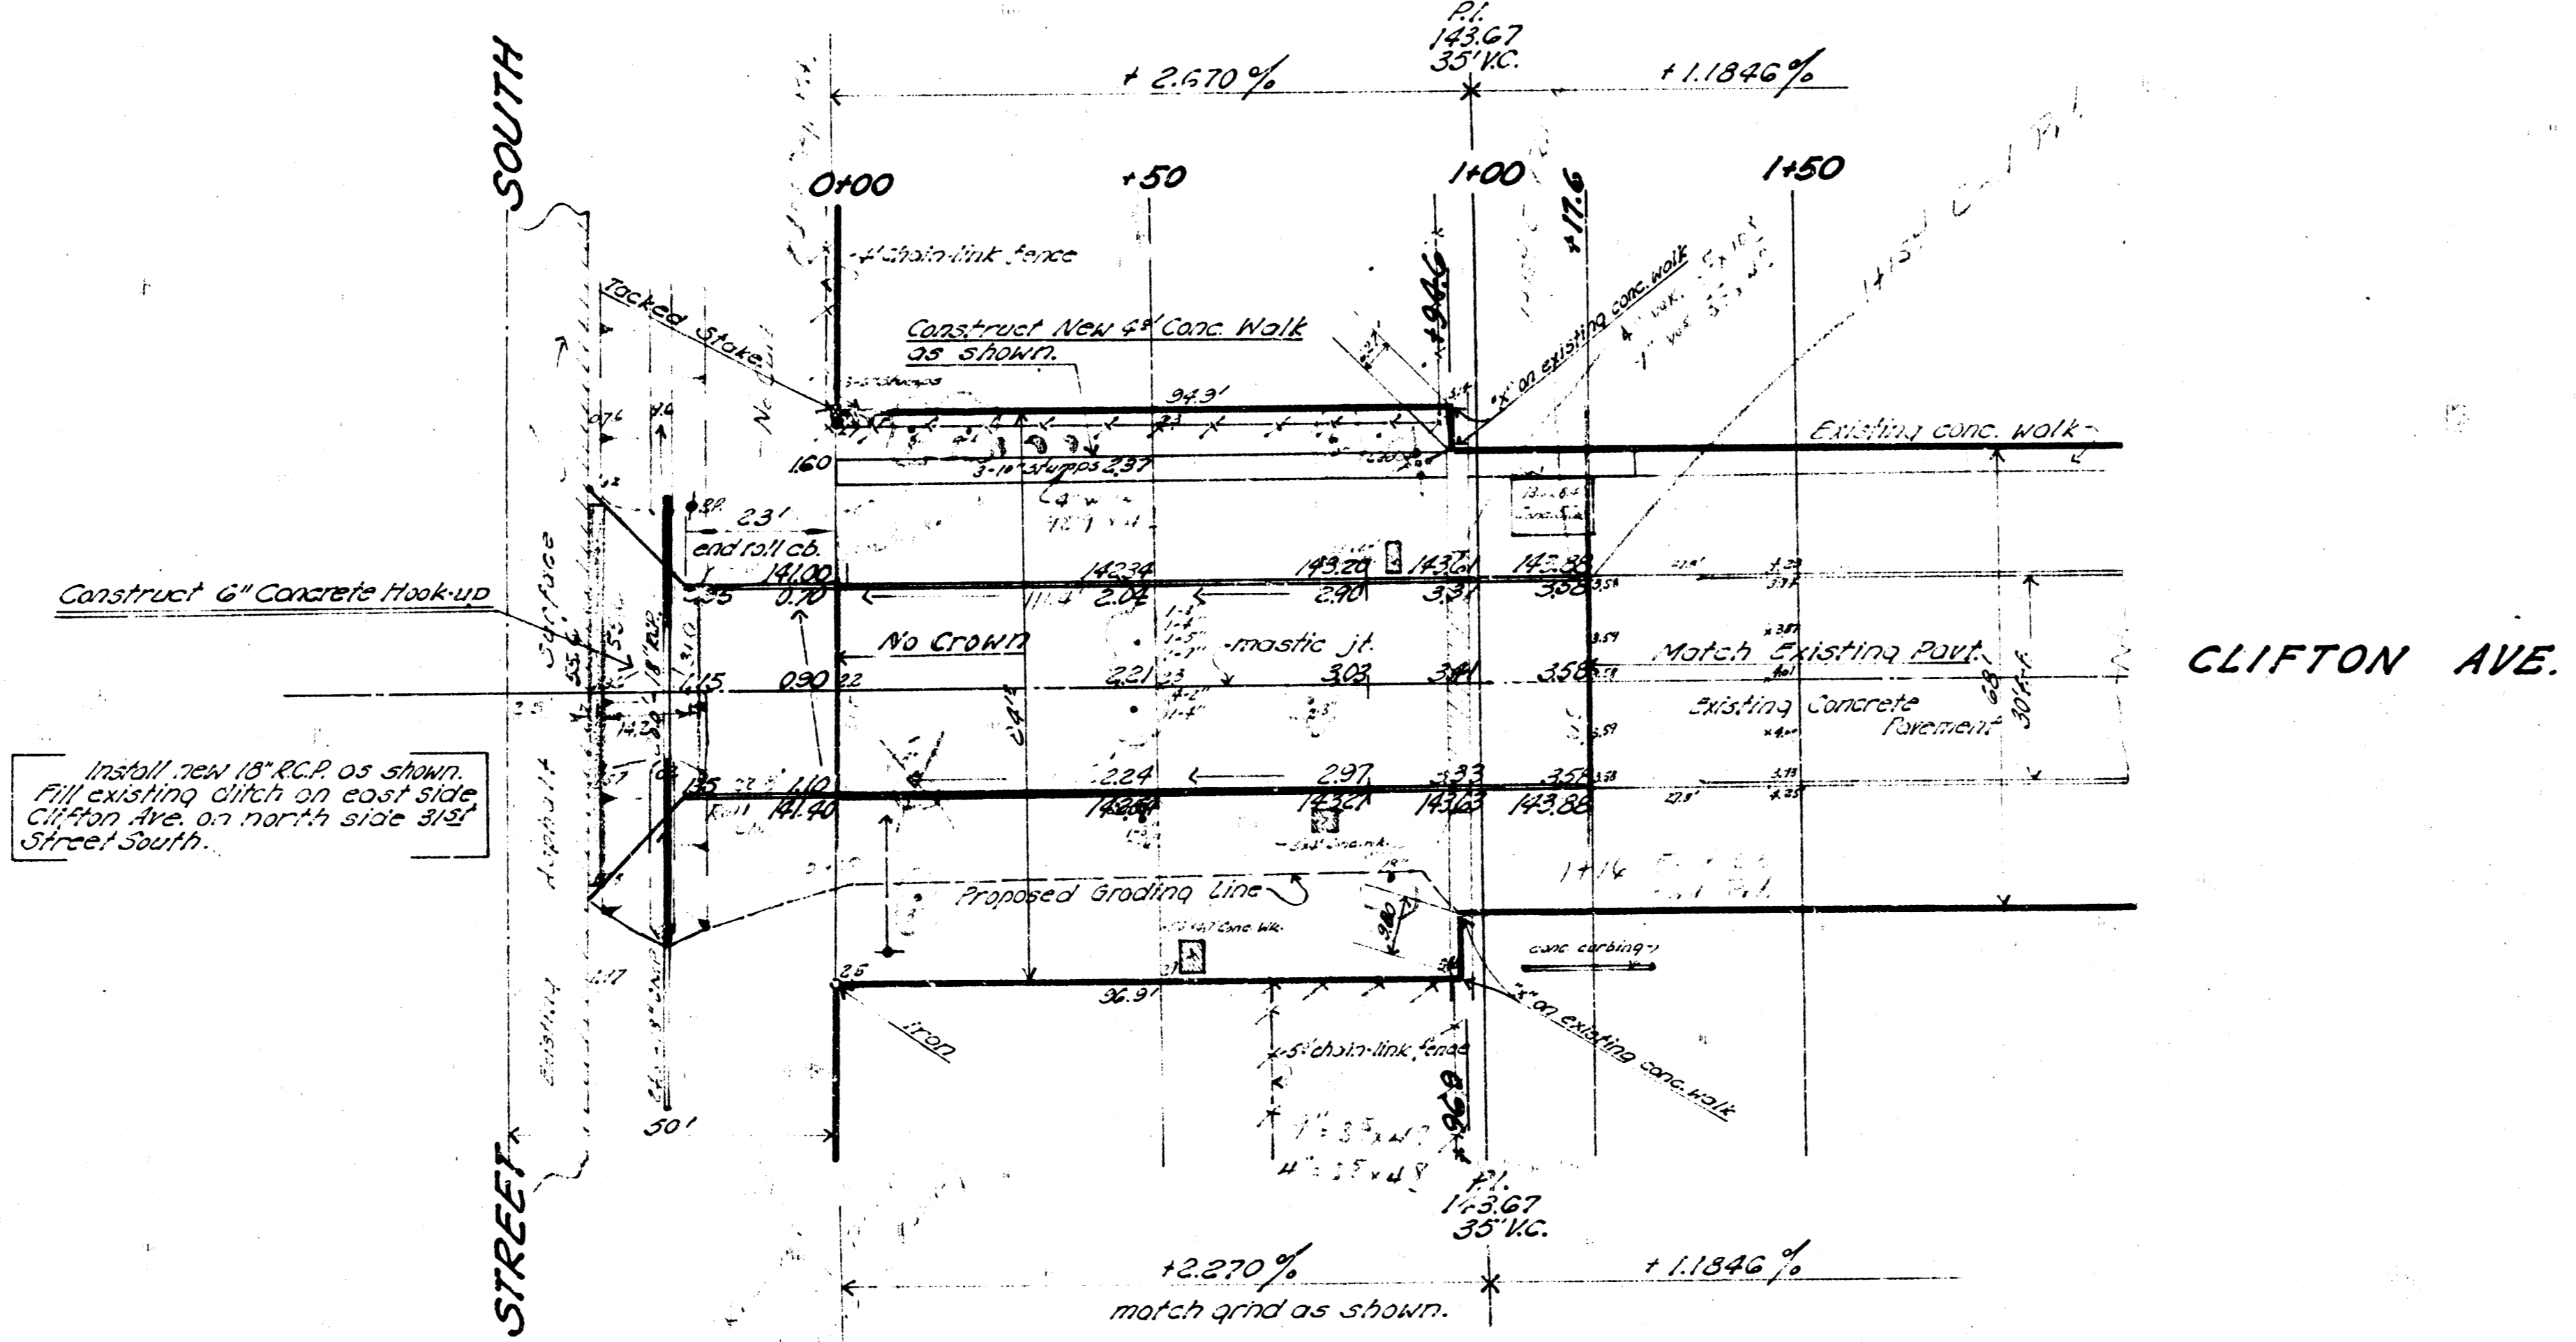


Install new 18" RCP as shown
 fill existing ditch on east side
 Clifton Ave. on north side 31st
 Street South.

Note - This project to have Roll-type int.
 (reinfor. curb) constructed
 throughout.

Earthwork Quantities		Compacted Fill	
Description	cu.	Description	cu.
+12.270%	58	0	50
743.6 cu.	1,531 (11%)	0	33 cu.
	643 cu.		

CLIFTON AVENUE
 NE 31st St. Co. To 1167' - Eo. of NE 31st St. Co.
 30' Concrete and Curb (Roll)
 City of Wichita, Kansas
 B.E. Smith City Engineer
 Date - JULY 1964 Proj. No. - 716-40

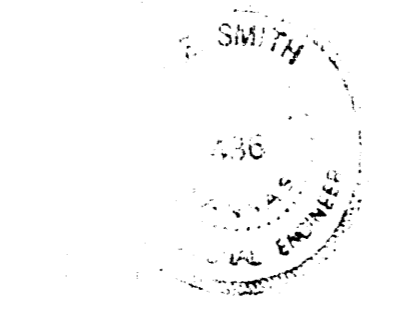

Sheet 1 of (2)