ELM AVE.

E.L. POPLAR to W.L. GREEN
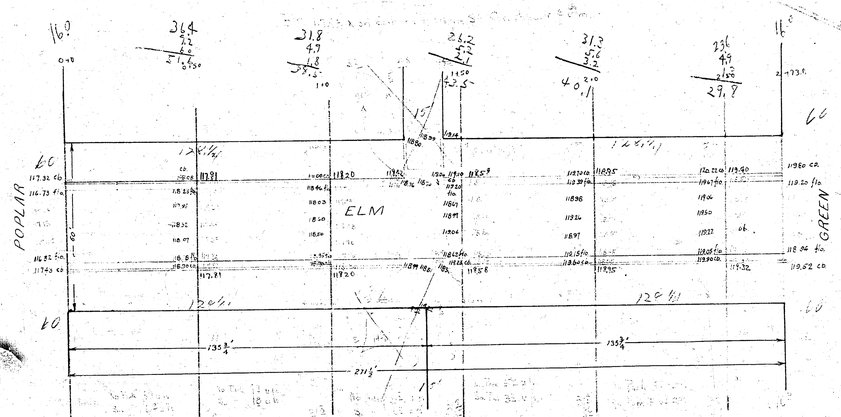
26-2-30 Com.