1941
ELM - GLENDALE to PAV BET. GLENDALE & HARDING
20' CONC.

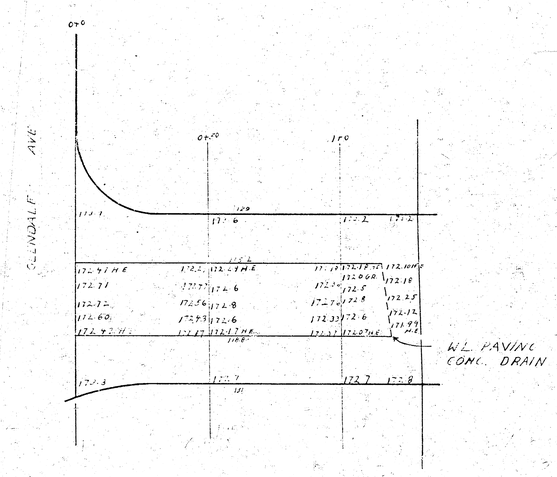

BM 174.04 W-IN WPA N CB ELM 5' W OF W.L. HARDING
BM 172.49 E IN ELTING W.S. DRIVE S CB ELM @ E.S. CONC. DRAIN