


Back 274

B.M. 115.35 "F" in Feb. top of Hyd. N.W. Cor. Elm & St. Francis

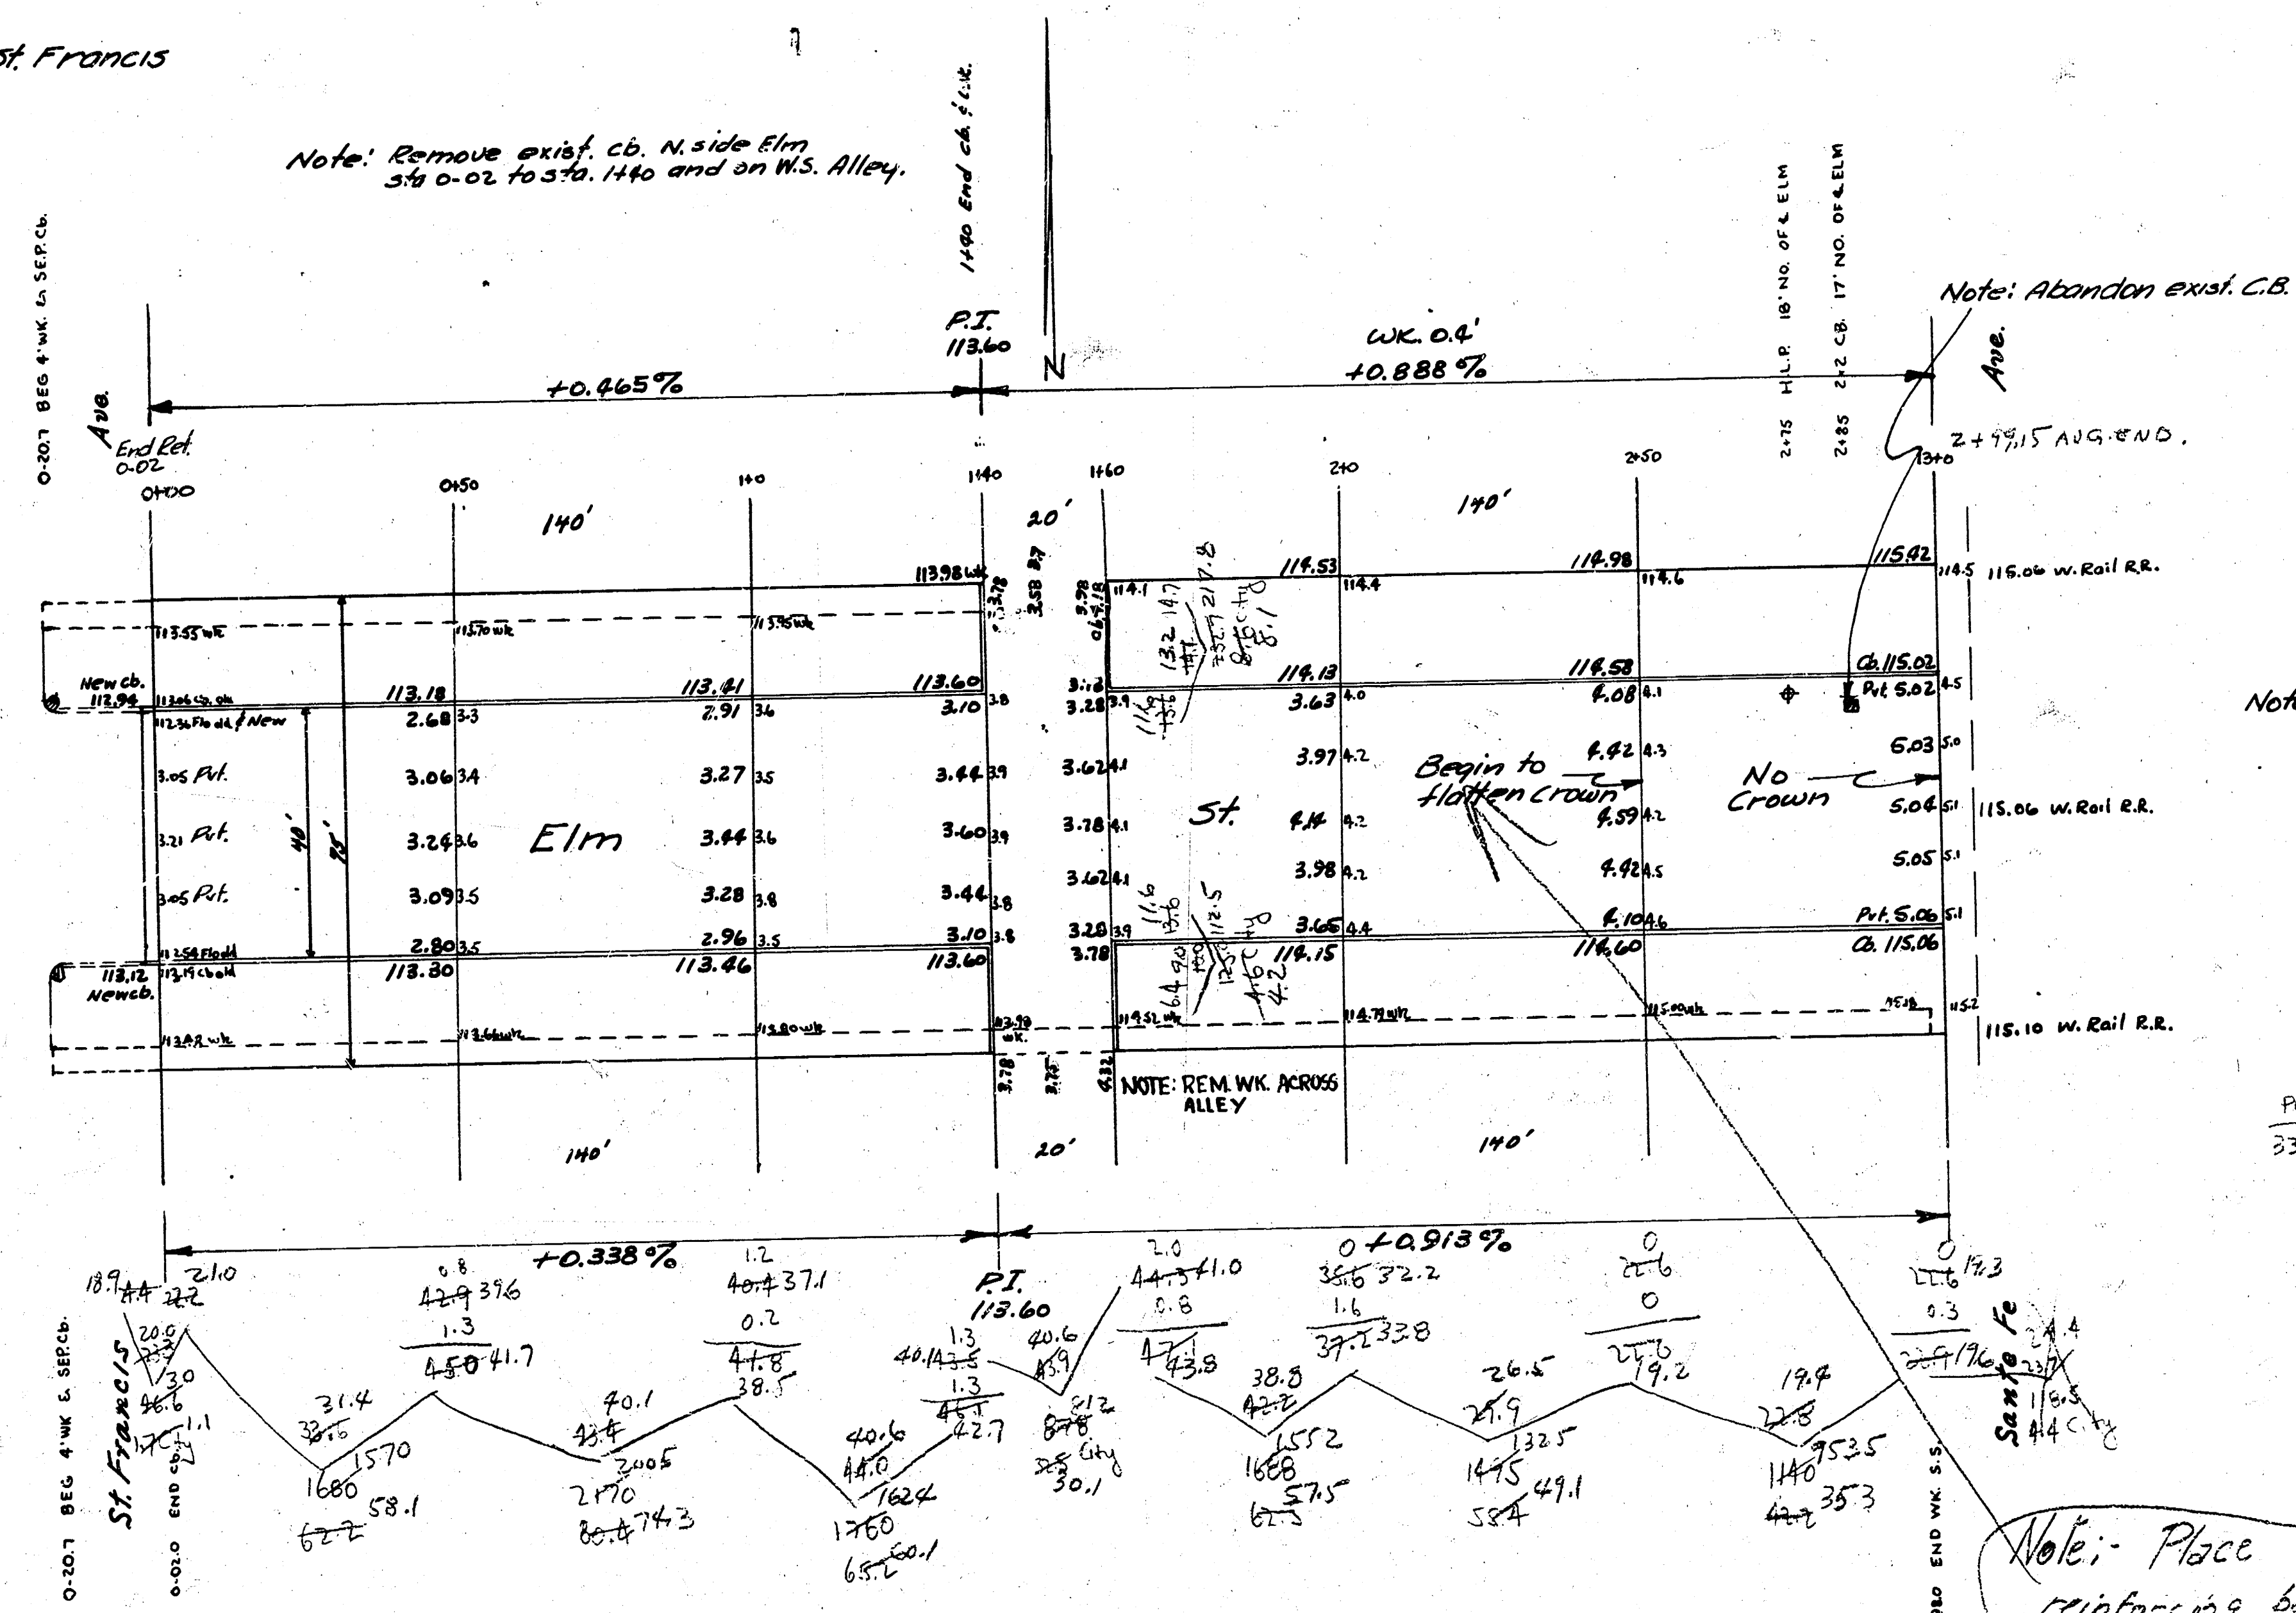

Note: Begin raising pvt. at Sta. 2+50 and have Pvt. flush with cb. at Sta. 3+00

Excav. Required for 7" Cove

Prop	City
62.2	1.7
80.4	37.5
65.2	4.6
62.5	8.6
55.4	4.4
42.2	51.8
367.9	+10.5%
1504.7	570 cu yds
367.9	-5.3 cu yds
367.9	570 cu yds

Note: Place transverse reinforcing bars in usual pattern

Elm St
 EL. St. Francis — W.L. Santa Fe.
 40' Conc. & Cb.
 6" Conc.
 City of Wichita, Kansas
 L.H. White City Engineer
 January 1929 Project 018-170