

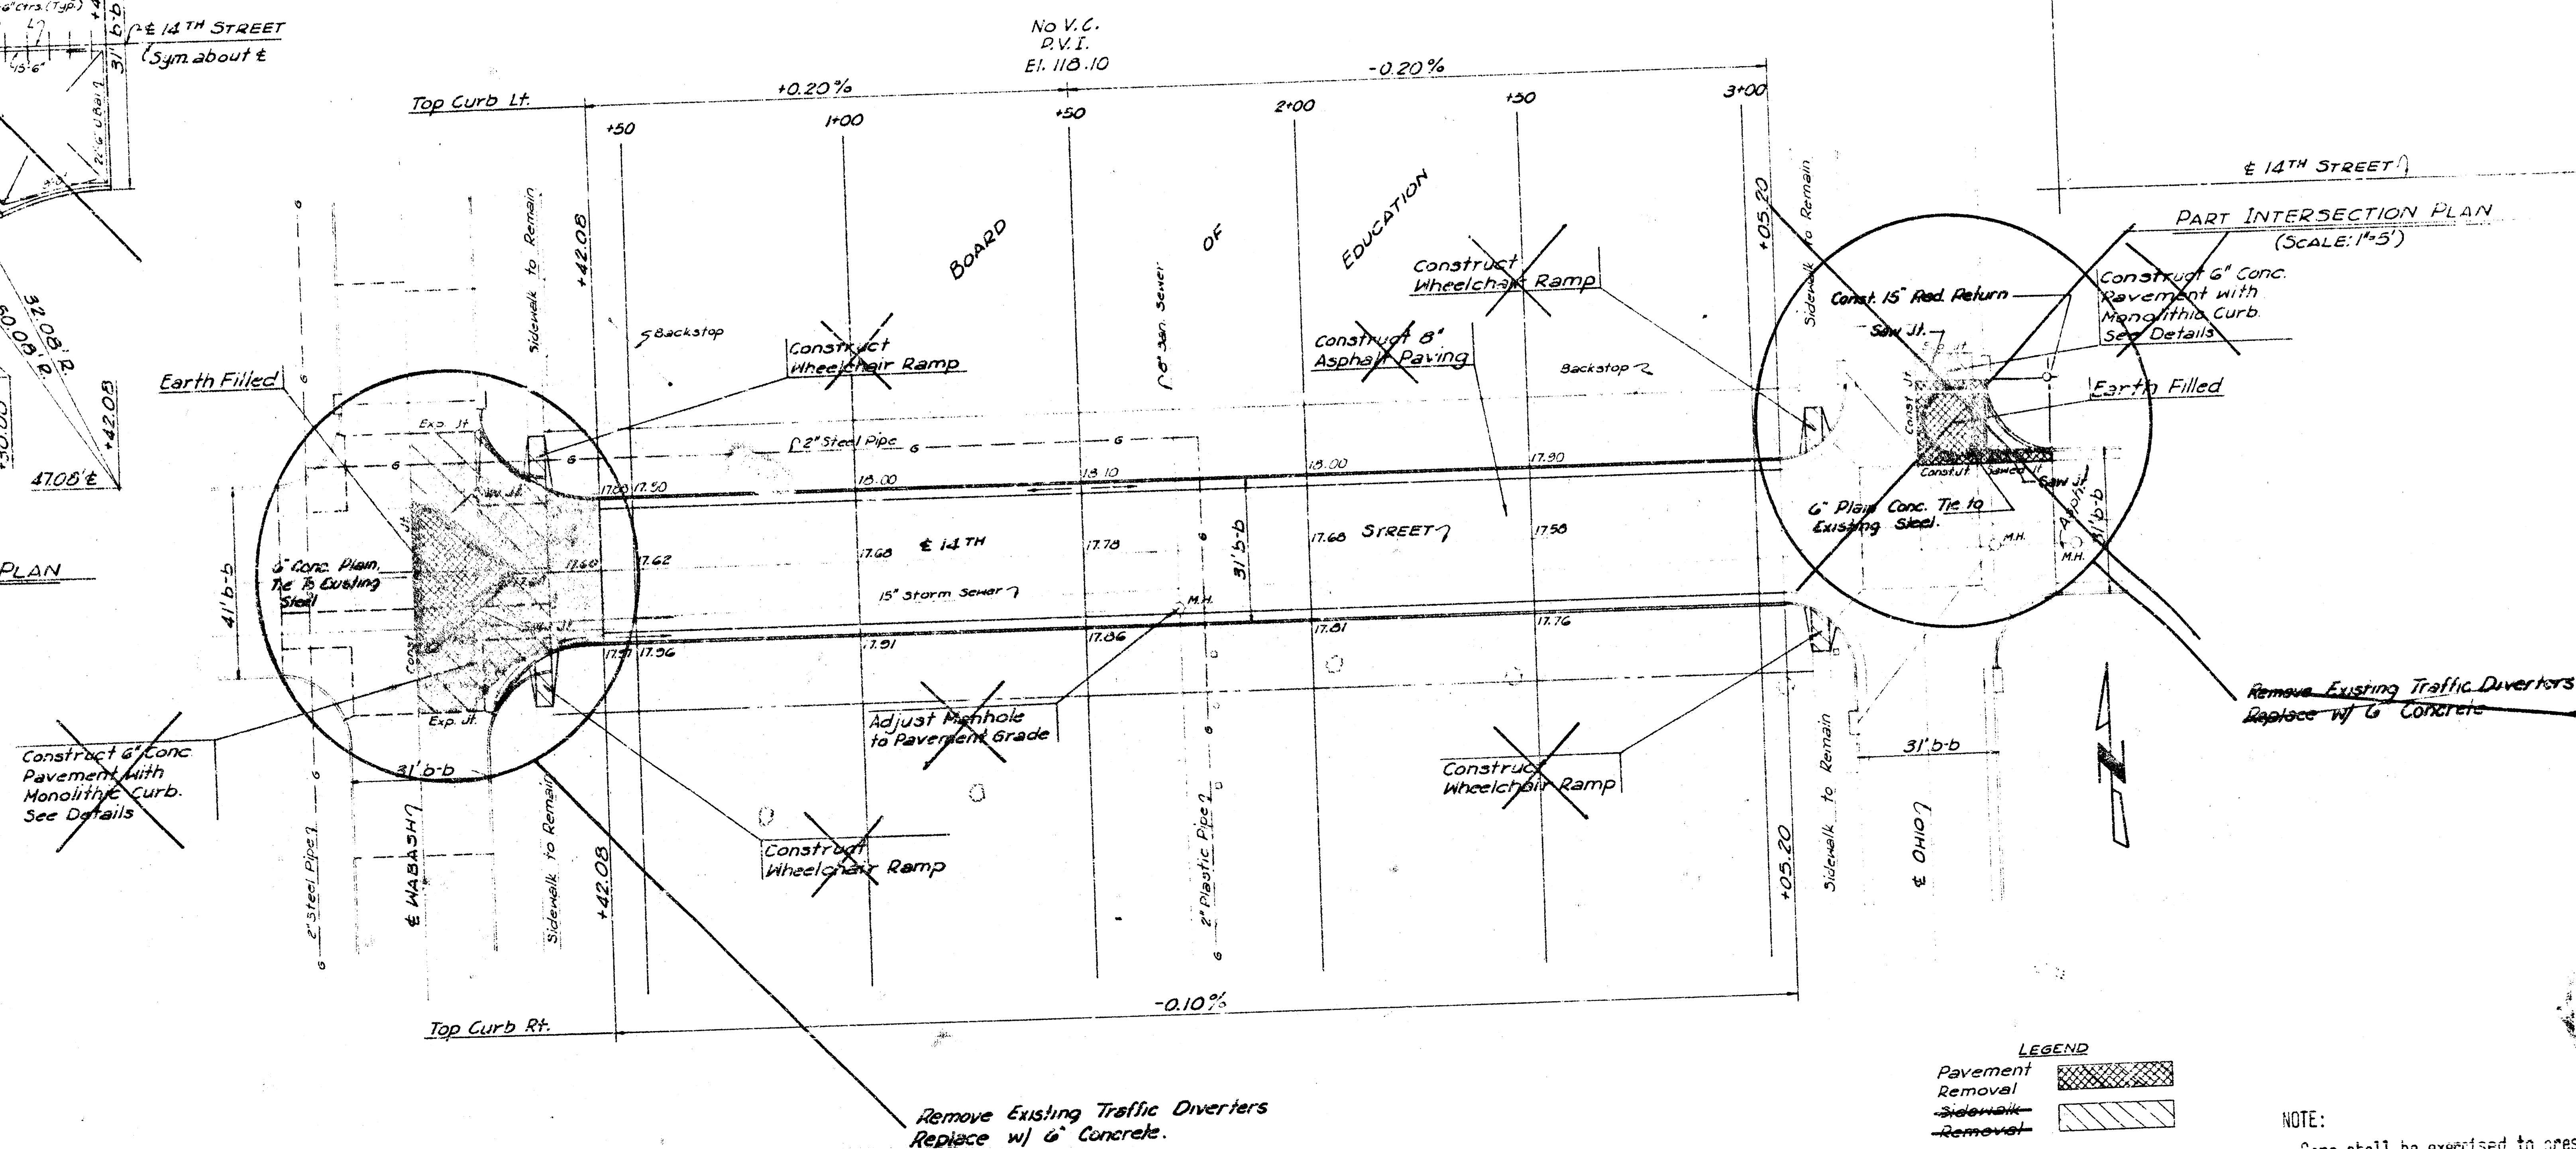
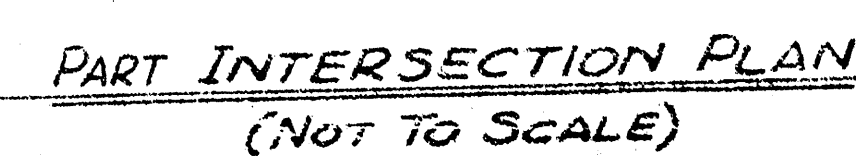
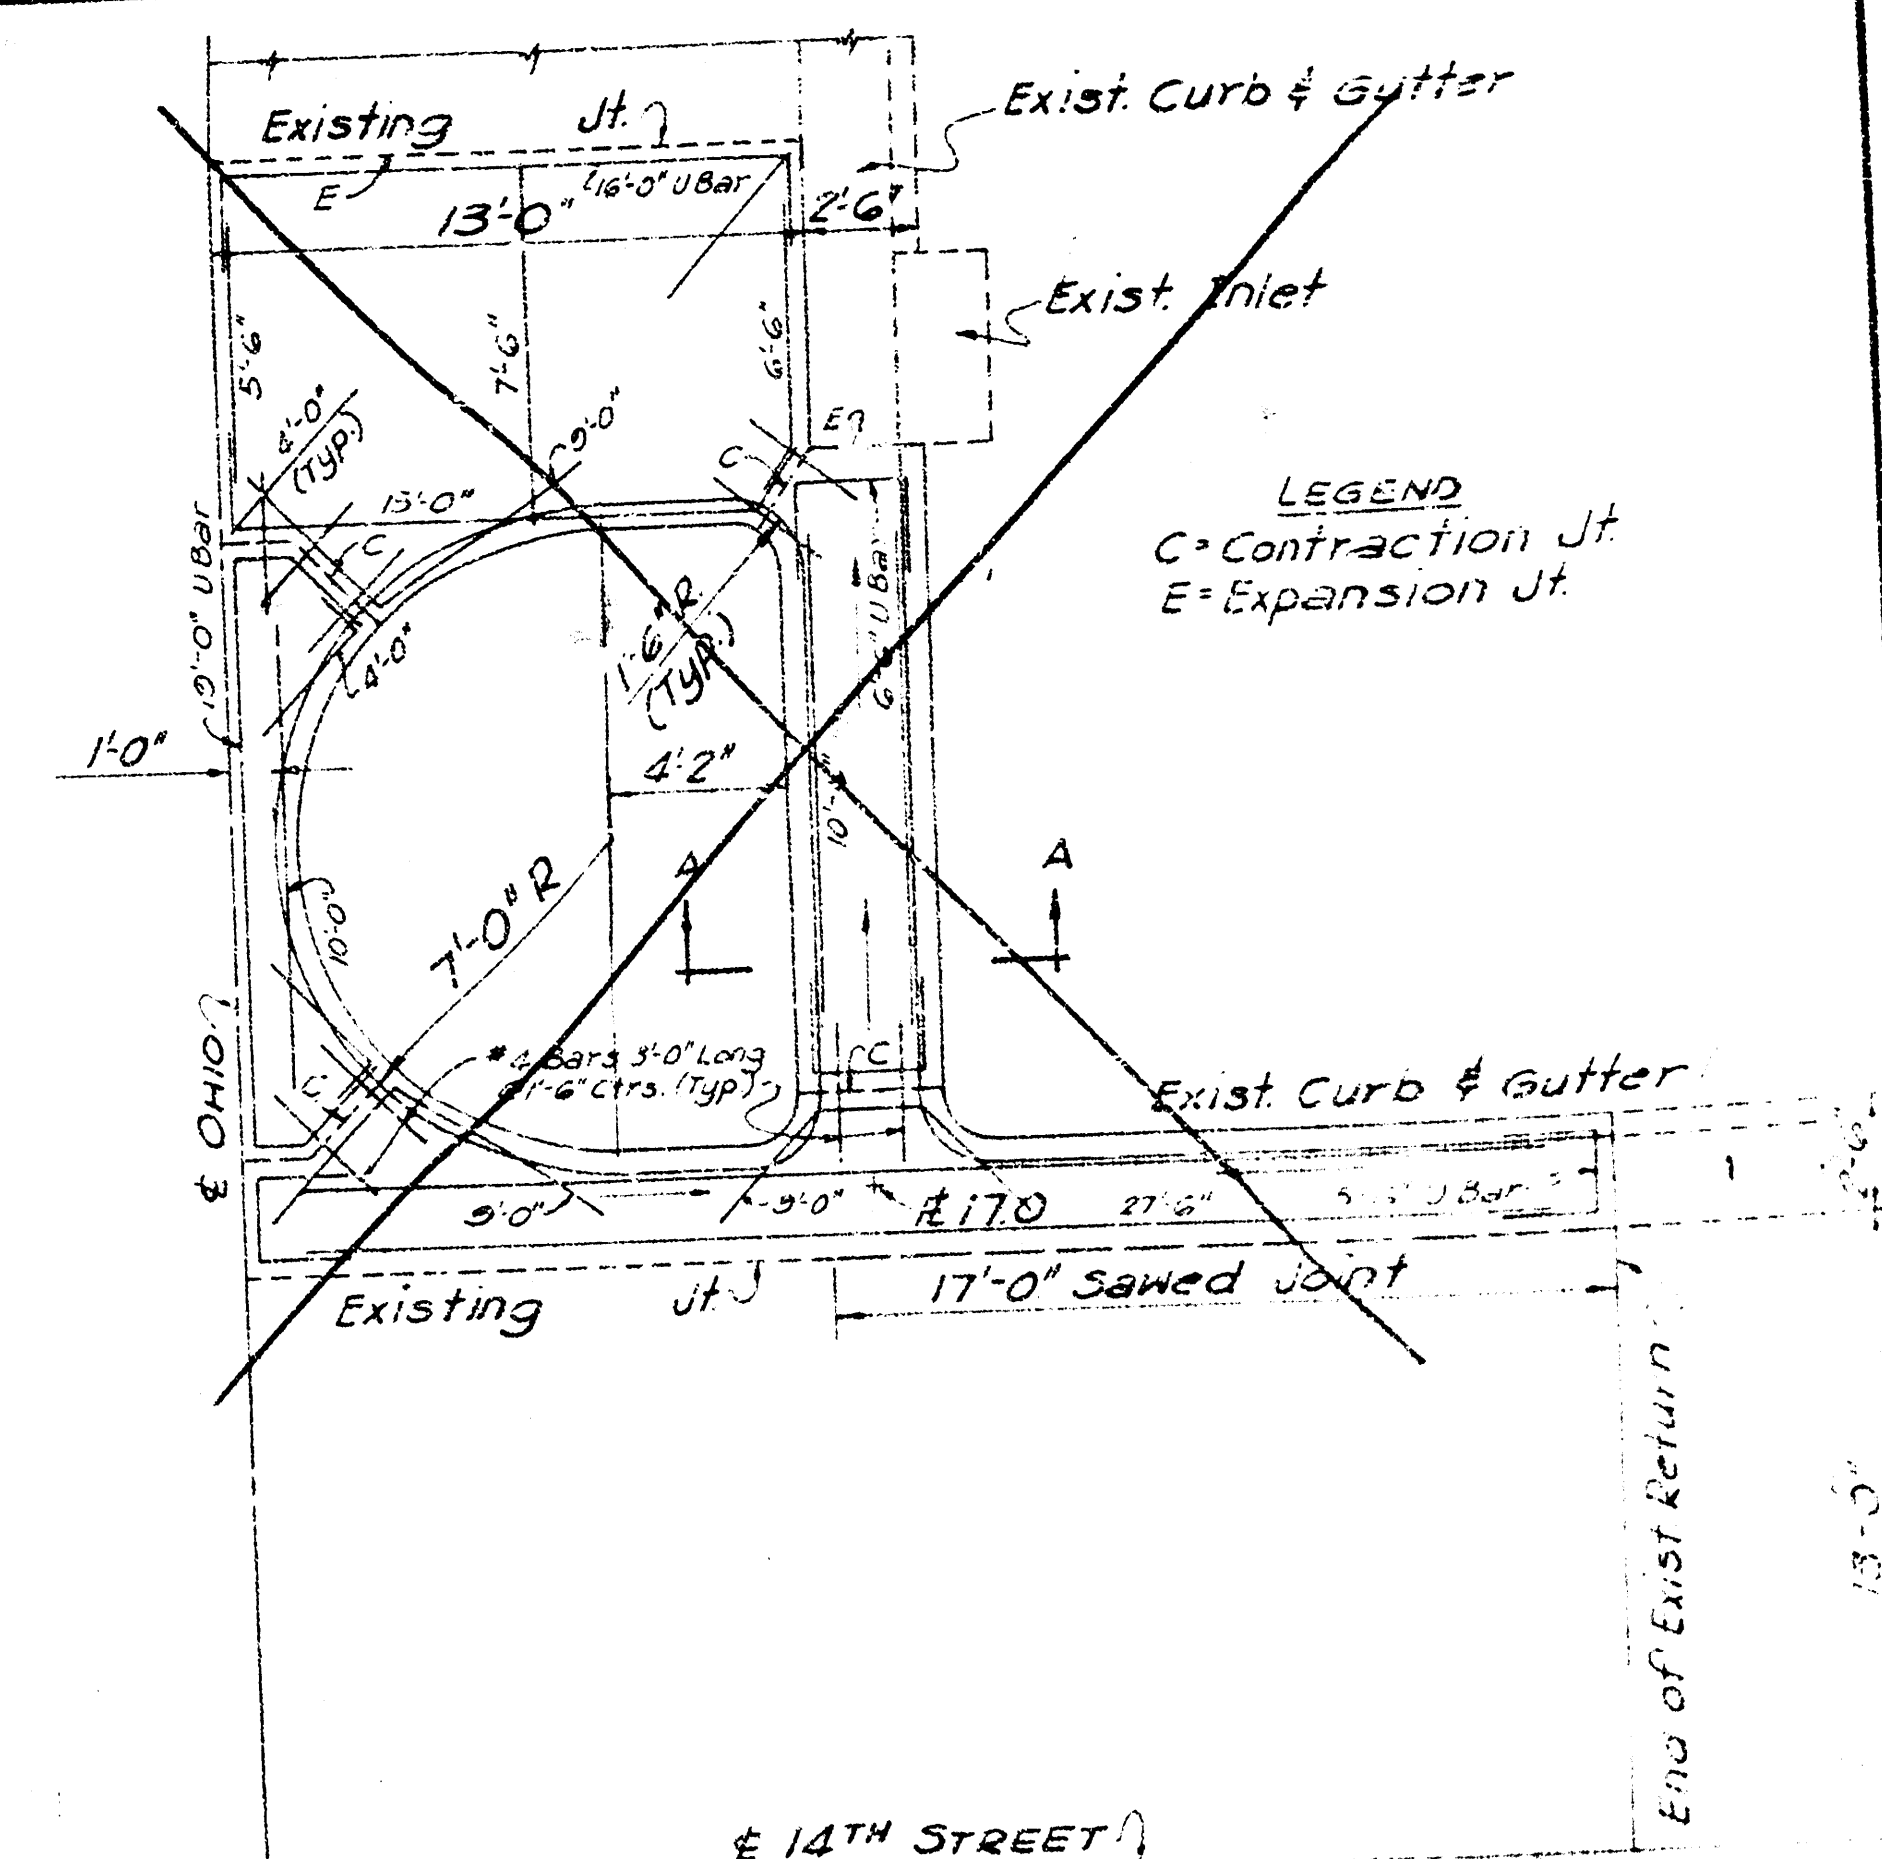
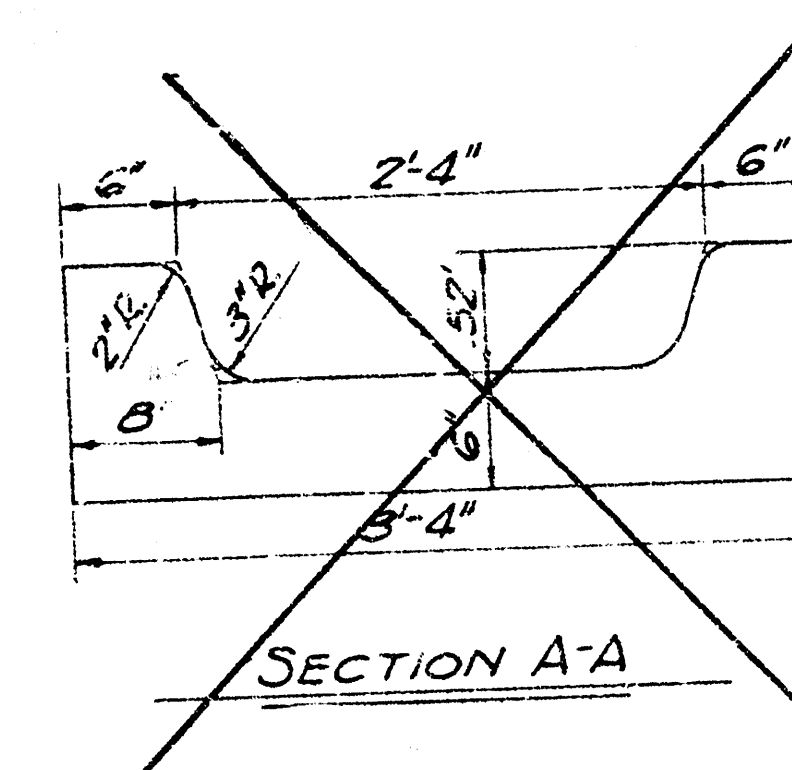
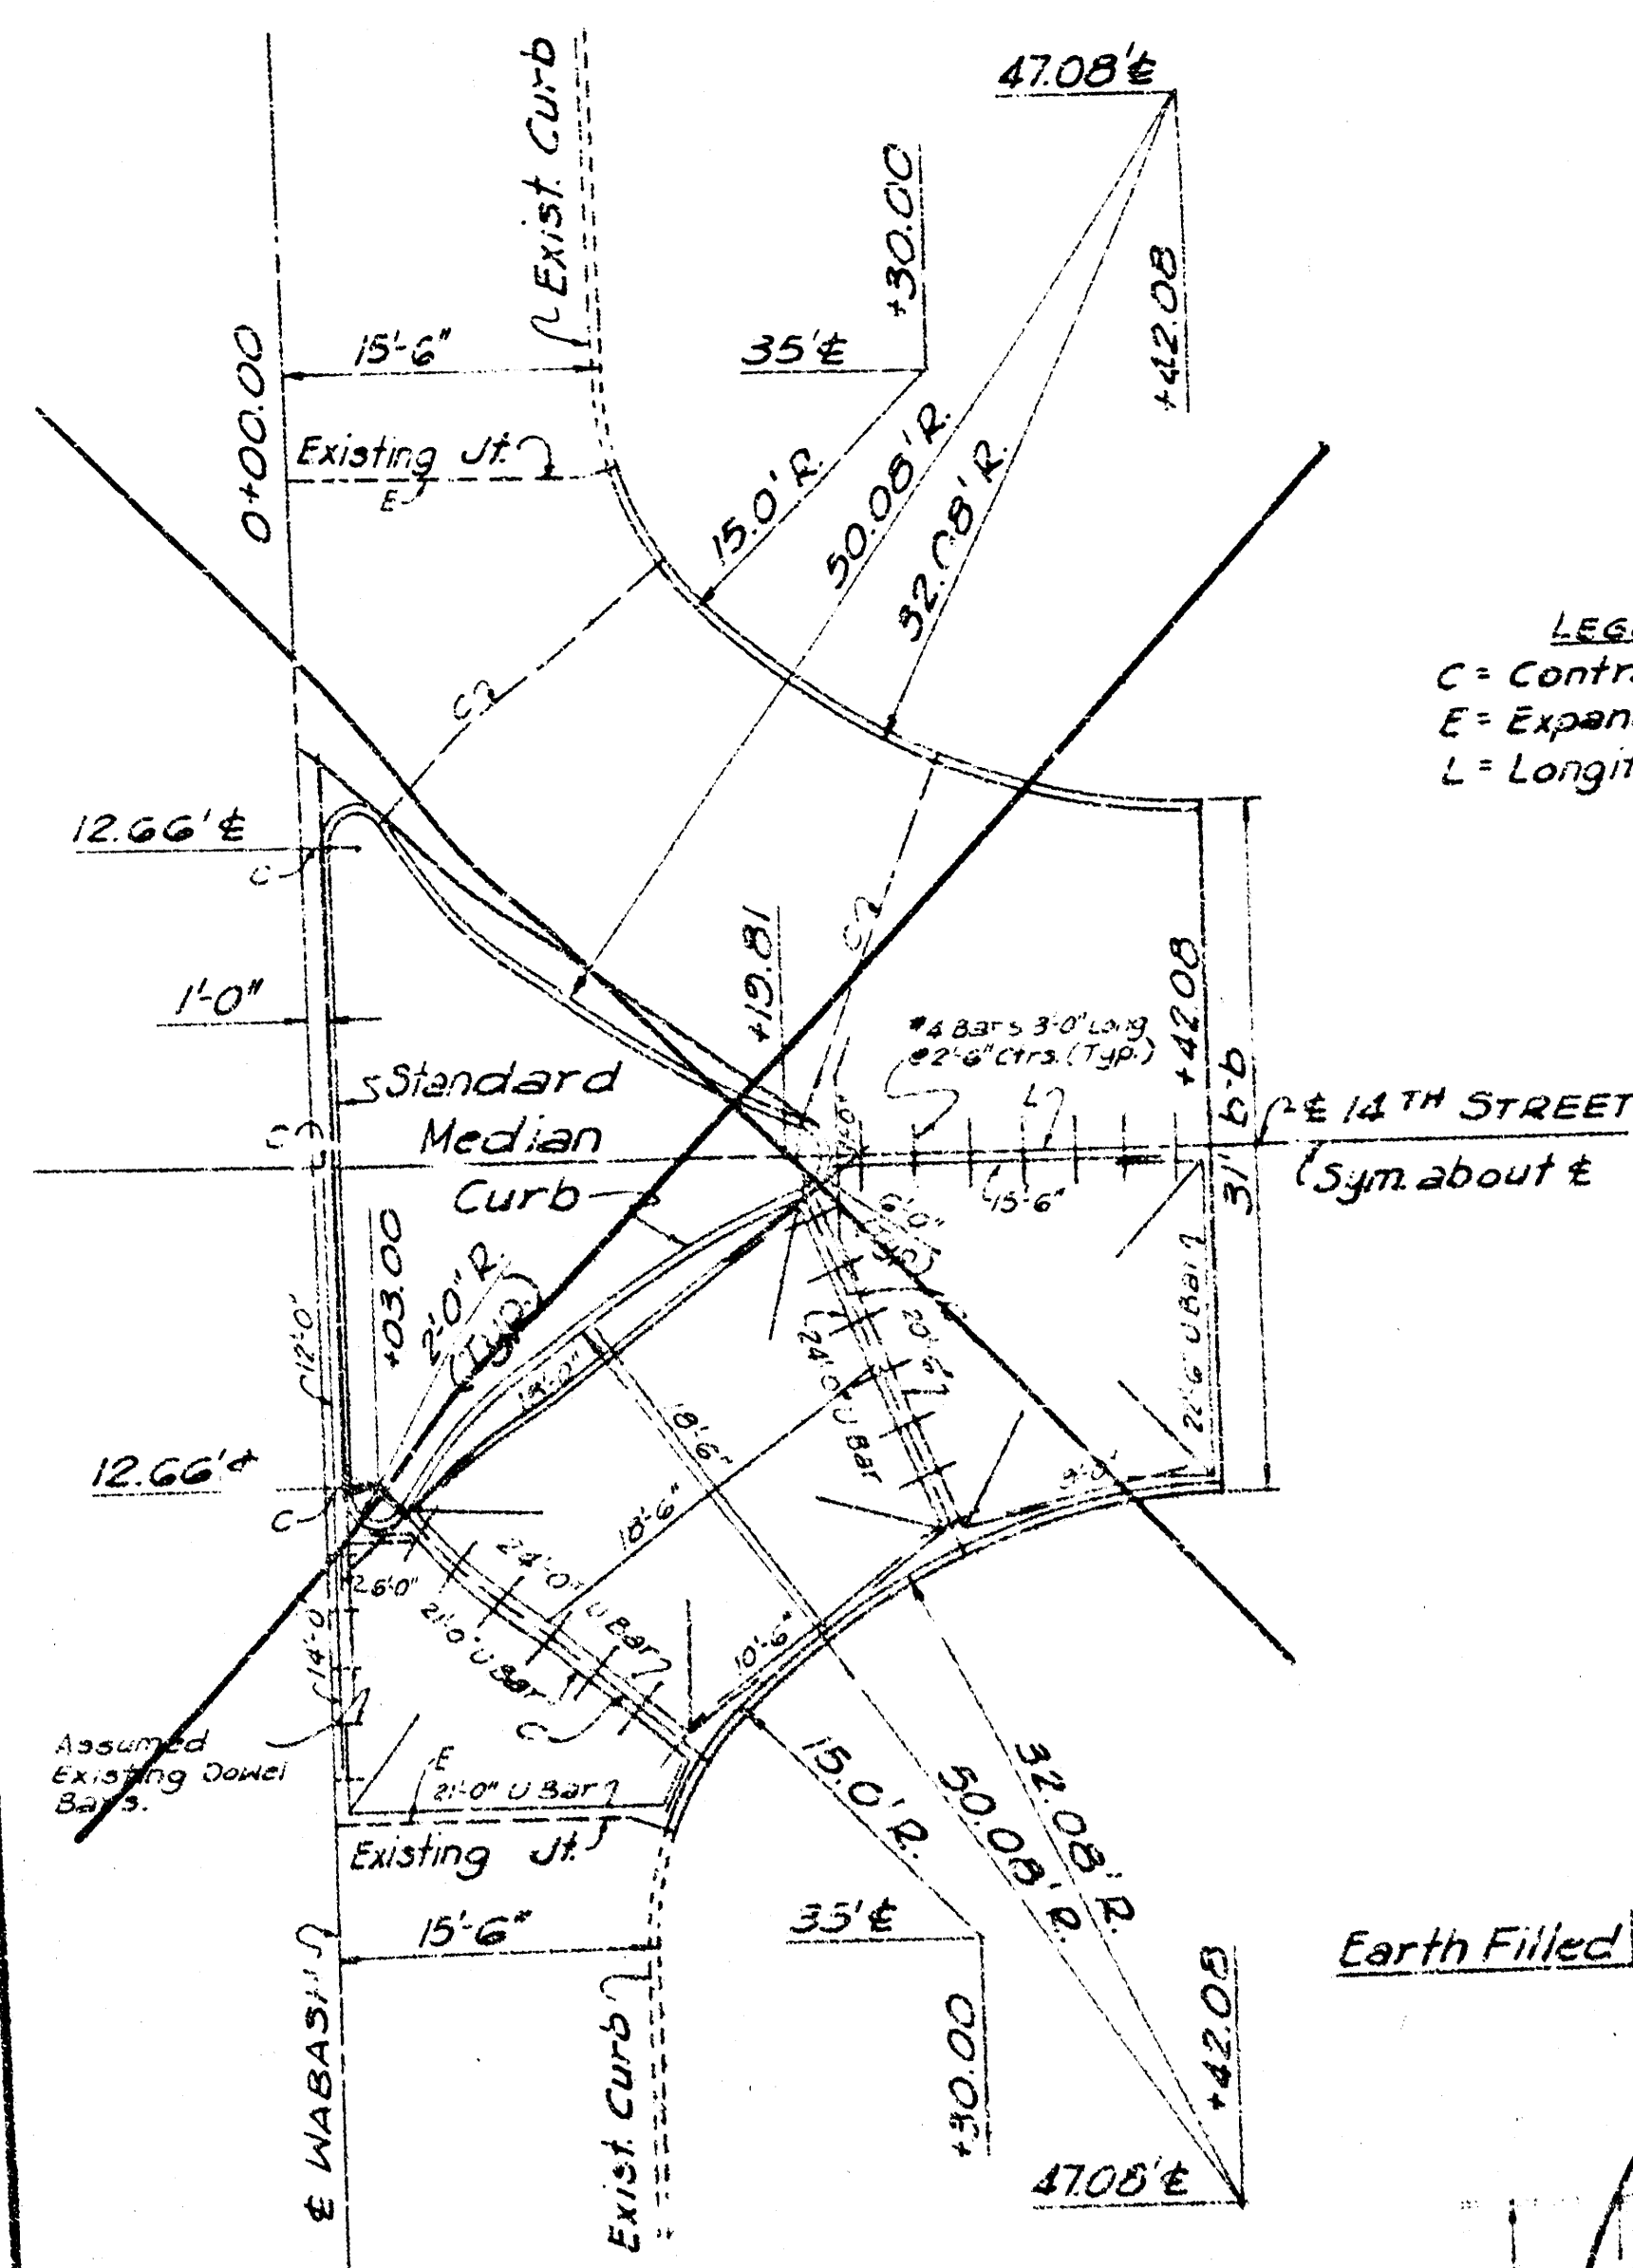
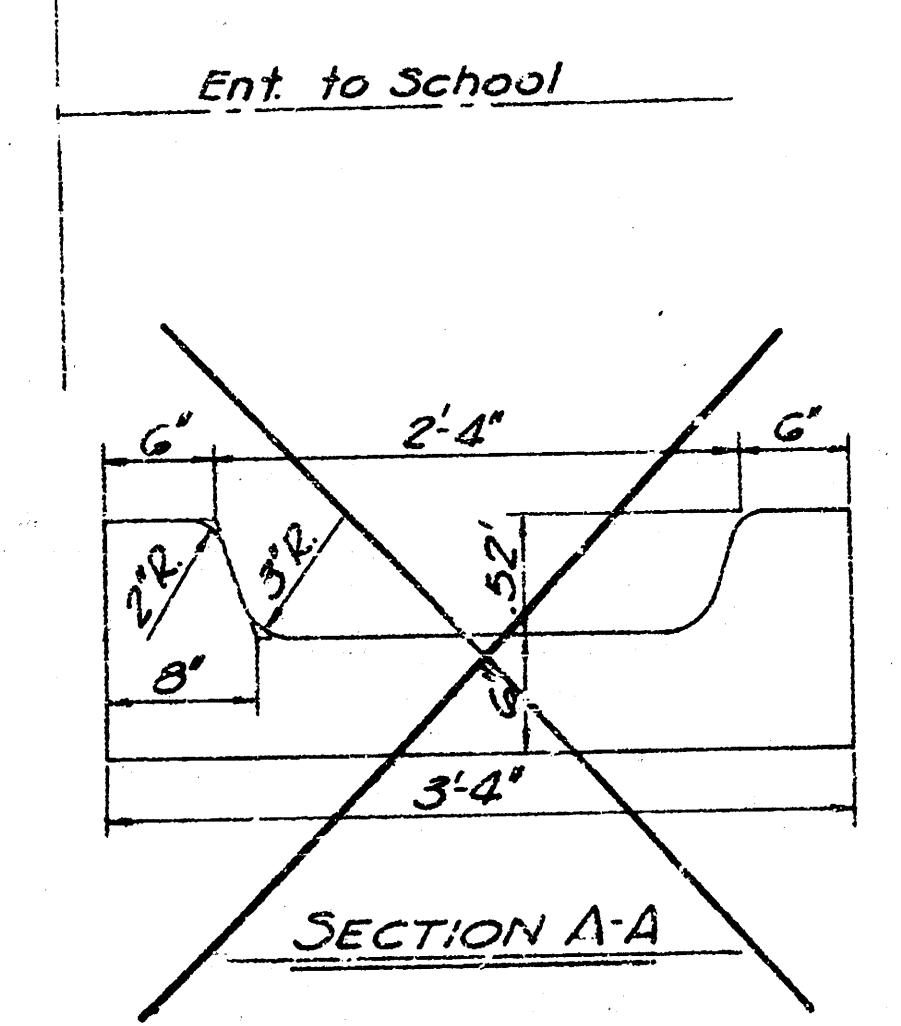
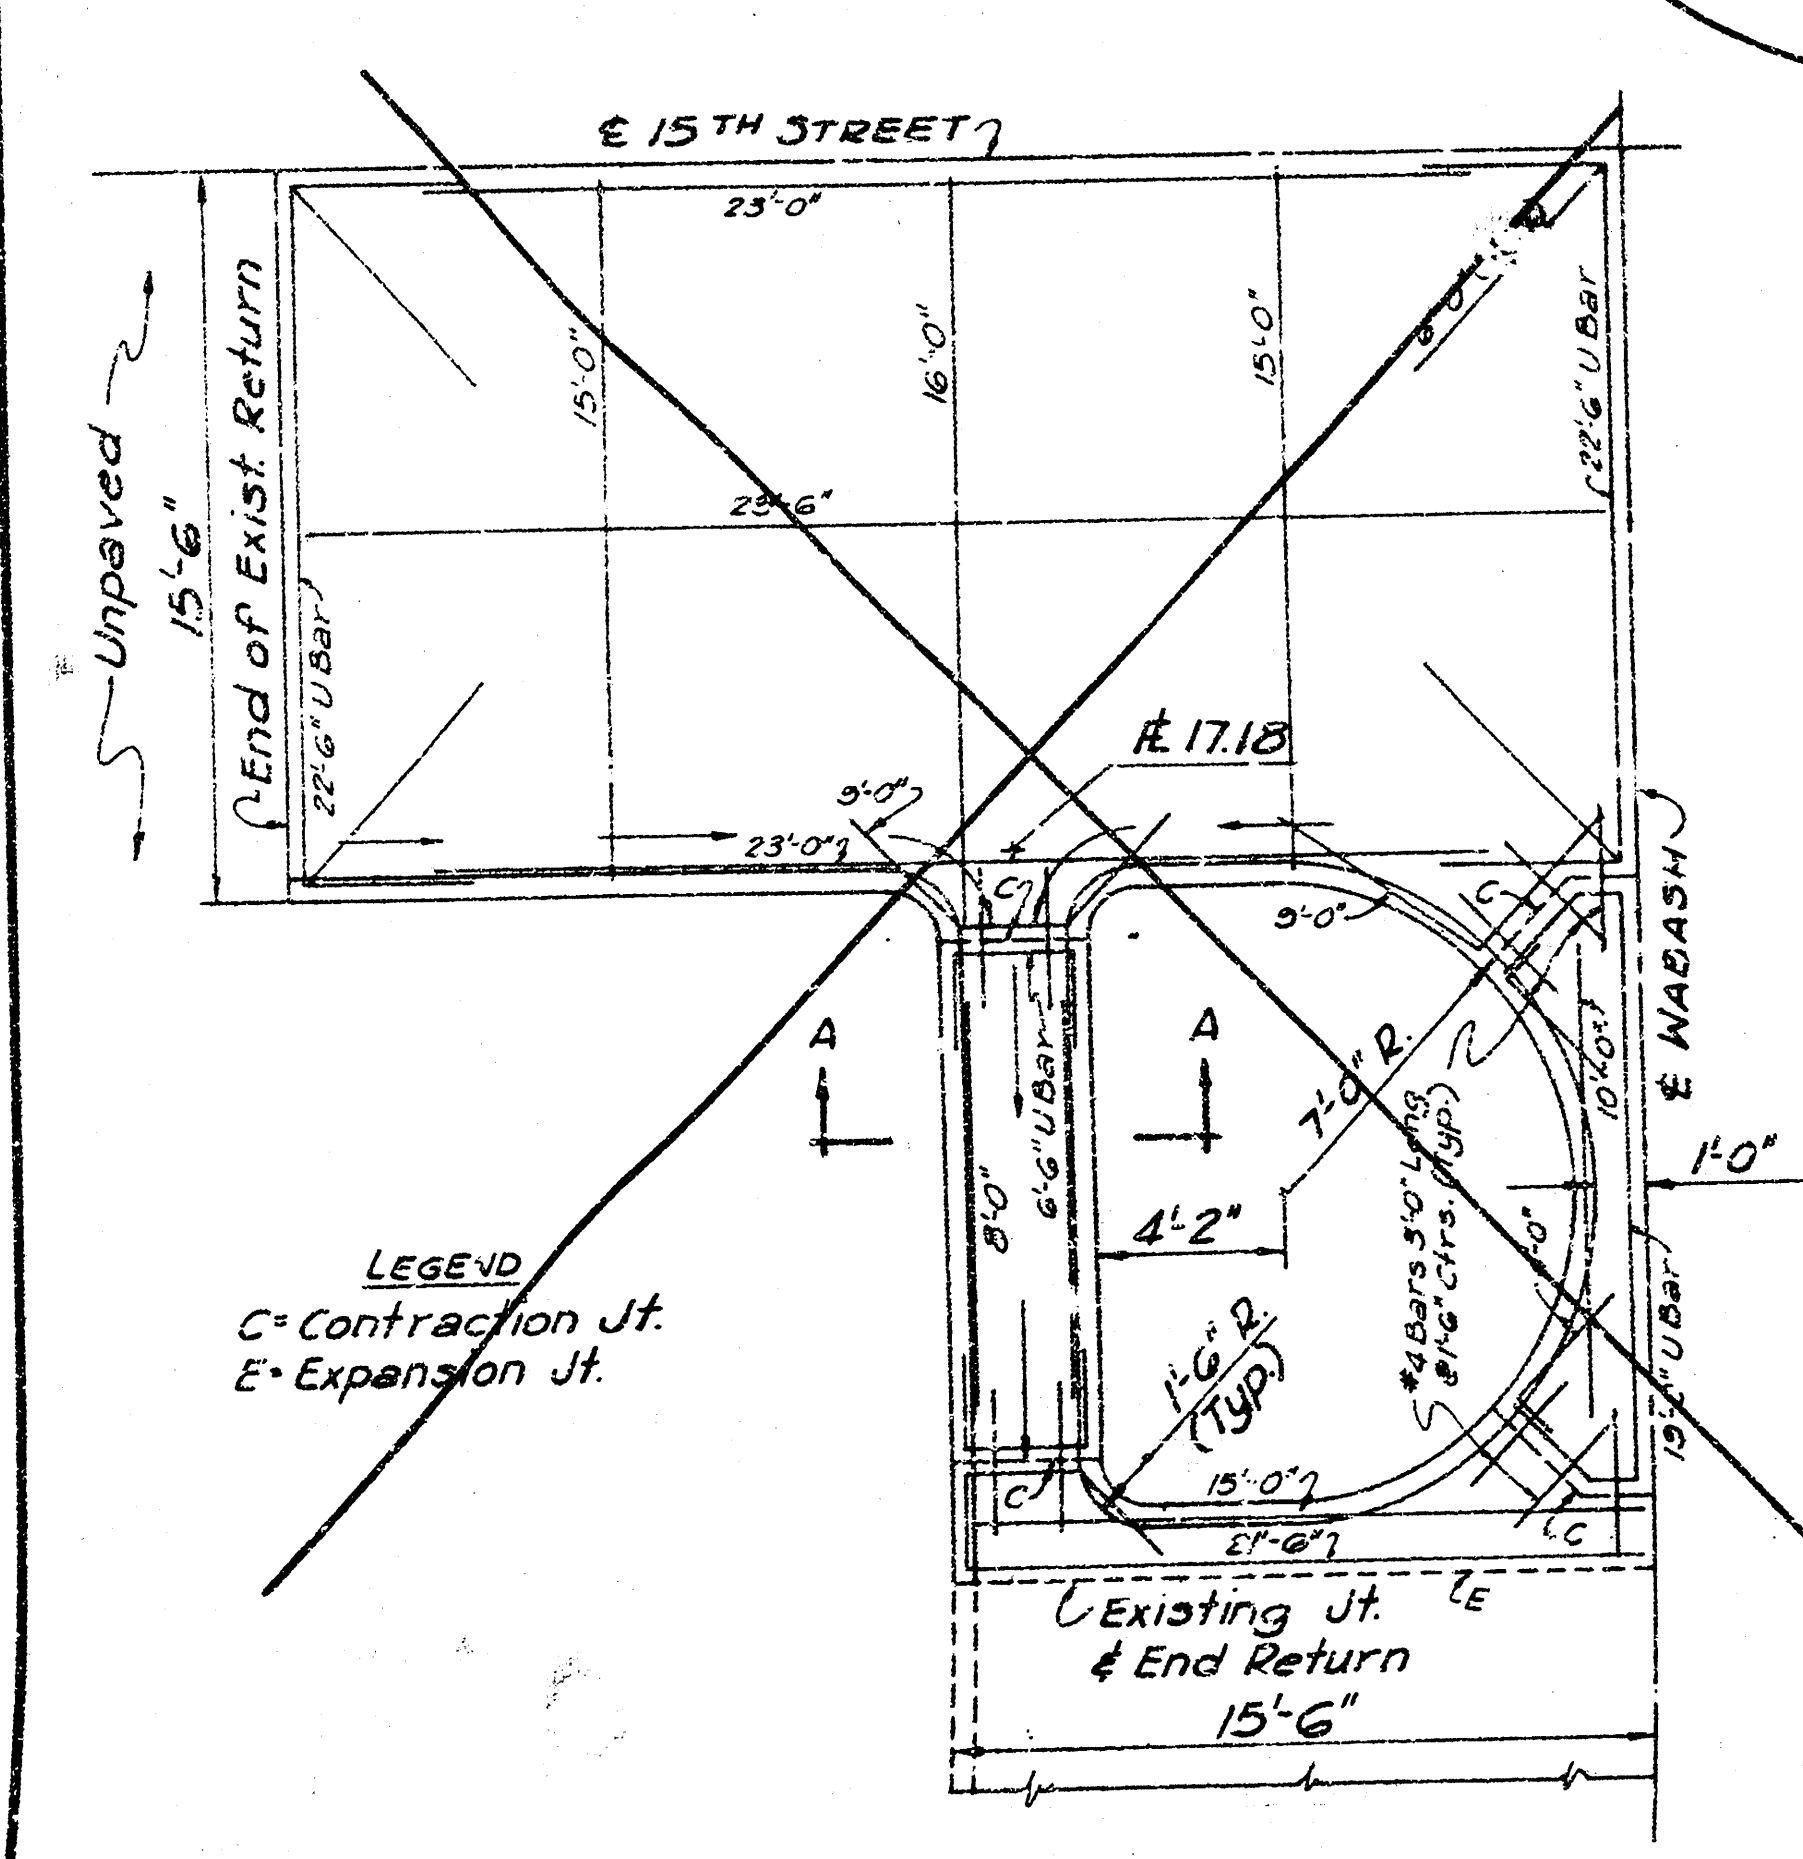
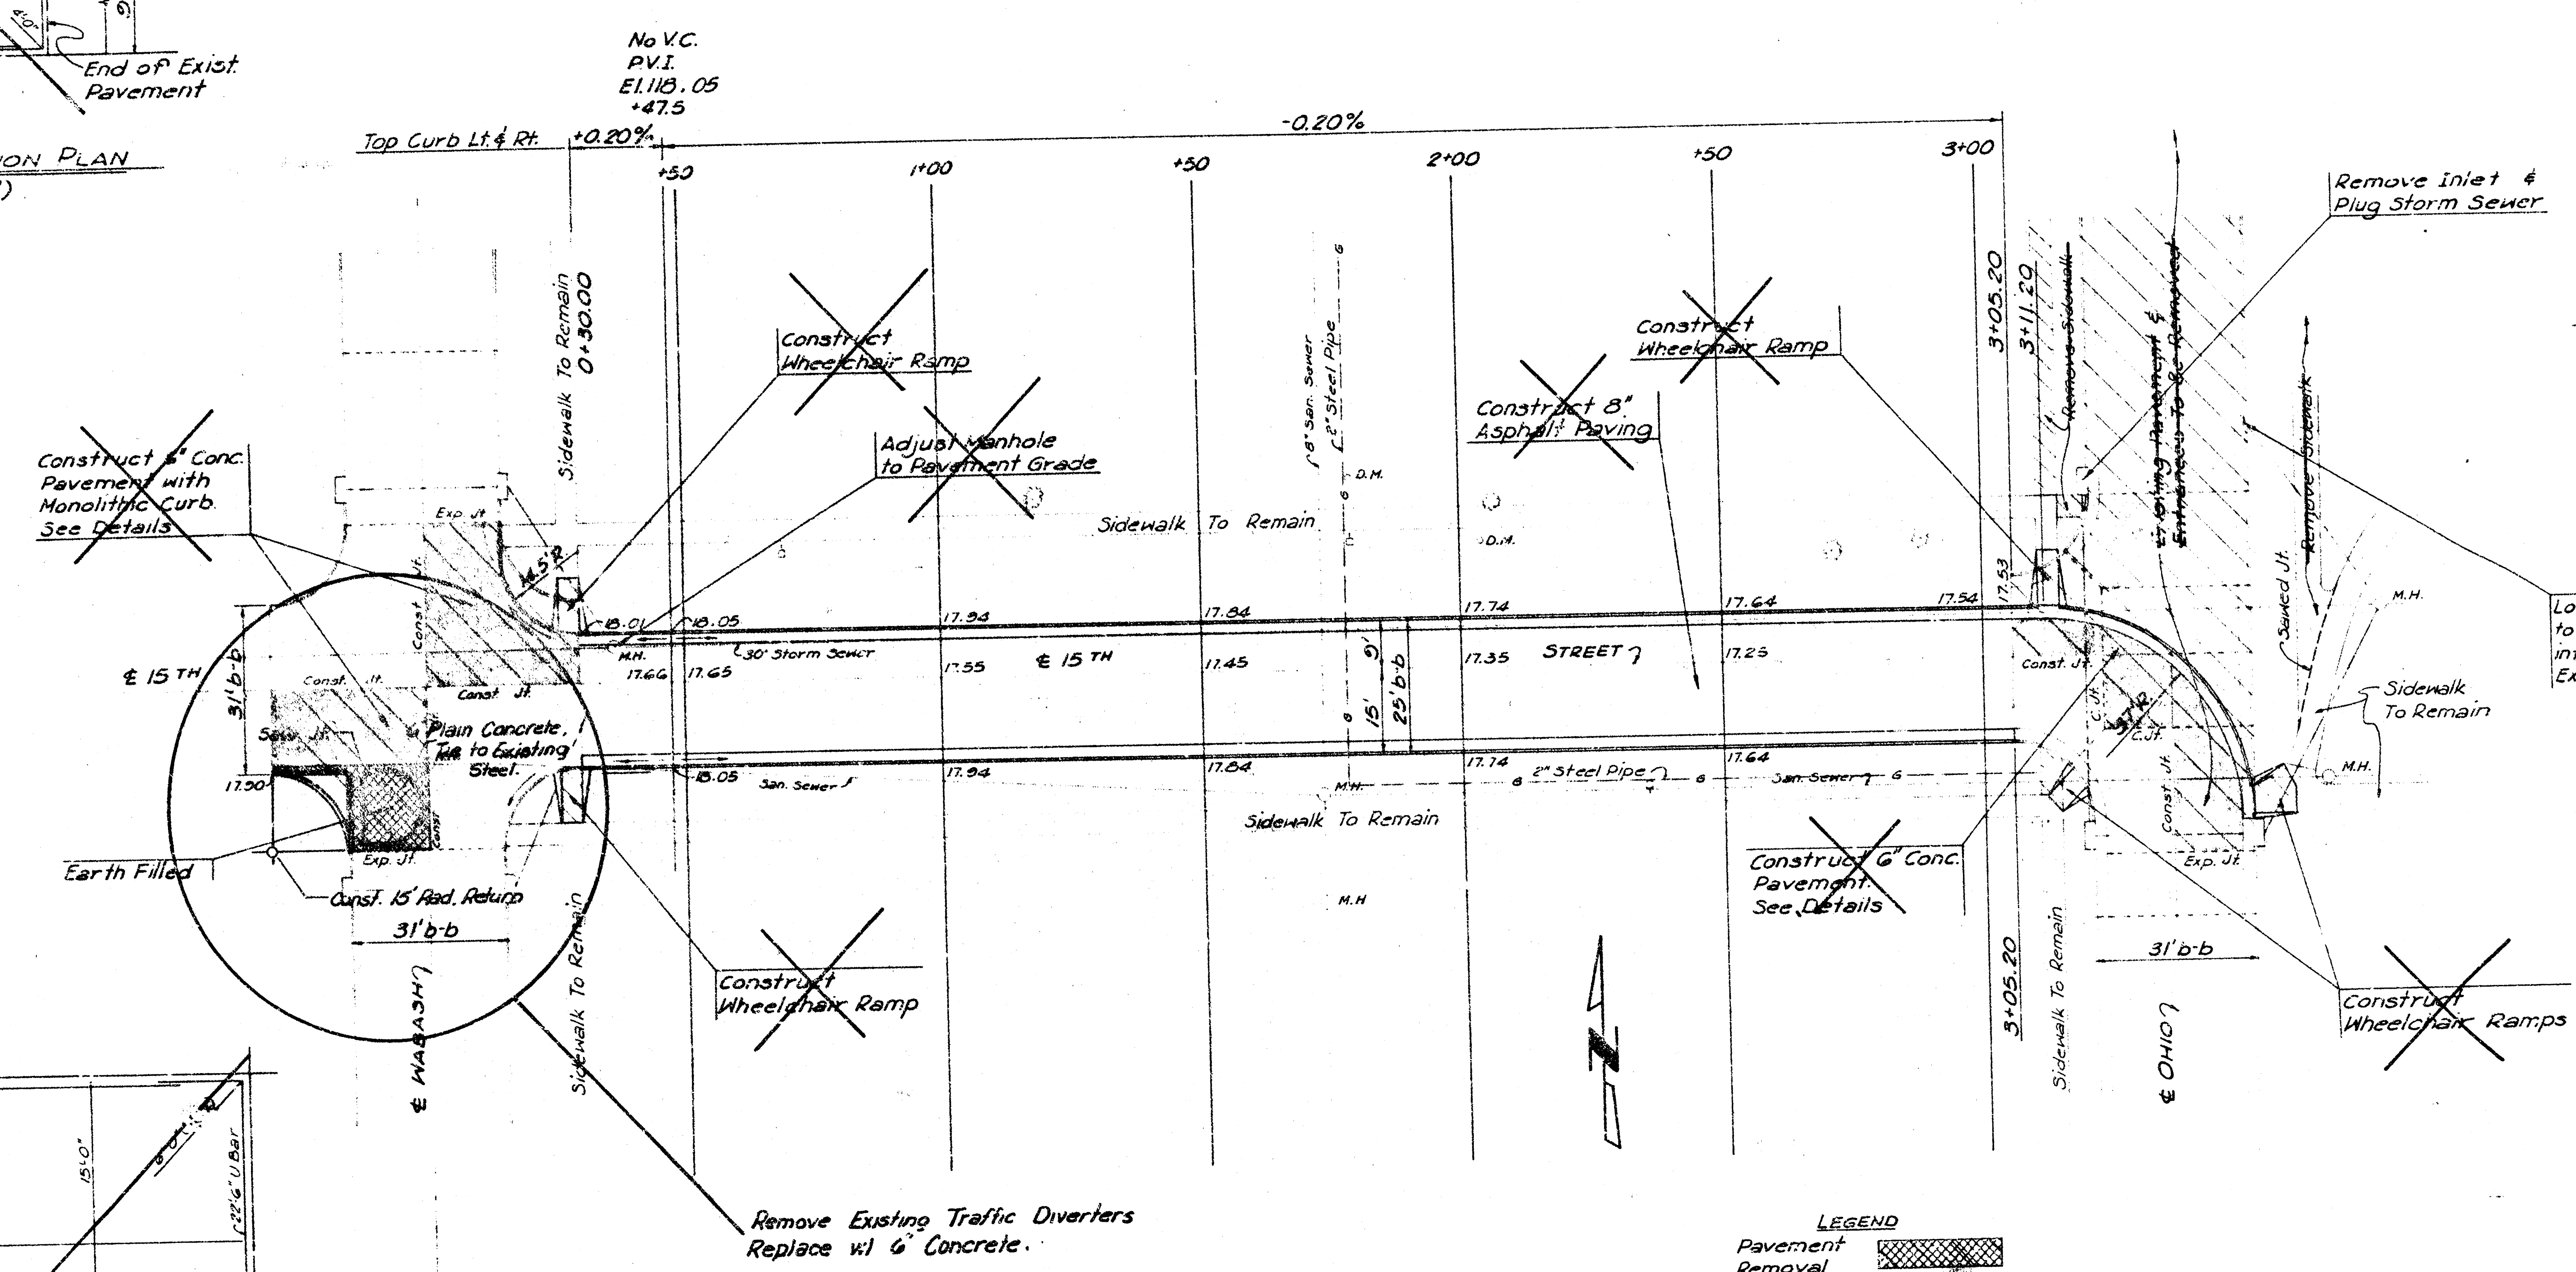


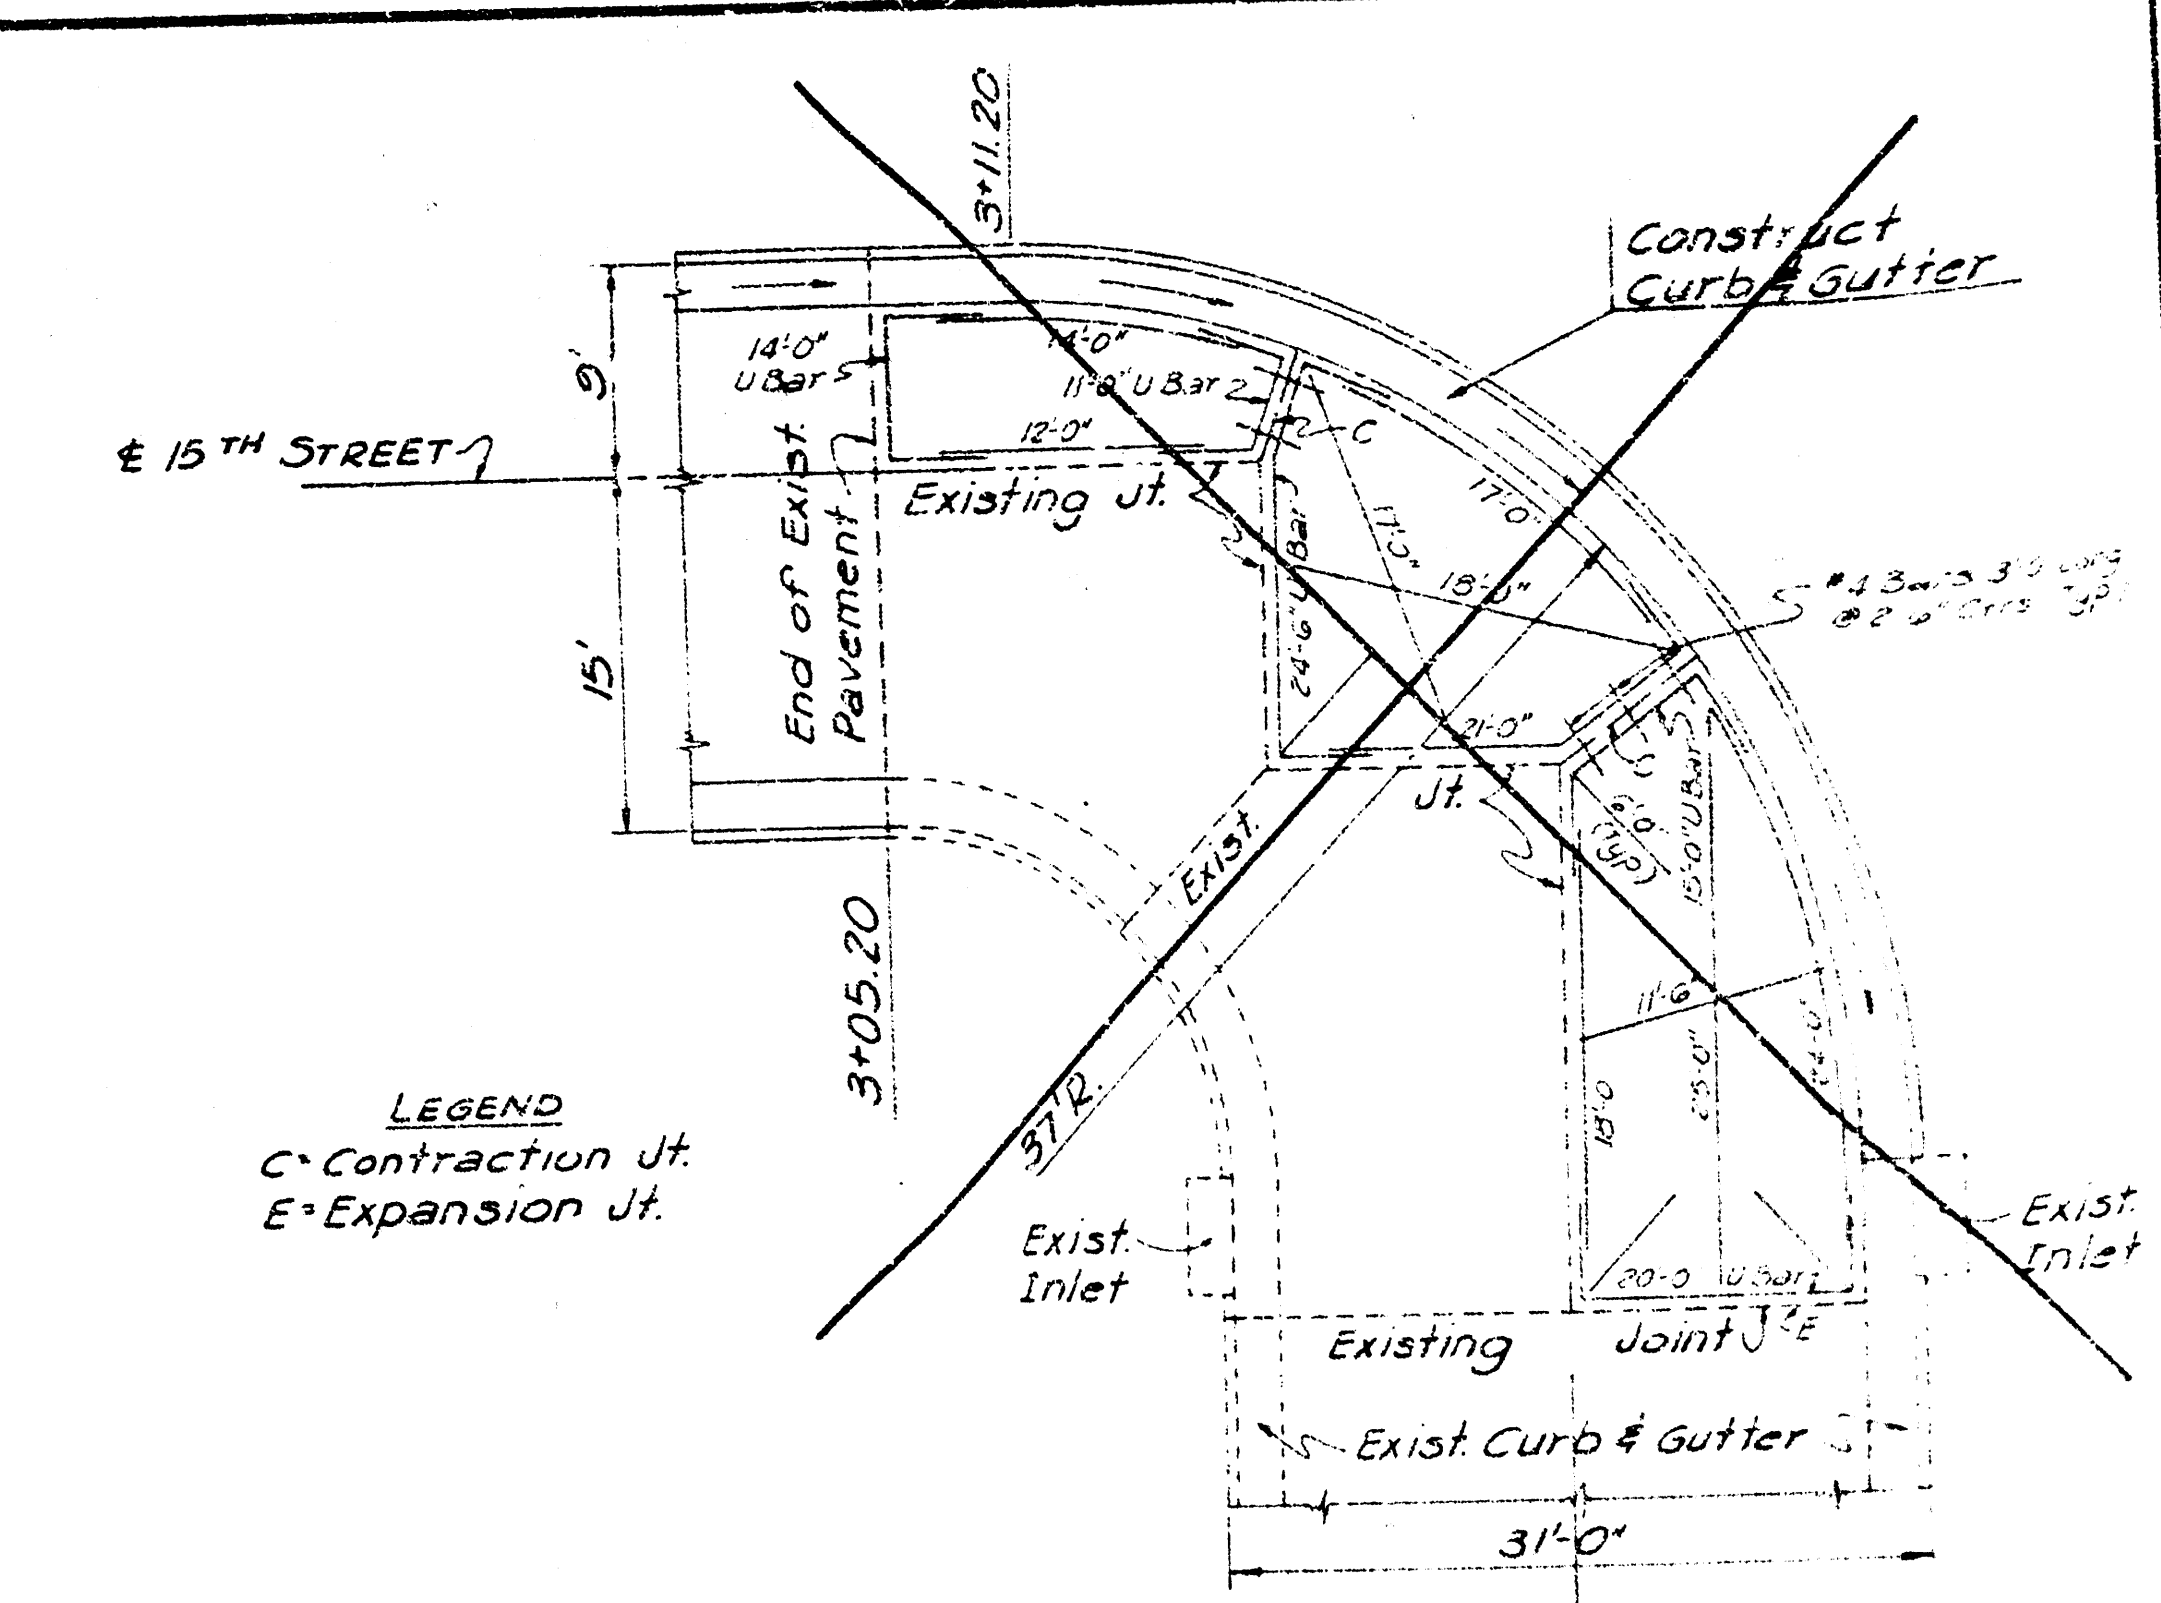

NOTE:
Care shall be exercised to preserve any dowel bars in existing slabs at joints of new pavement to old.

City of Wichita	Dept. of Engineering
Removal of Traffic Diversers at i4th and Wabash	
Proj. no	815-59-192-50116-430-102-000
SCALE 1"=20'	DATE
	DWG. NO.

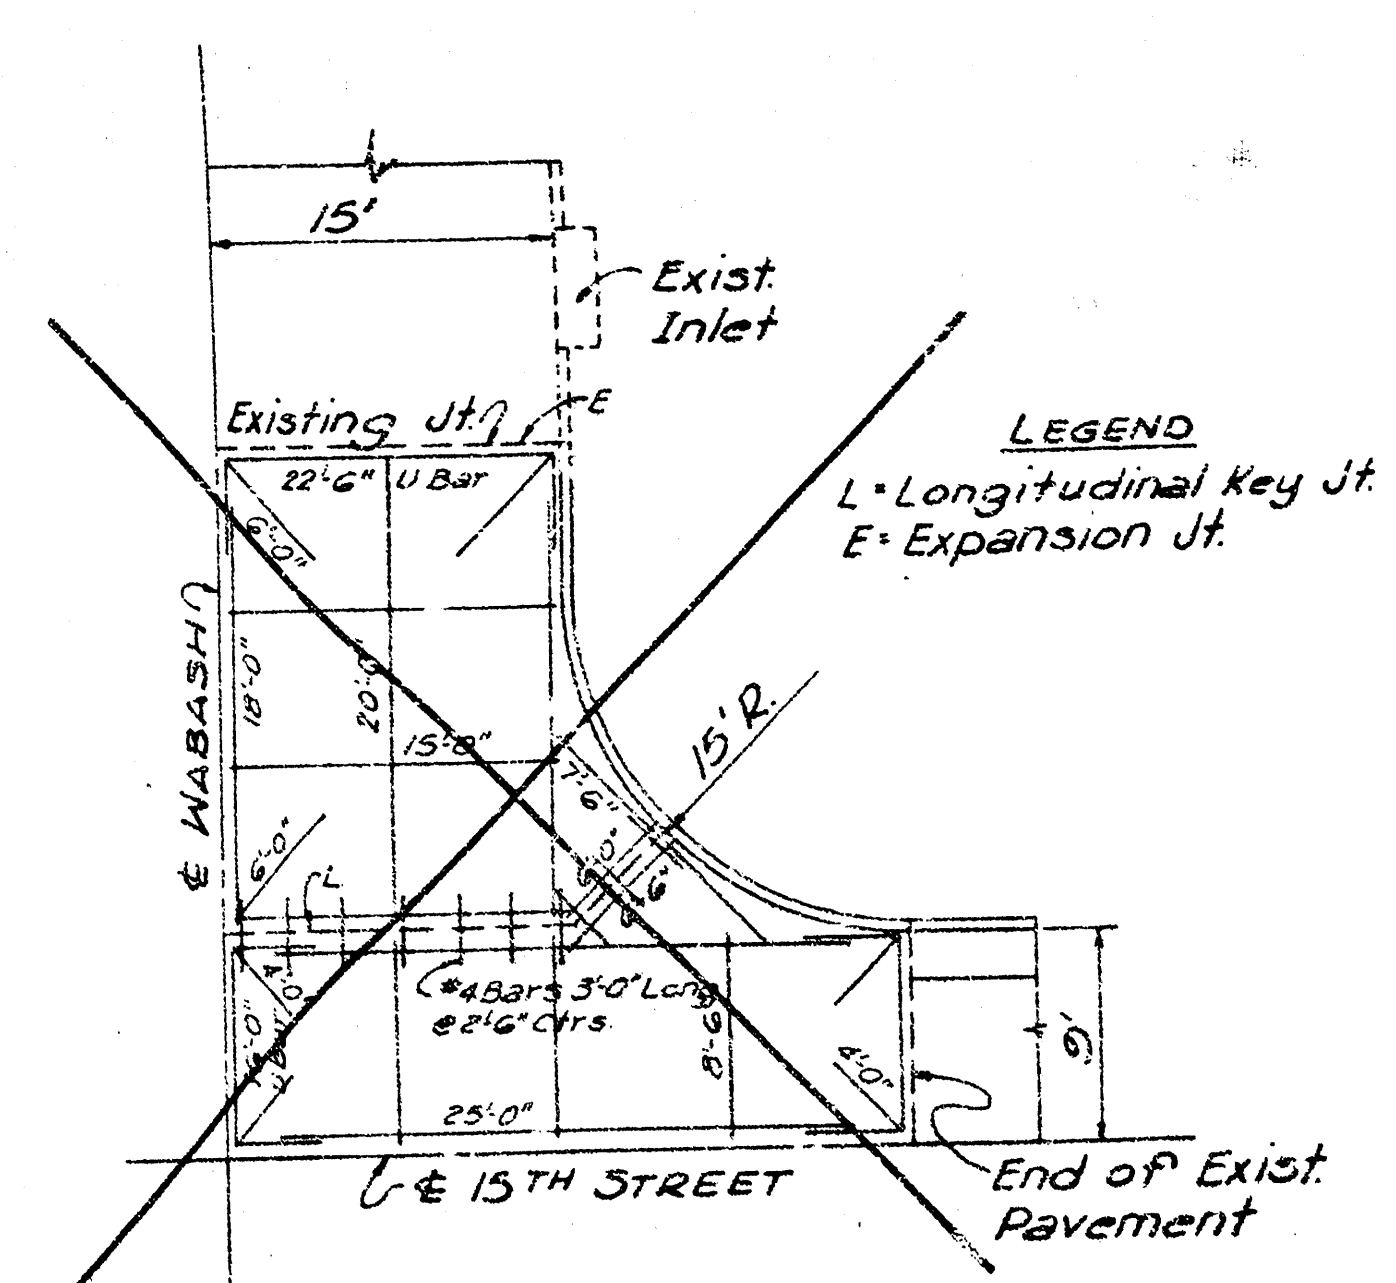

LEGEND
 Pavement Removal
 Sidewalk Removal
 Removal

NOTE:
 Care shall be exercised to preserve any dowel bars in existing slabs at joints of new pavement to old.

City of Wichita	
Dept. of Engineering	
Removal of Traffic Diverters at 15th and Wabash	
Proj. no.	815-58-192-50116-430-102-000
SCALE 1"=20'	DATE
10 4 1 0	

FILMED FROM THE BEST