

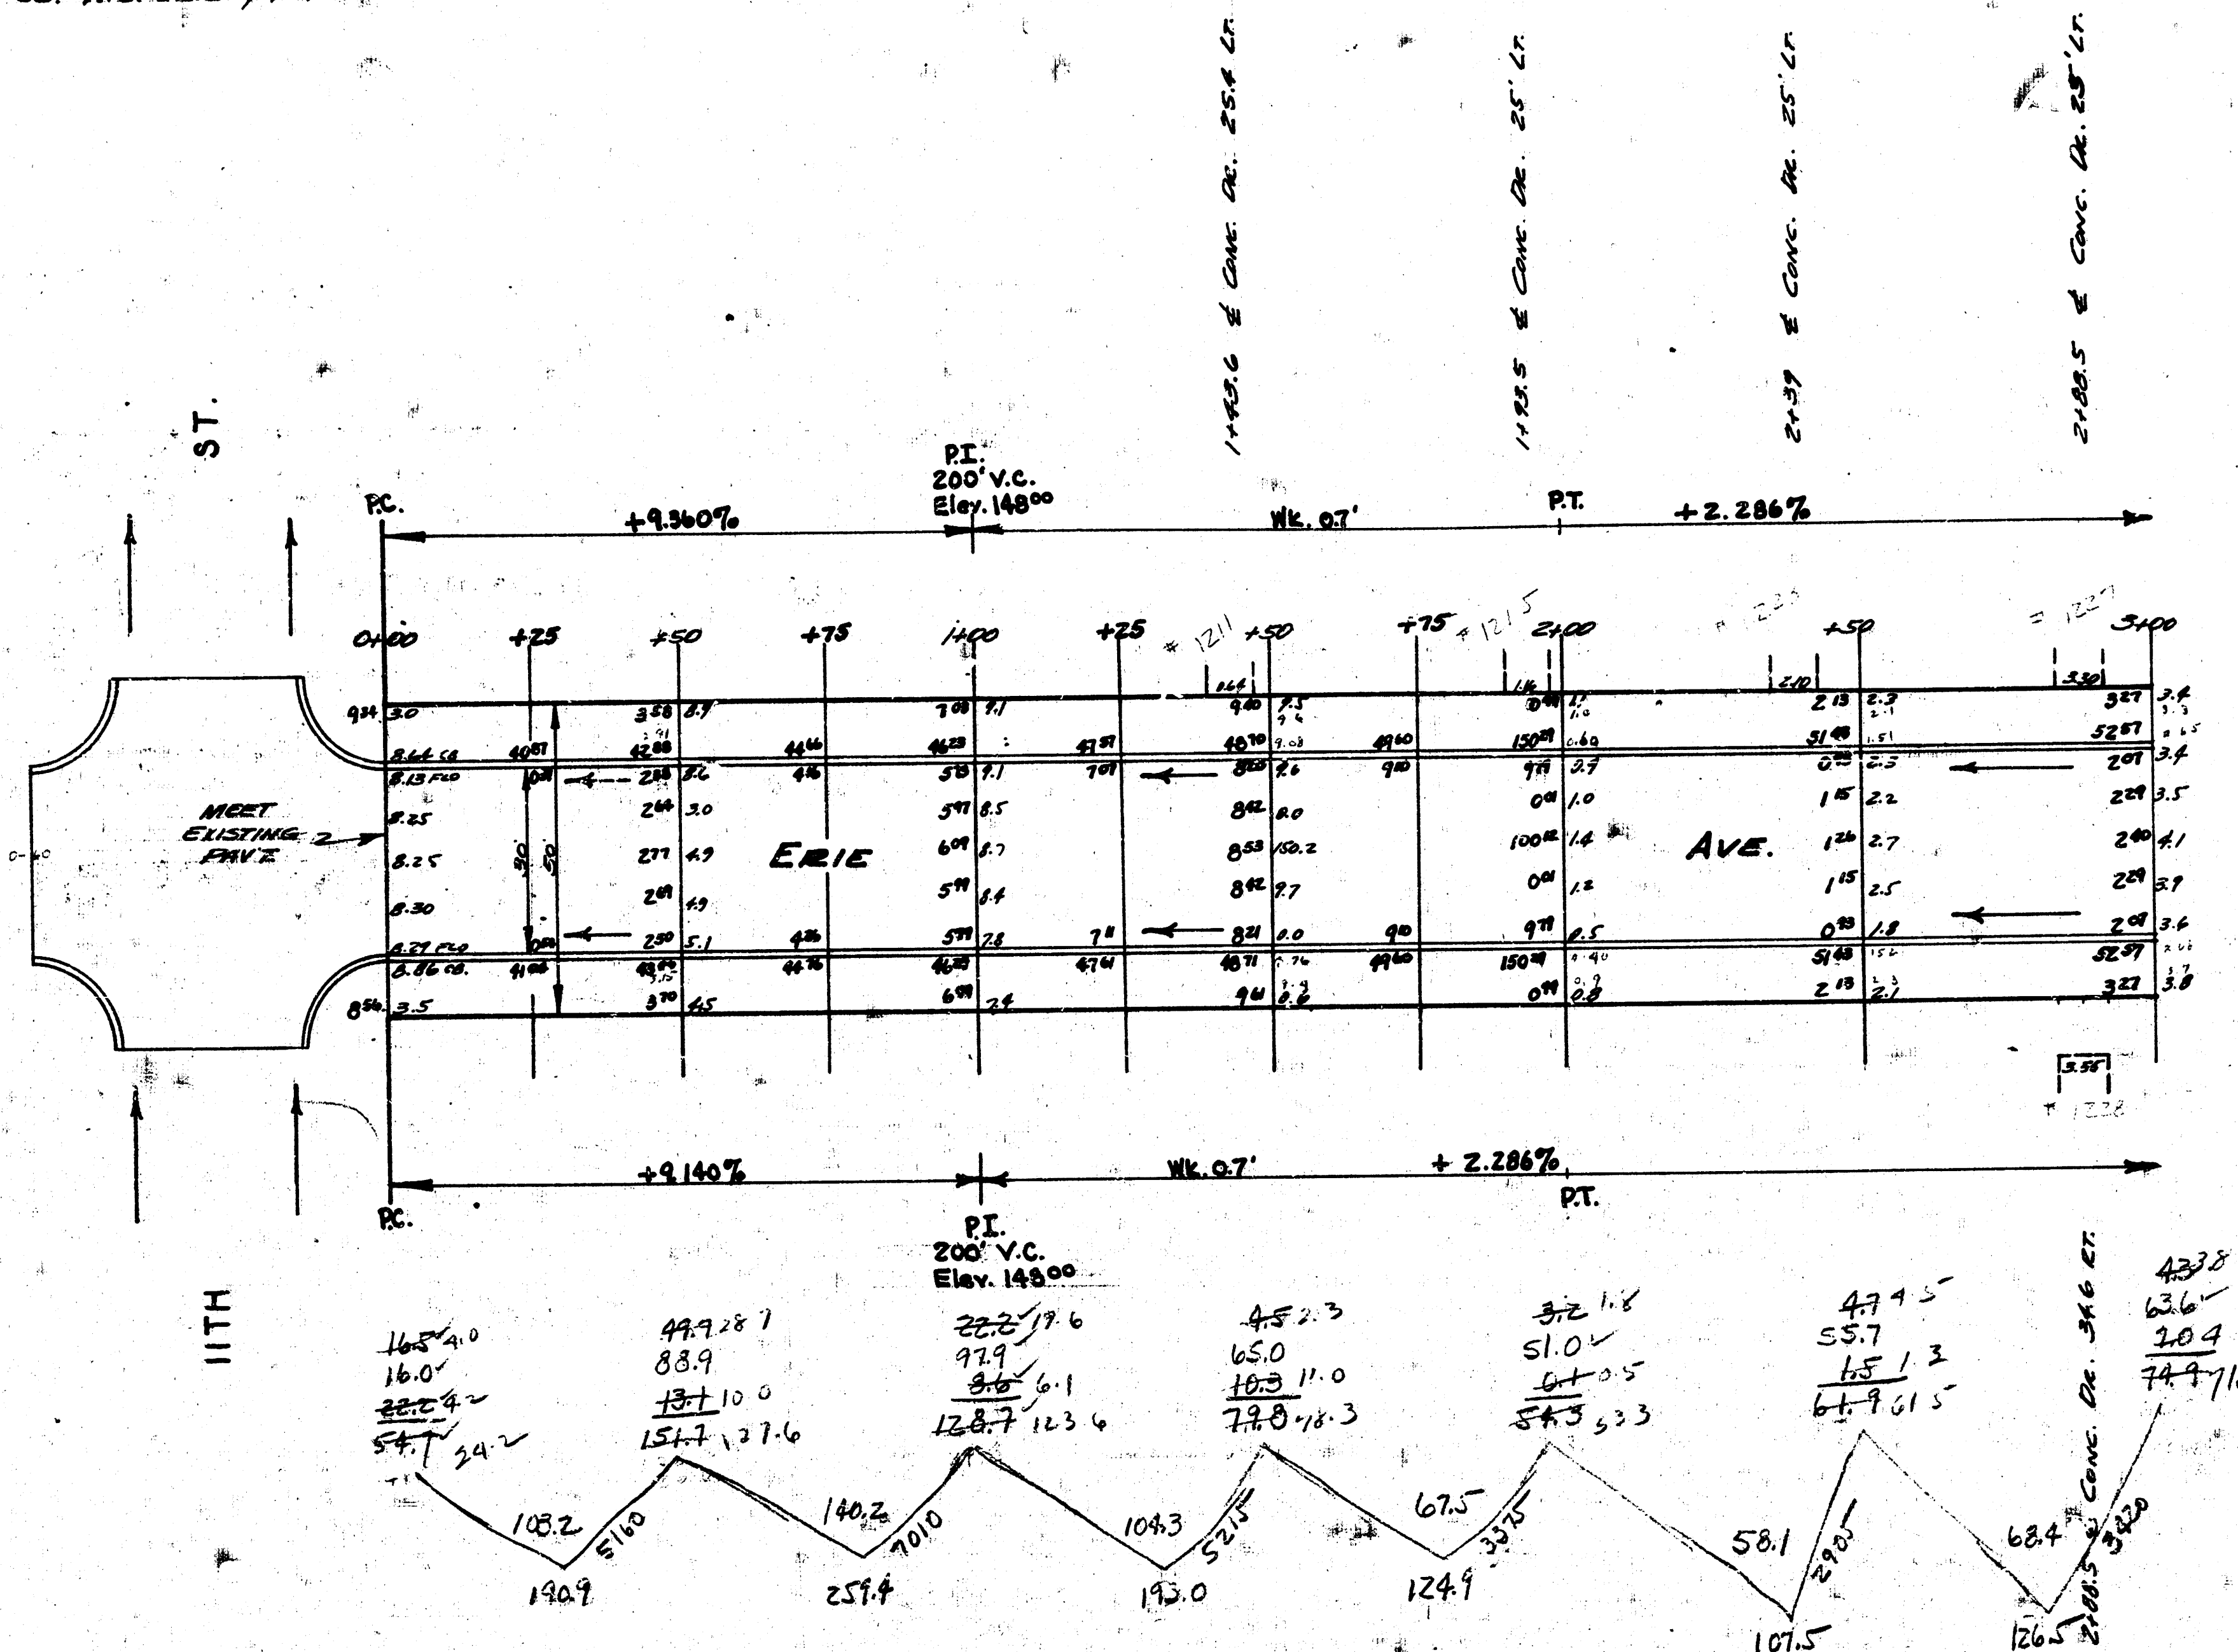


MG
K-10

B.M. 145.30 "X" ON TOP C.B. W.S. ERIE 1/4 NEAR S. END RAD. 3.14. C&G 13TH

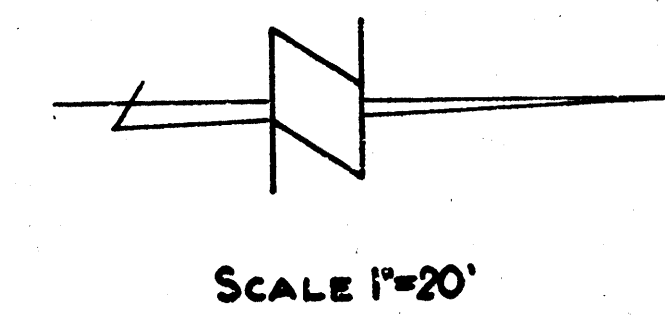


1
2

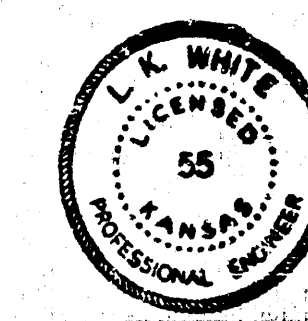

ERIE AVE.
11TH ST. TO 12TH ST.
30' Conc. & Cb.
CITY OF WICHITA, KANSAS
L.K. WHITE
OCT. 1951
CITY ENGINEER
PROJ. NO. C-11-160

B.M. 145.30 1' on top of N.E. ERIE S. End Rwy. S.W. Cor 13TH

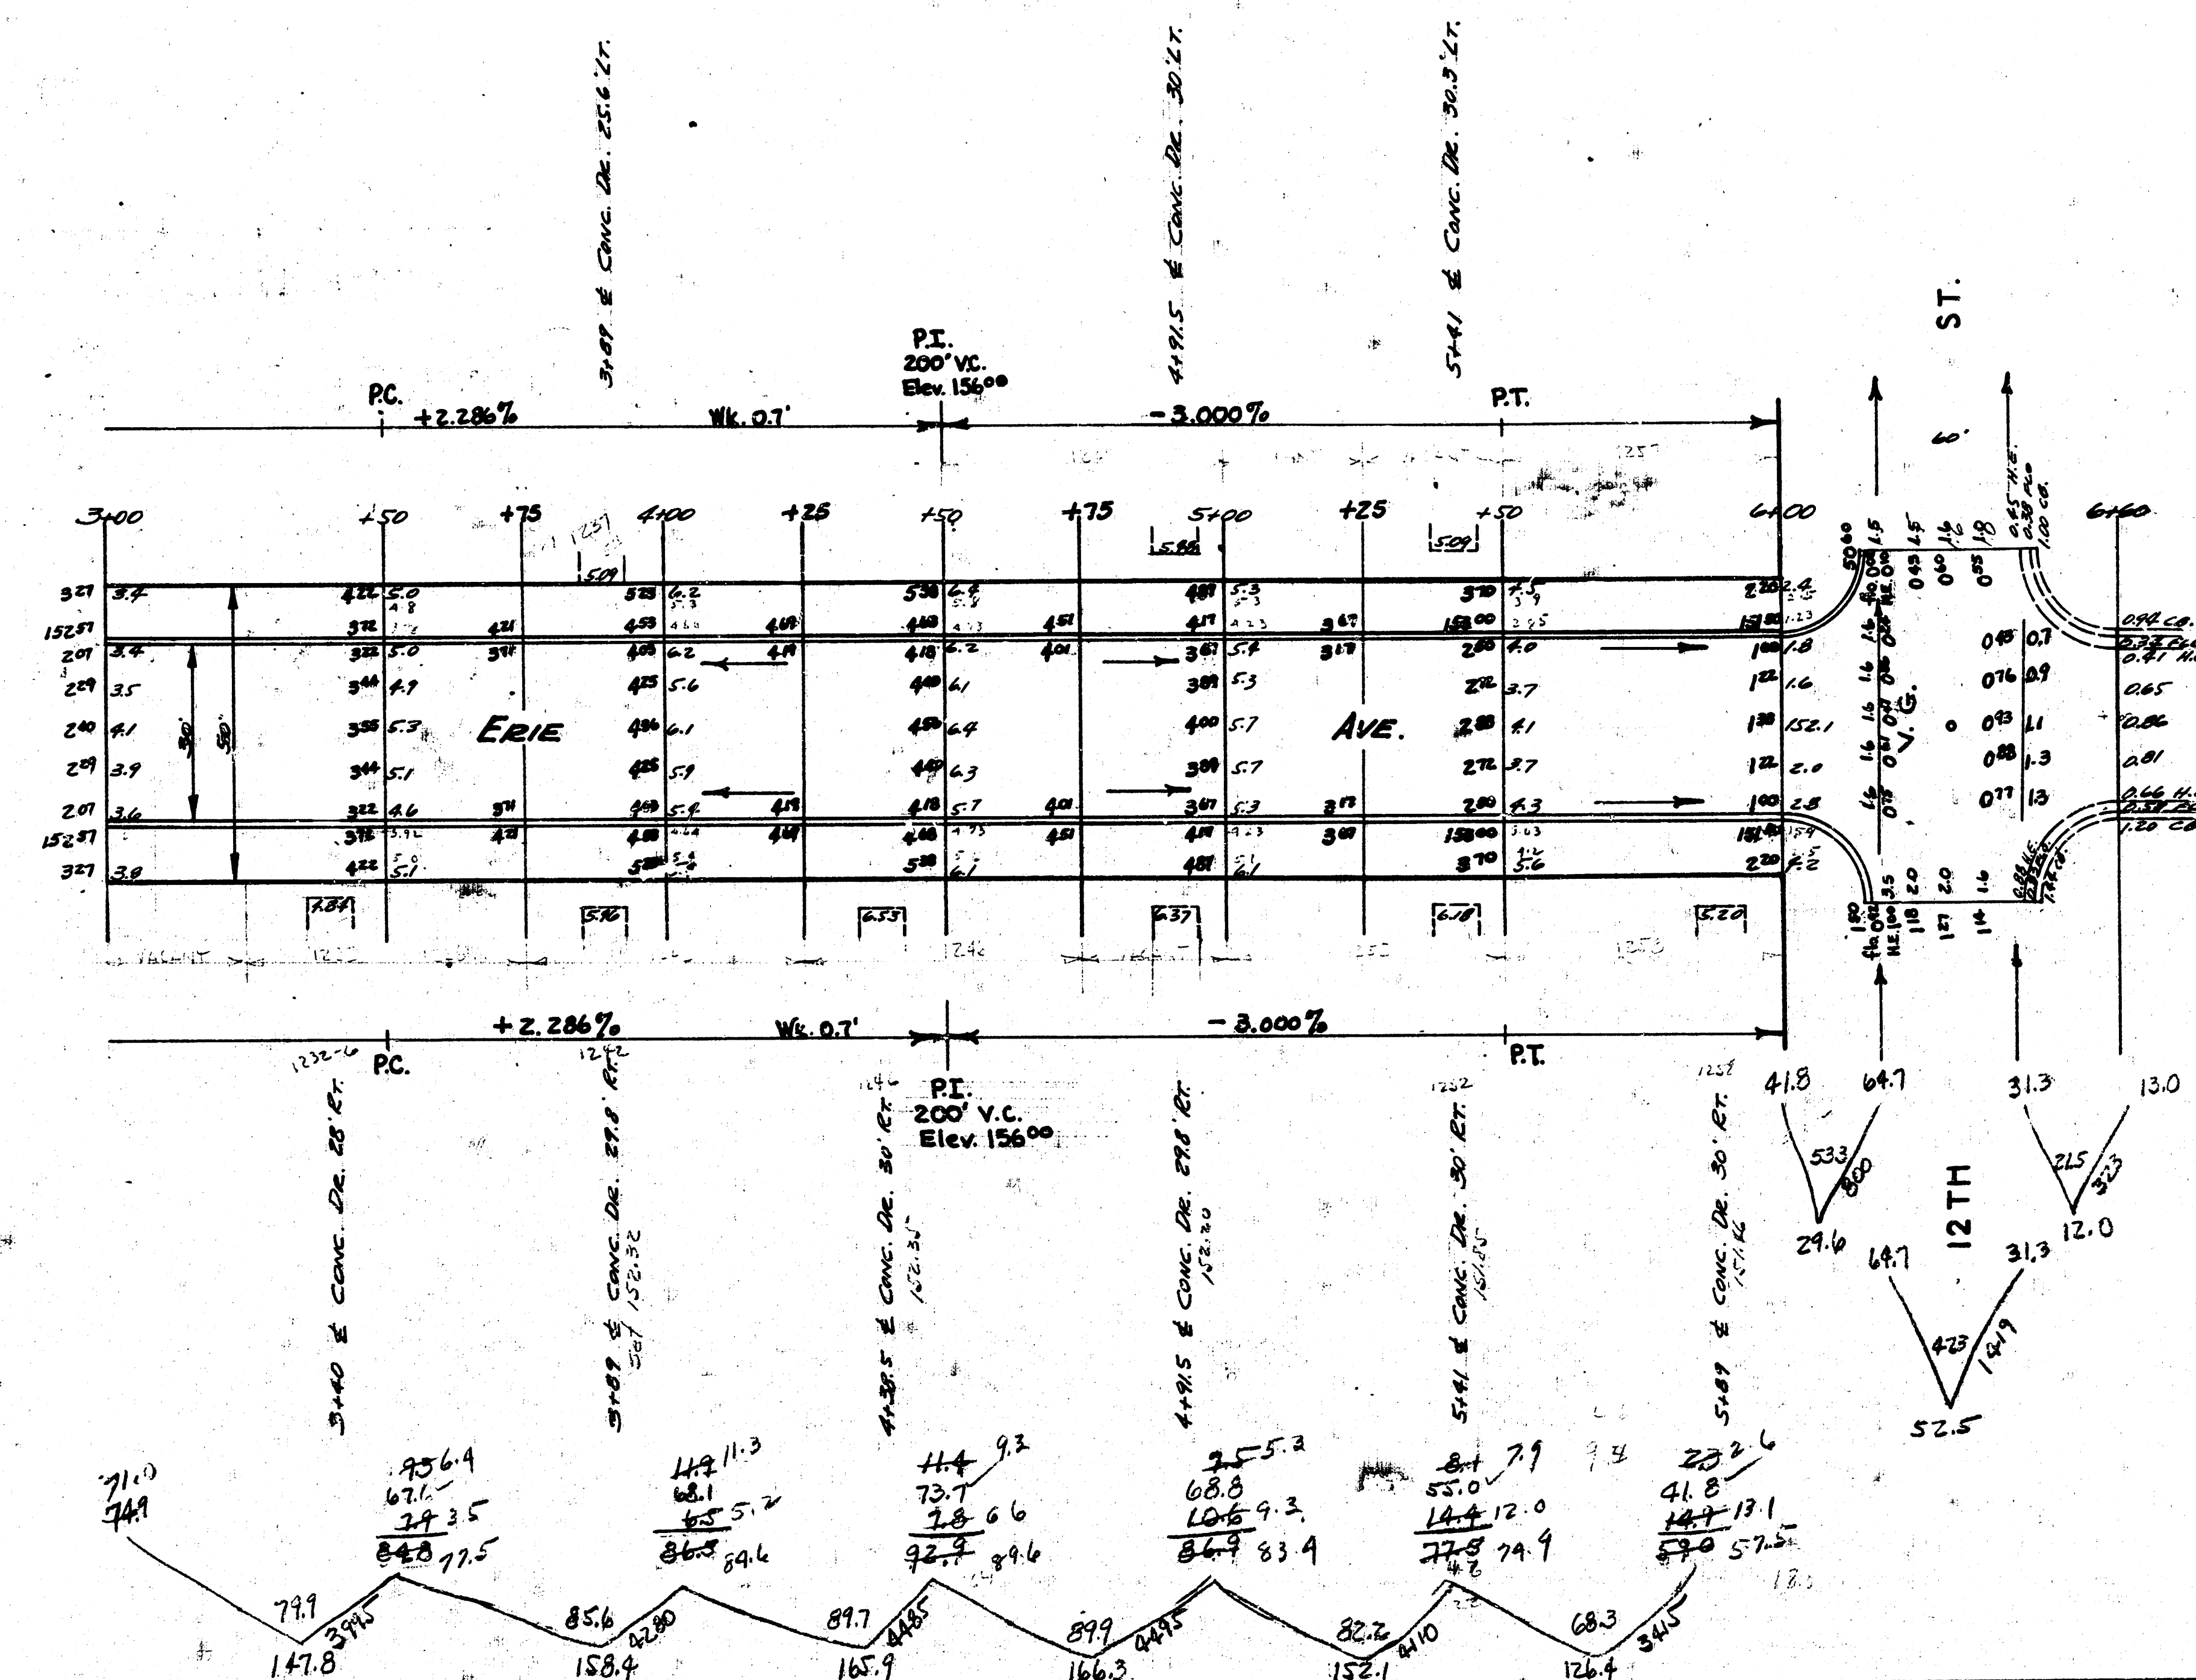

TIES TO 12TH & OF ERIE & 12TH
 72.0' S.W. TO N.E. Cor. of Hq. #2817 E. 12TH
 68.55' N.W. TO S.E. Cor. of Hq. #1301 N. ERIE
 71.0' N.E. TO S.W. Cor. of Hq. #1302 N. ERIE

EXCAVATION:

Prop.	City
190.9	29.6
259.4	12.0
193.0	52.5
124.9	94.1
107.5	9.4
126.5	
147.8	
158.4	
165.9	
166.3	
152.1	
126.4	
1919.1	
191.9	
+10%	2116.0 cu yd



2/2