
B.M. 152.826 S.E. Cor. Por. House # 2269 N. Volutsia
B.M. 166.75 S.W. Cor. Porch House # 2368 N. Erie

Chaining No. on E. R.

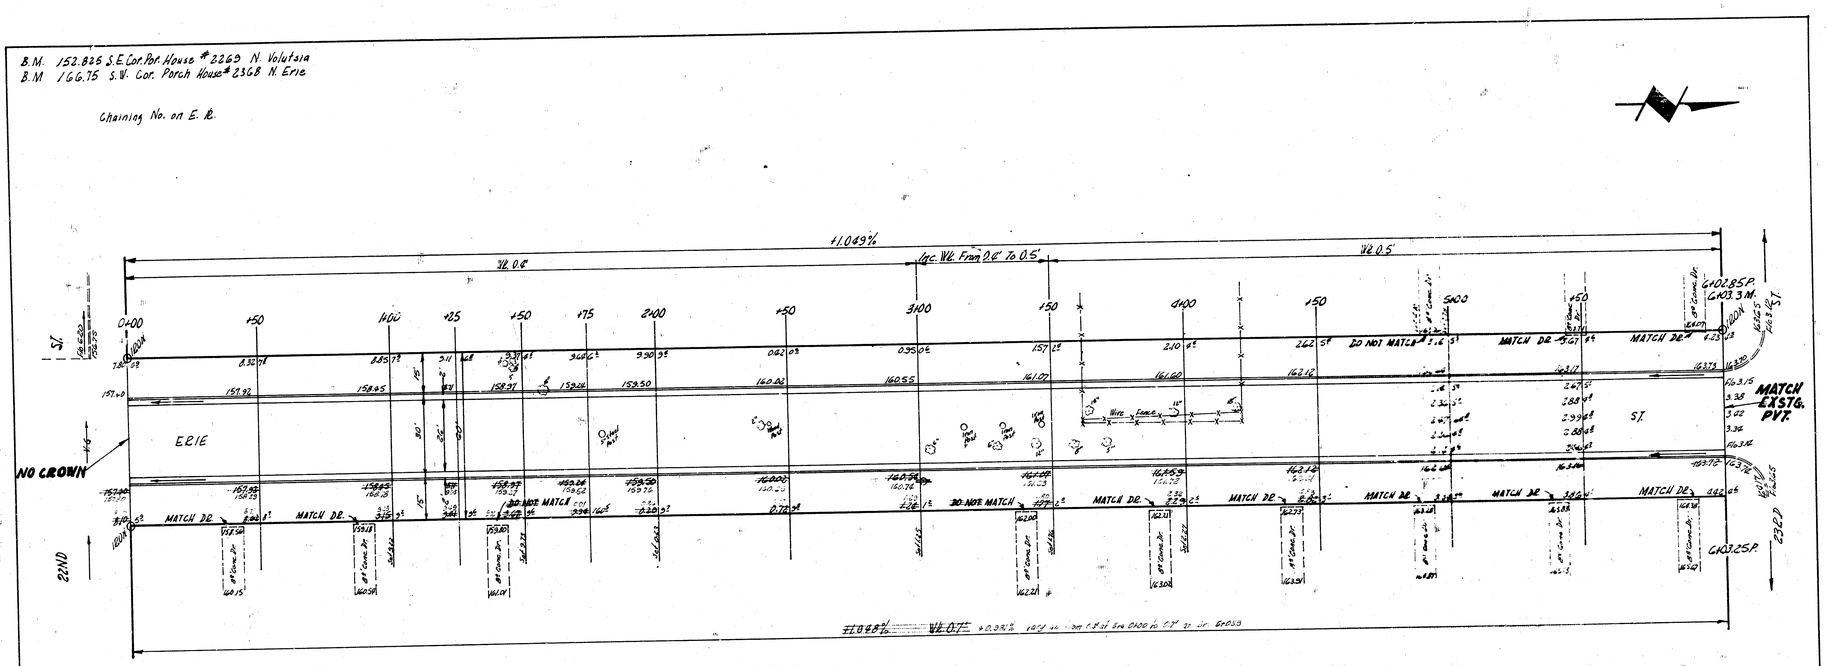

NOTE TO FIELD ENGINEER & CONTRACTOR
Re-cross section to determine amt. of loose fill to be removed & replaced with sand in draw at approx. Sta 2+00.

1/2

ERIE ST
N.L. 22ND - S.L. 23RD
20-28-30 A.C.
CITY OF WICHITA, KANS
B.E. SMITH — CITY ENGINEER
FEB., 1955 — PROJ. NO. C13-83

B.E. SMITH 436 KANSAS PROFESSIONAL ENGINEER