



B.M. 158.44 Top Iron N.E. Cor. ELLEN & ESTELLE
 NOTE: STATIONING IS ON E.P.L.

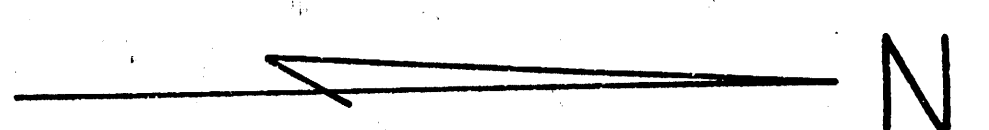

760.1
 169.4
 216.4
 220.1
 110.4
 102.6
 215.3
 210.0
 157.2
 157.8
 157.10
 1721.5 C&G.P.D.S.

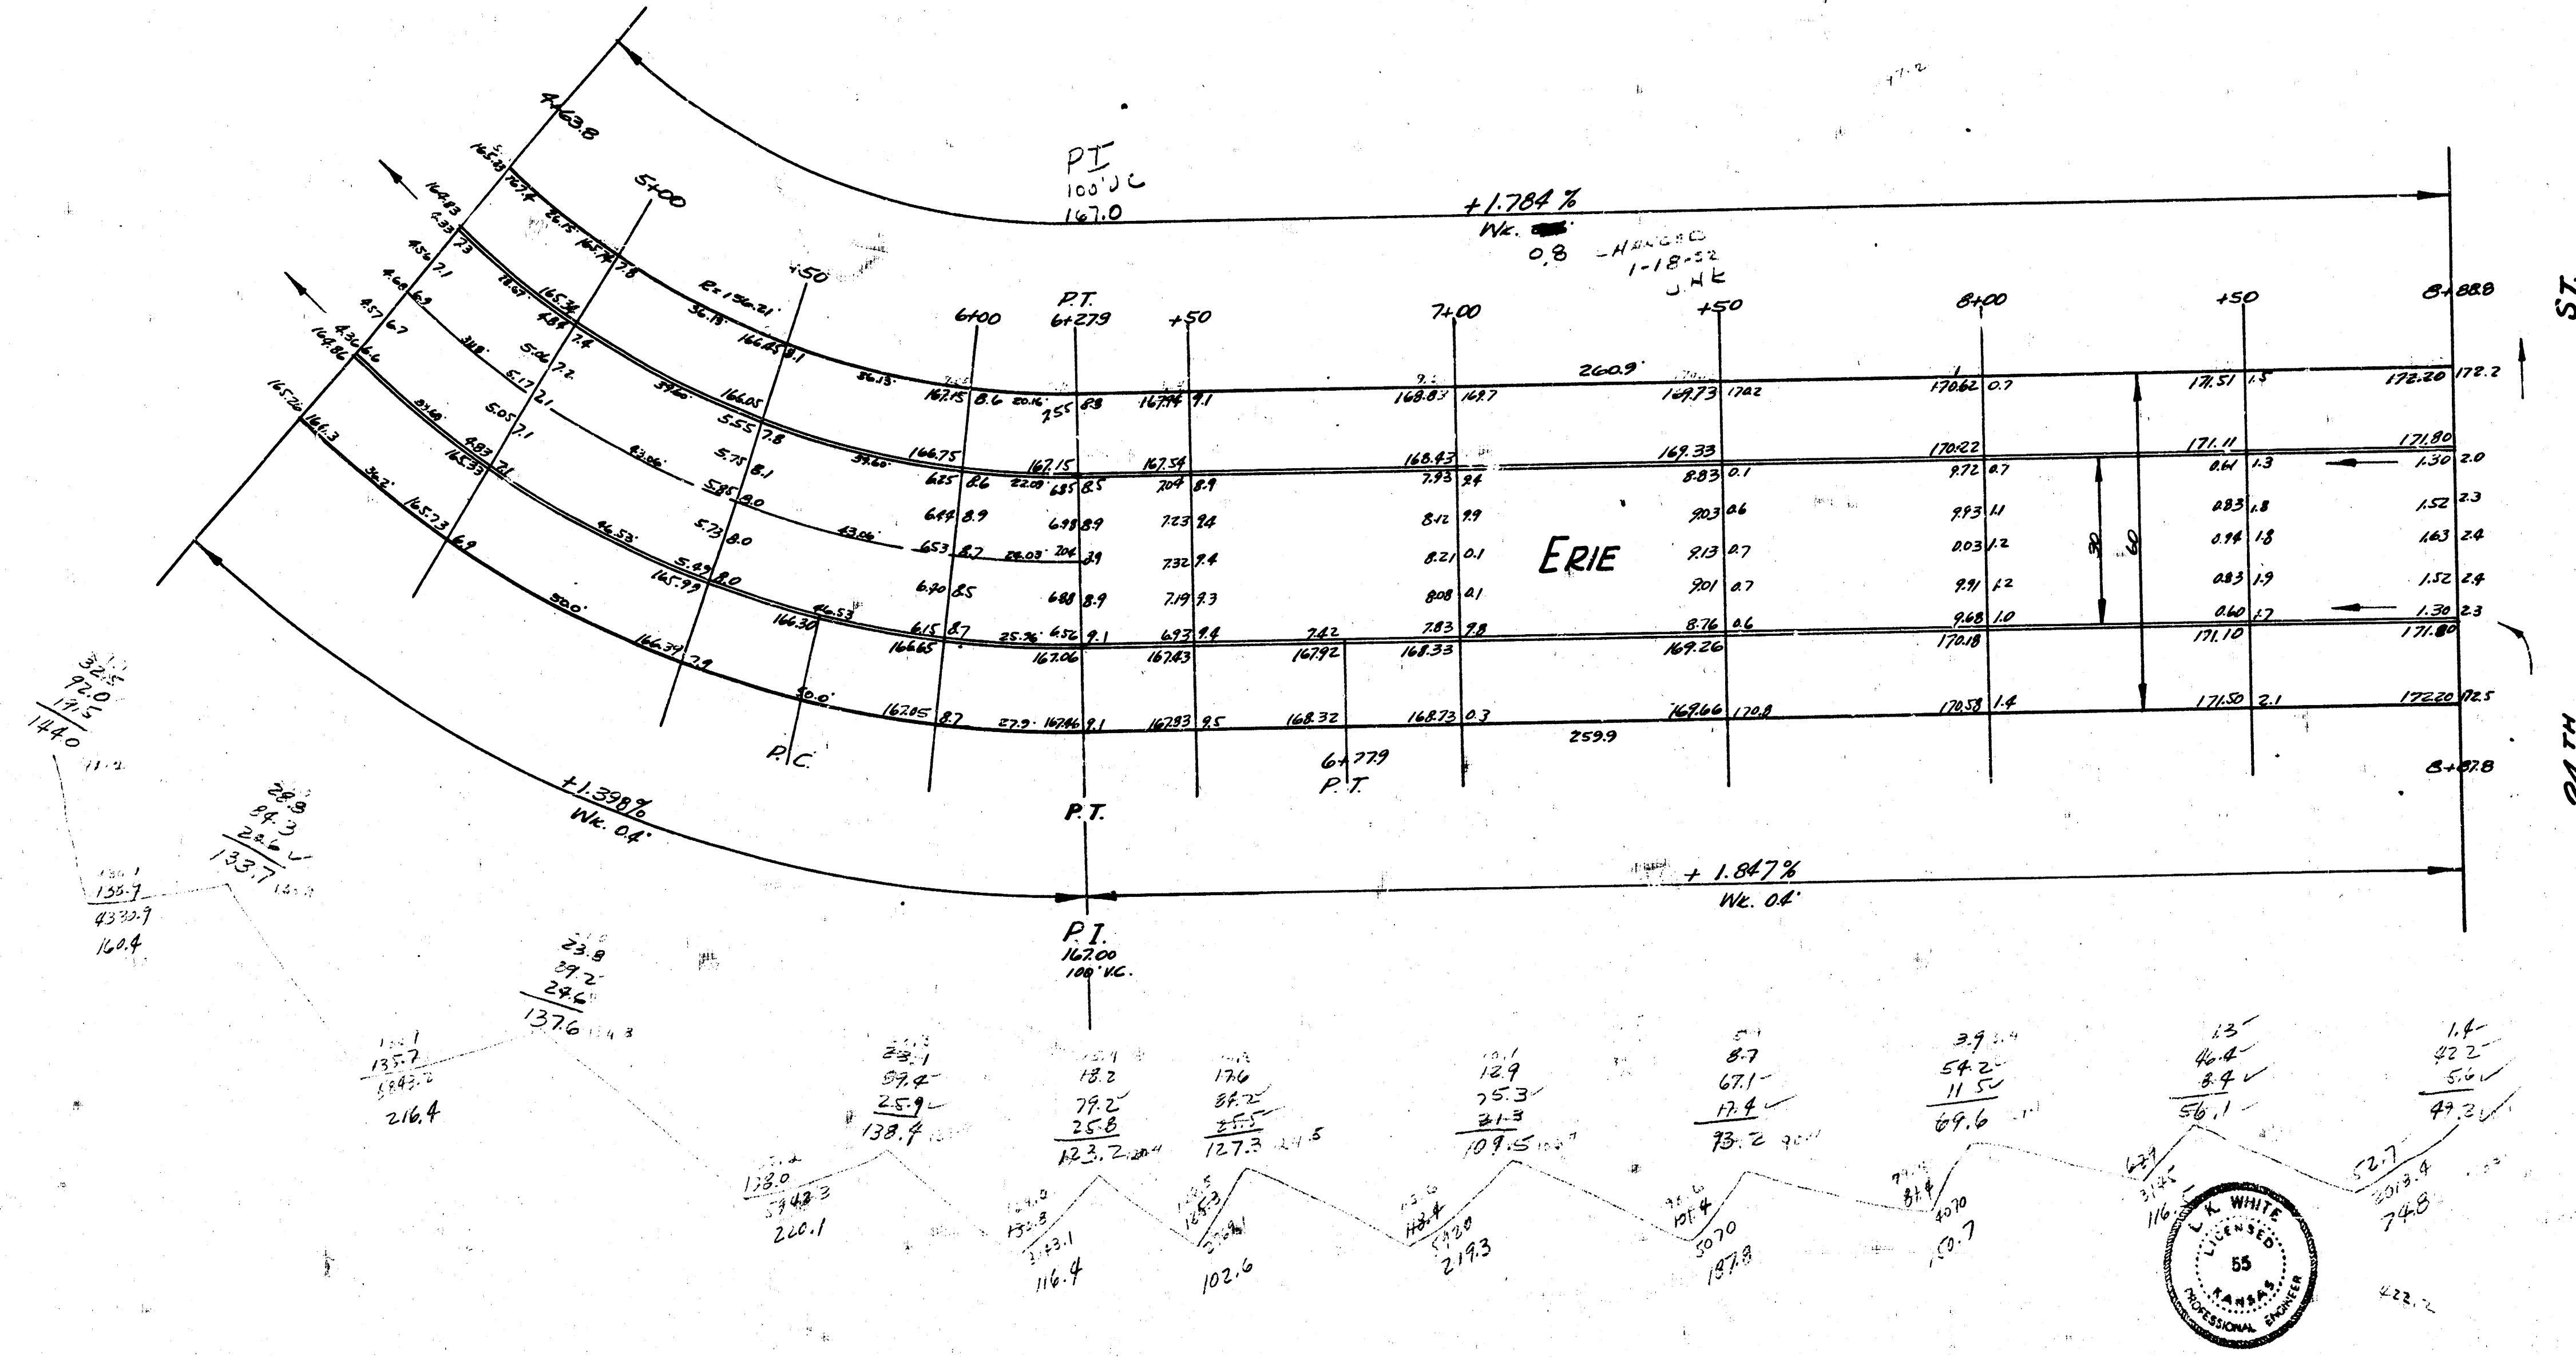

ERIE
 E.L. LOT 15, BLK. N, AUDREY MATLOCK
 HEIGHTS TO S.L. 24TH
 30' CONC. & CO.
 CITY OF WICHITA, KANSAS
 L.K. WHITE CITY ENGINEER
 SEPT. 1951 PROJ. C11-93

