26-2-30 Conc.

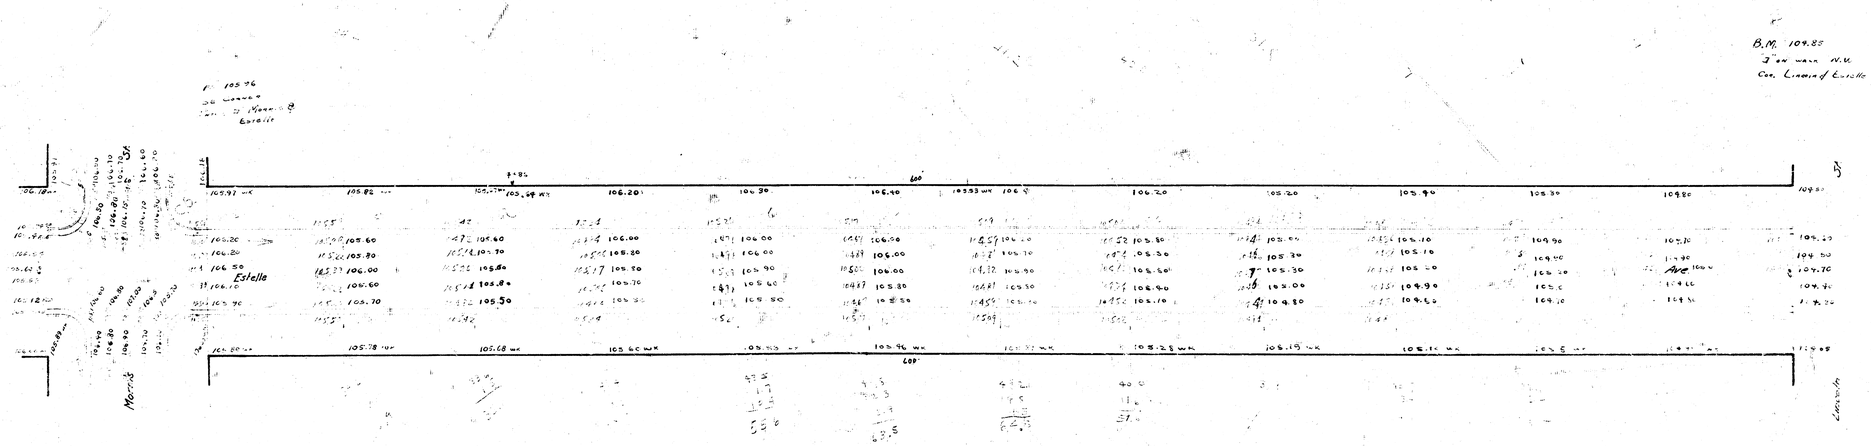
B.M. 104.85
Iron wax N.W.
Cor. Lincoln & Estelle
Estelle
Morris
Lincoln
Ave