



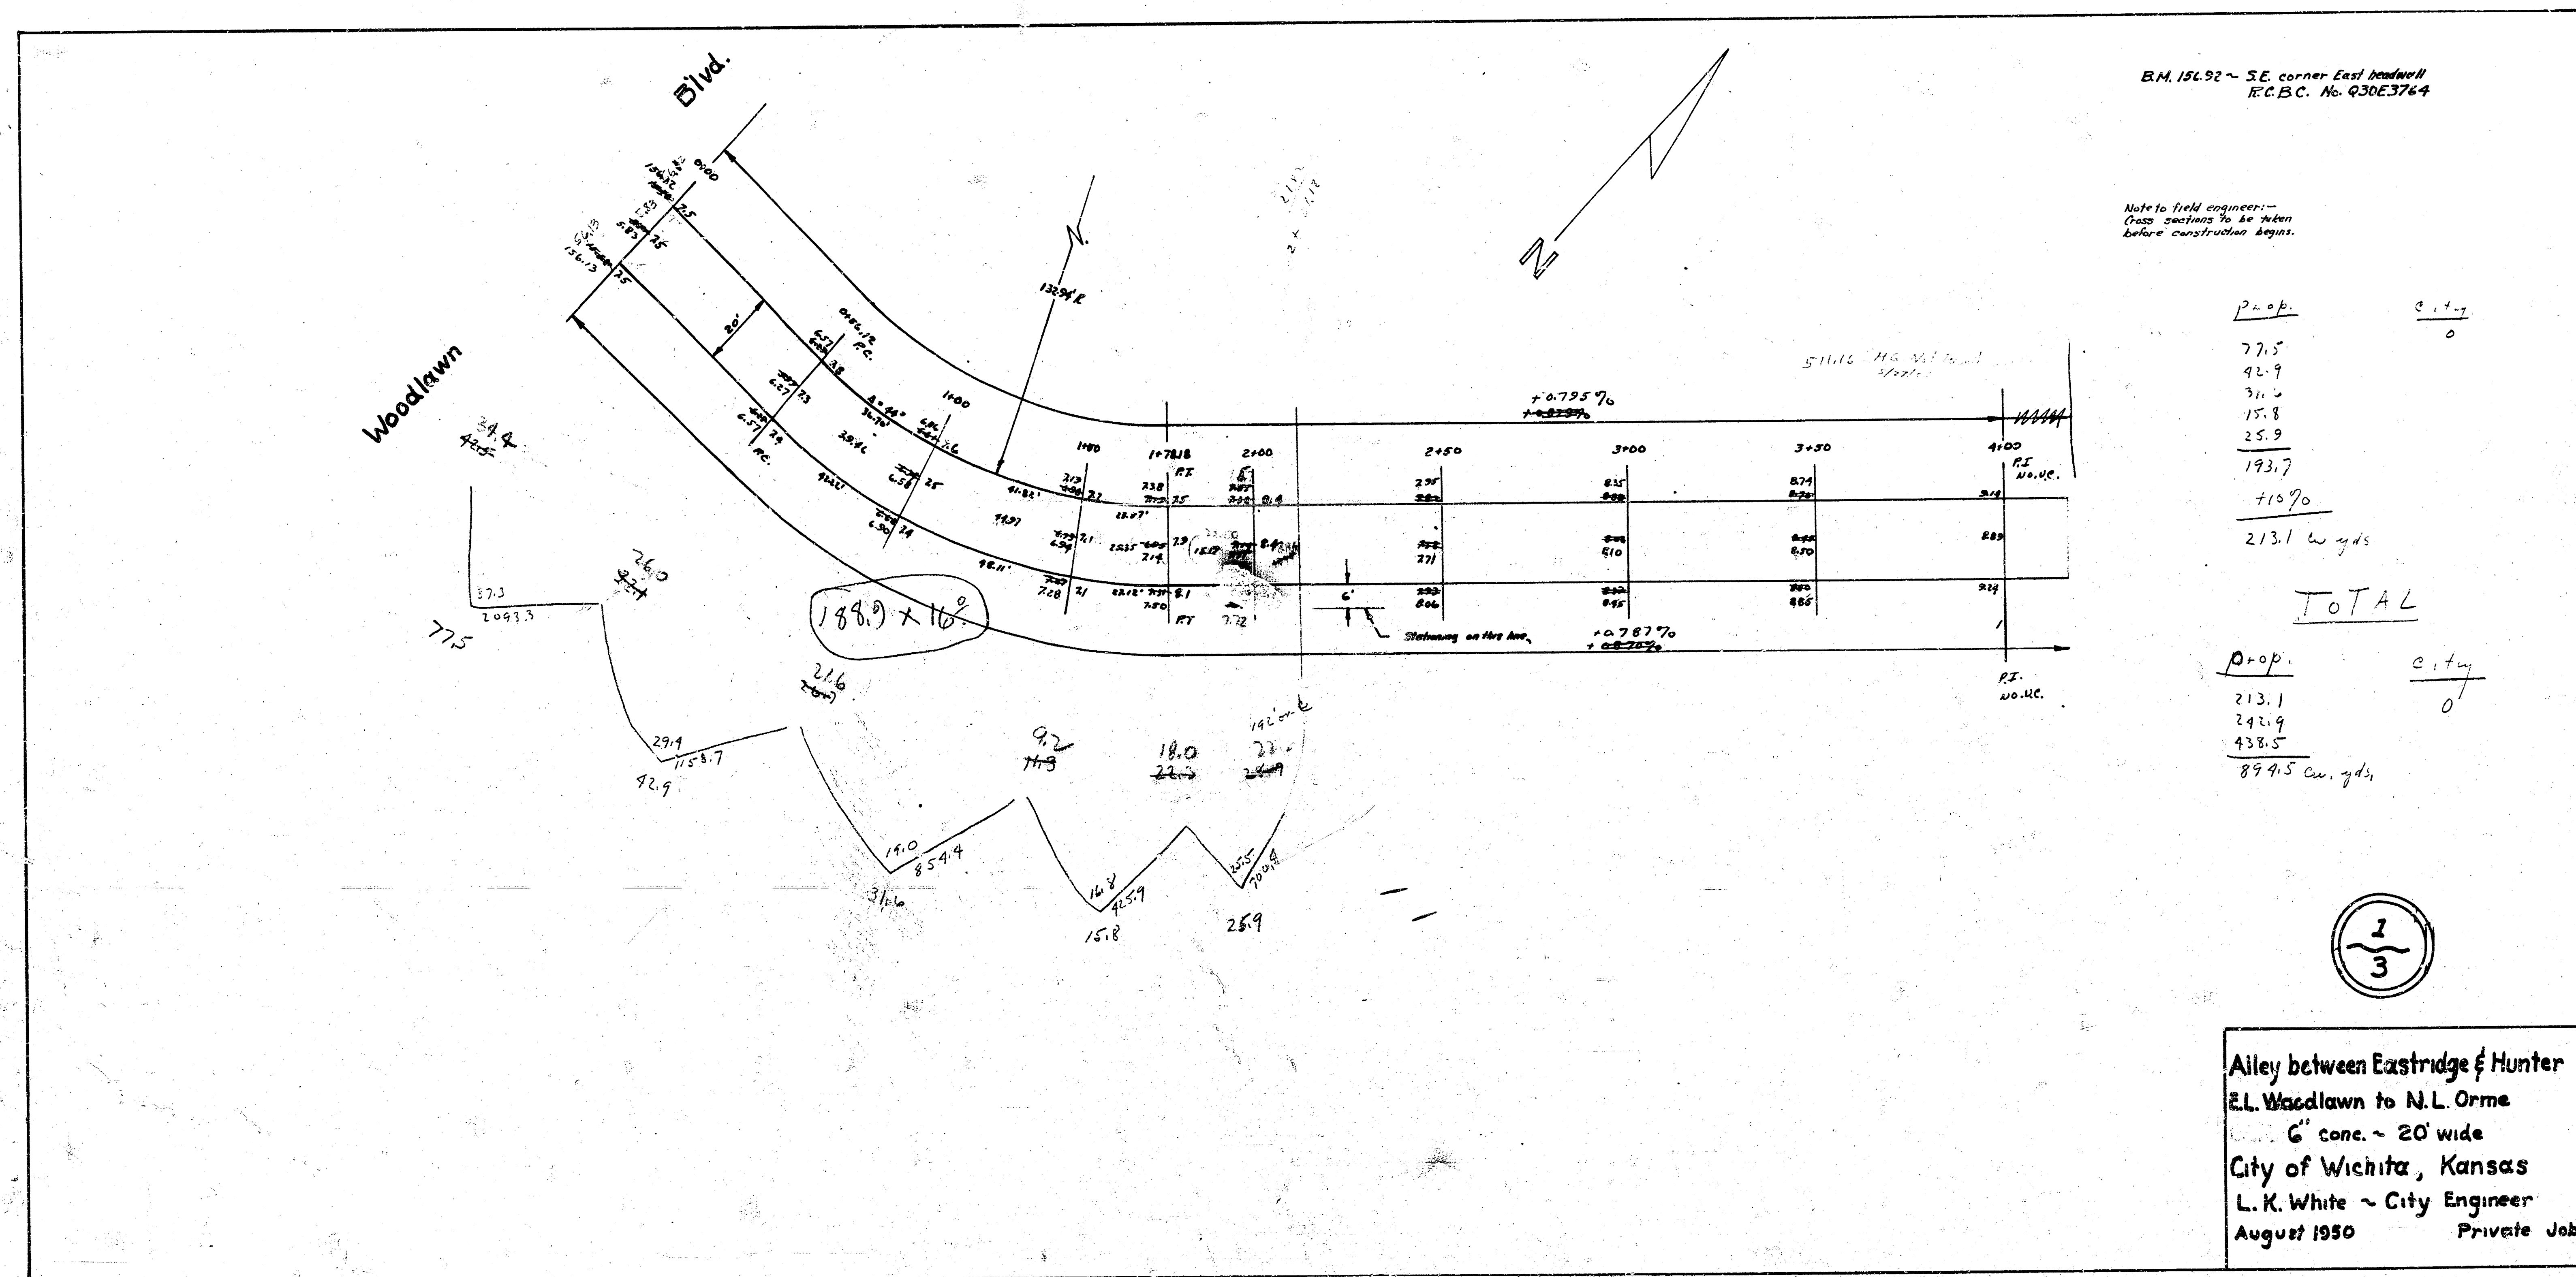

Note to field engineer:-
Cross sections to be taken before
construction begins.

B.M. 15632 ~ S.E. corner East headwall R.C.B.C. No. 63053764

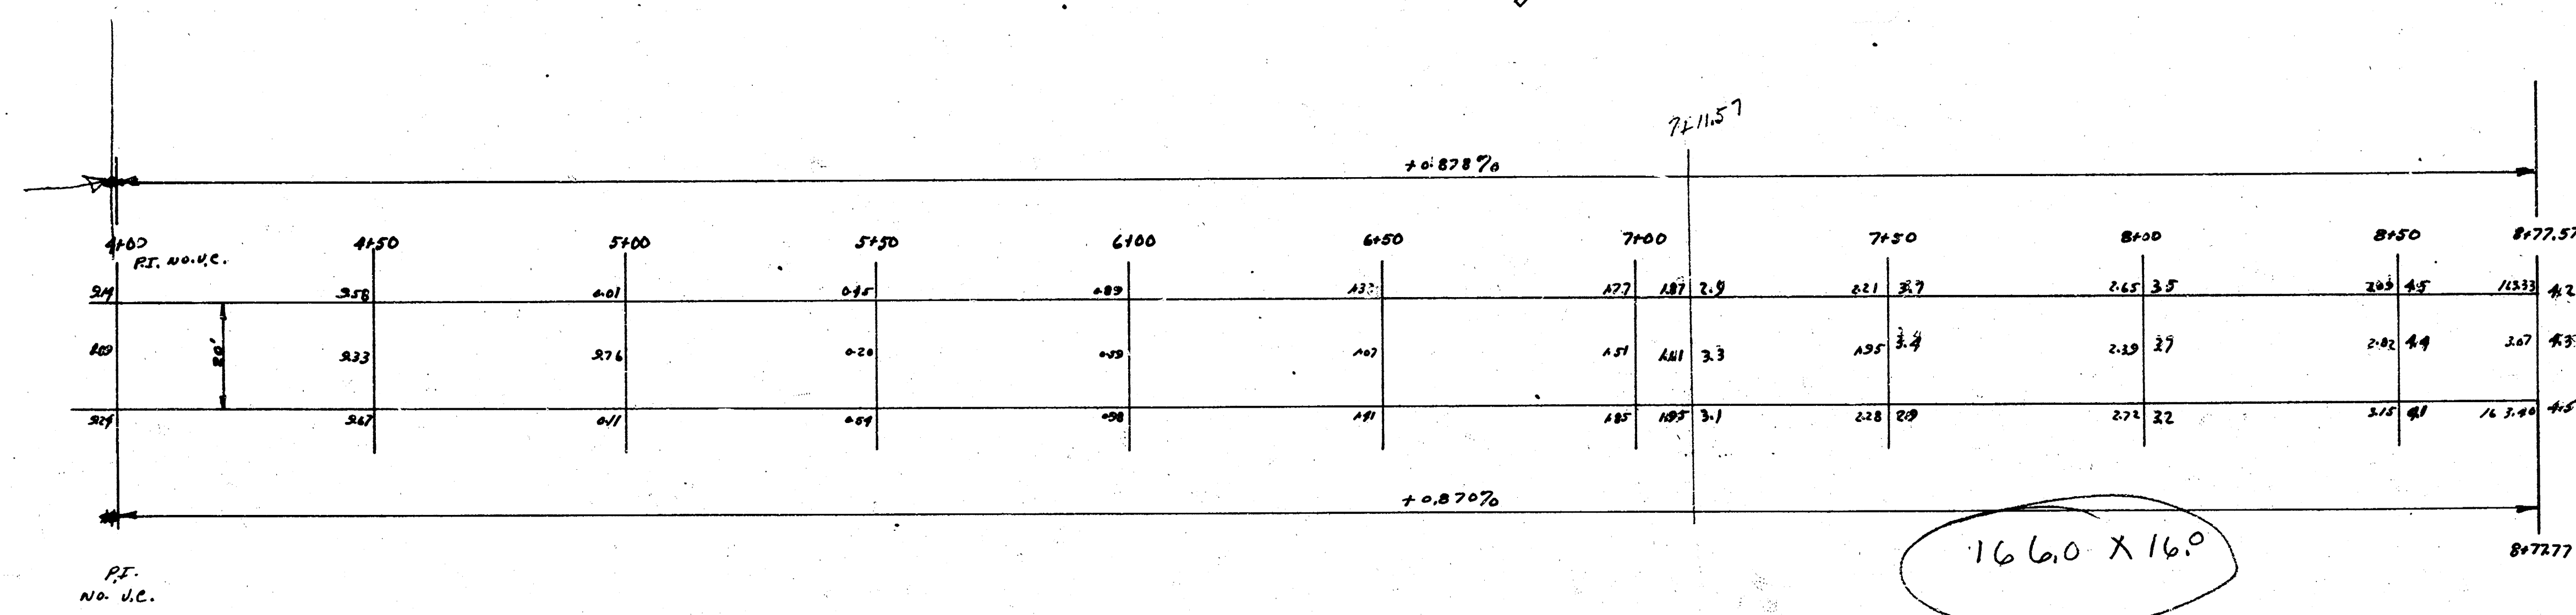


Drive

Cottonwood

166.0 X 16.0

220.8
+10.0
230.8

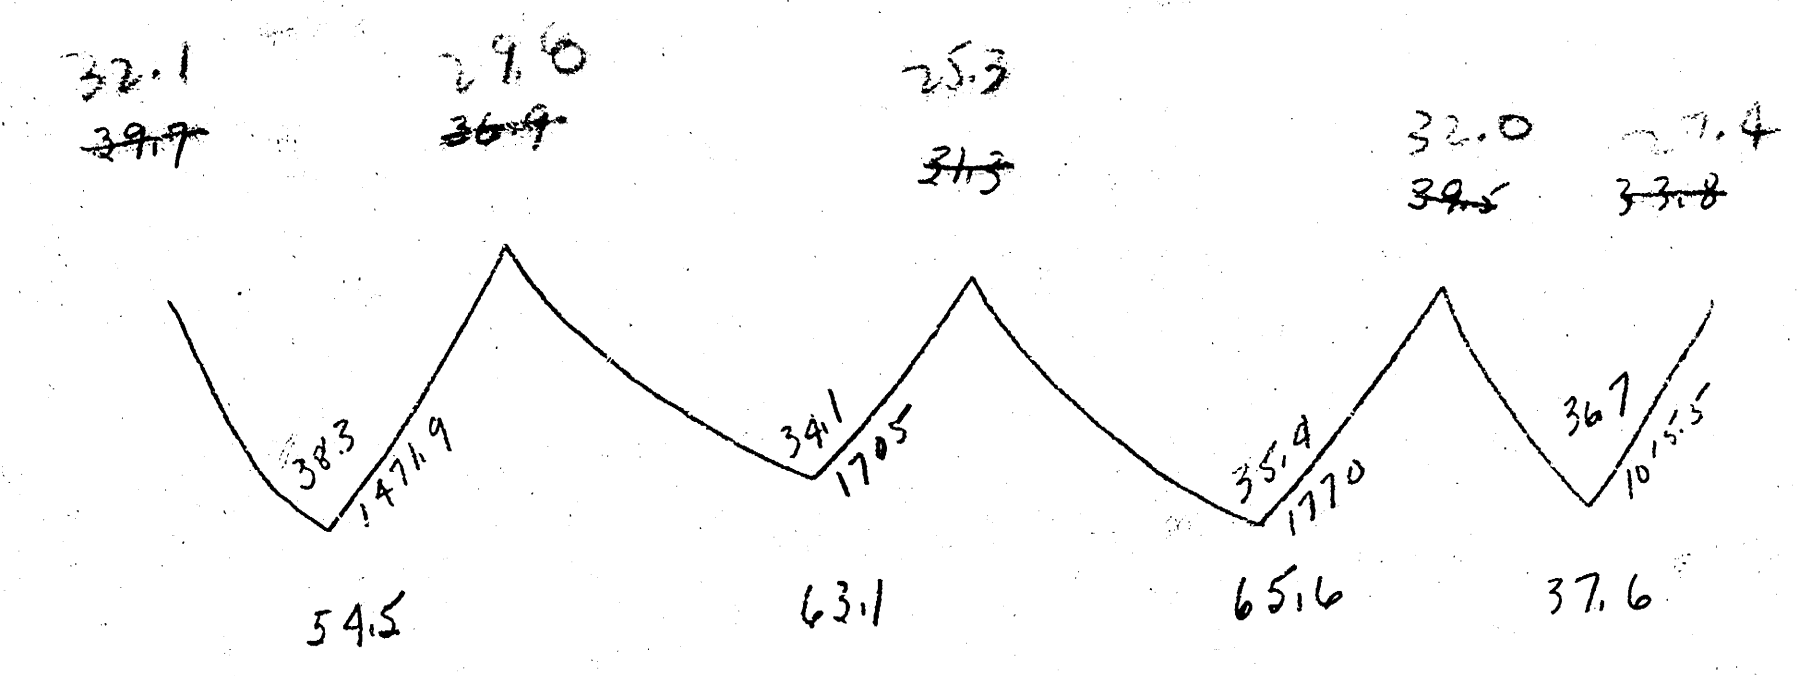

2
3

