


Alley W. of Market
St. Central ~ 350' South

Cross-section of alloy


Scale: $\frac{1}{2}'' = 1'-0''$

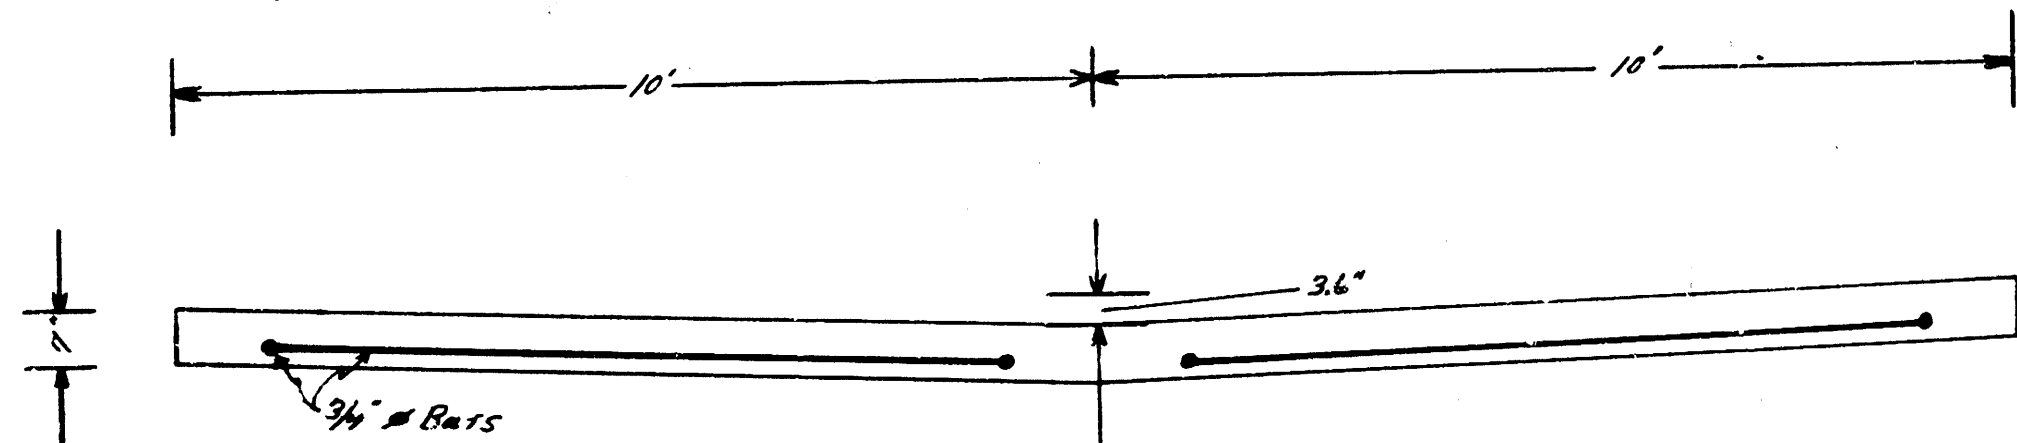

Planview showing steel for $\frac{1}{2}$ of alley


30-

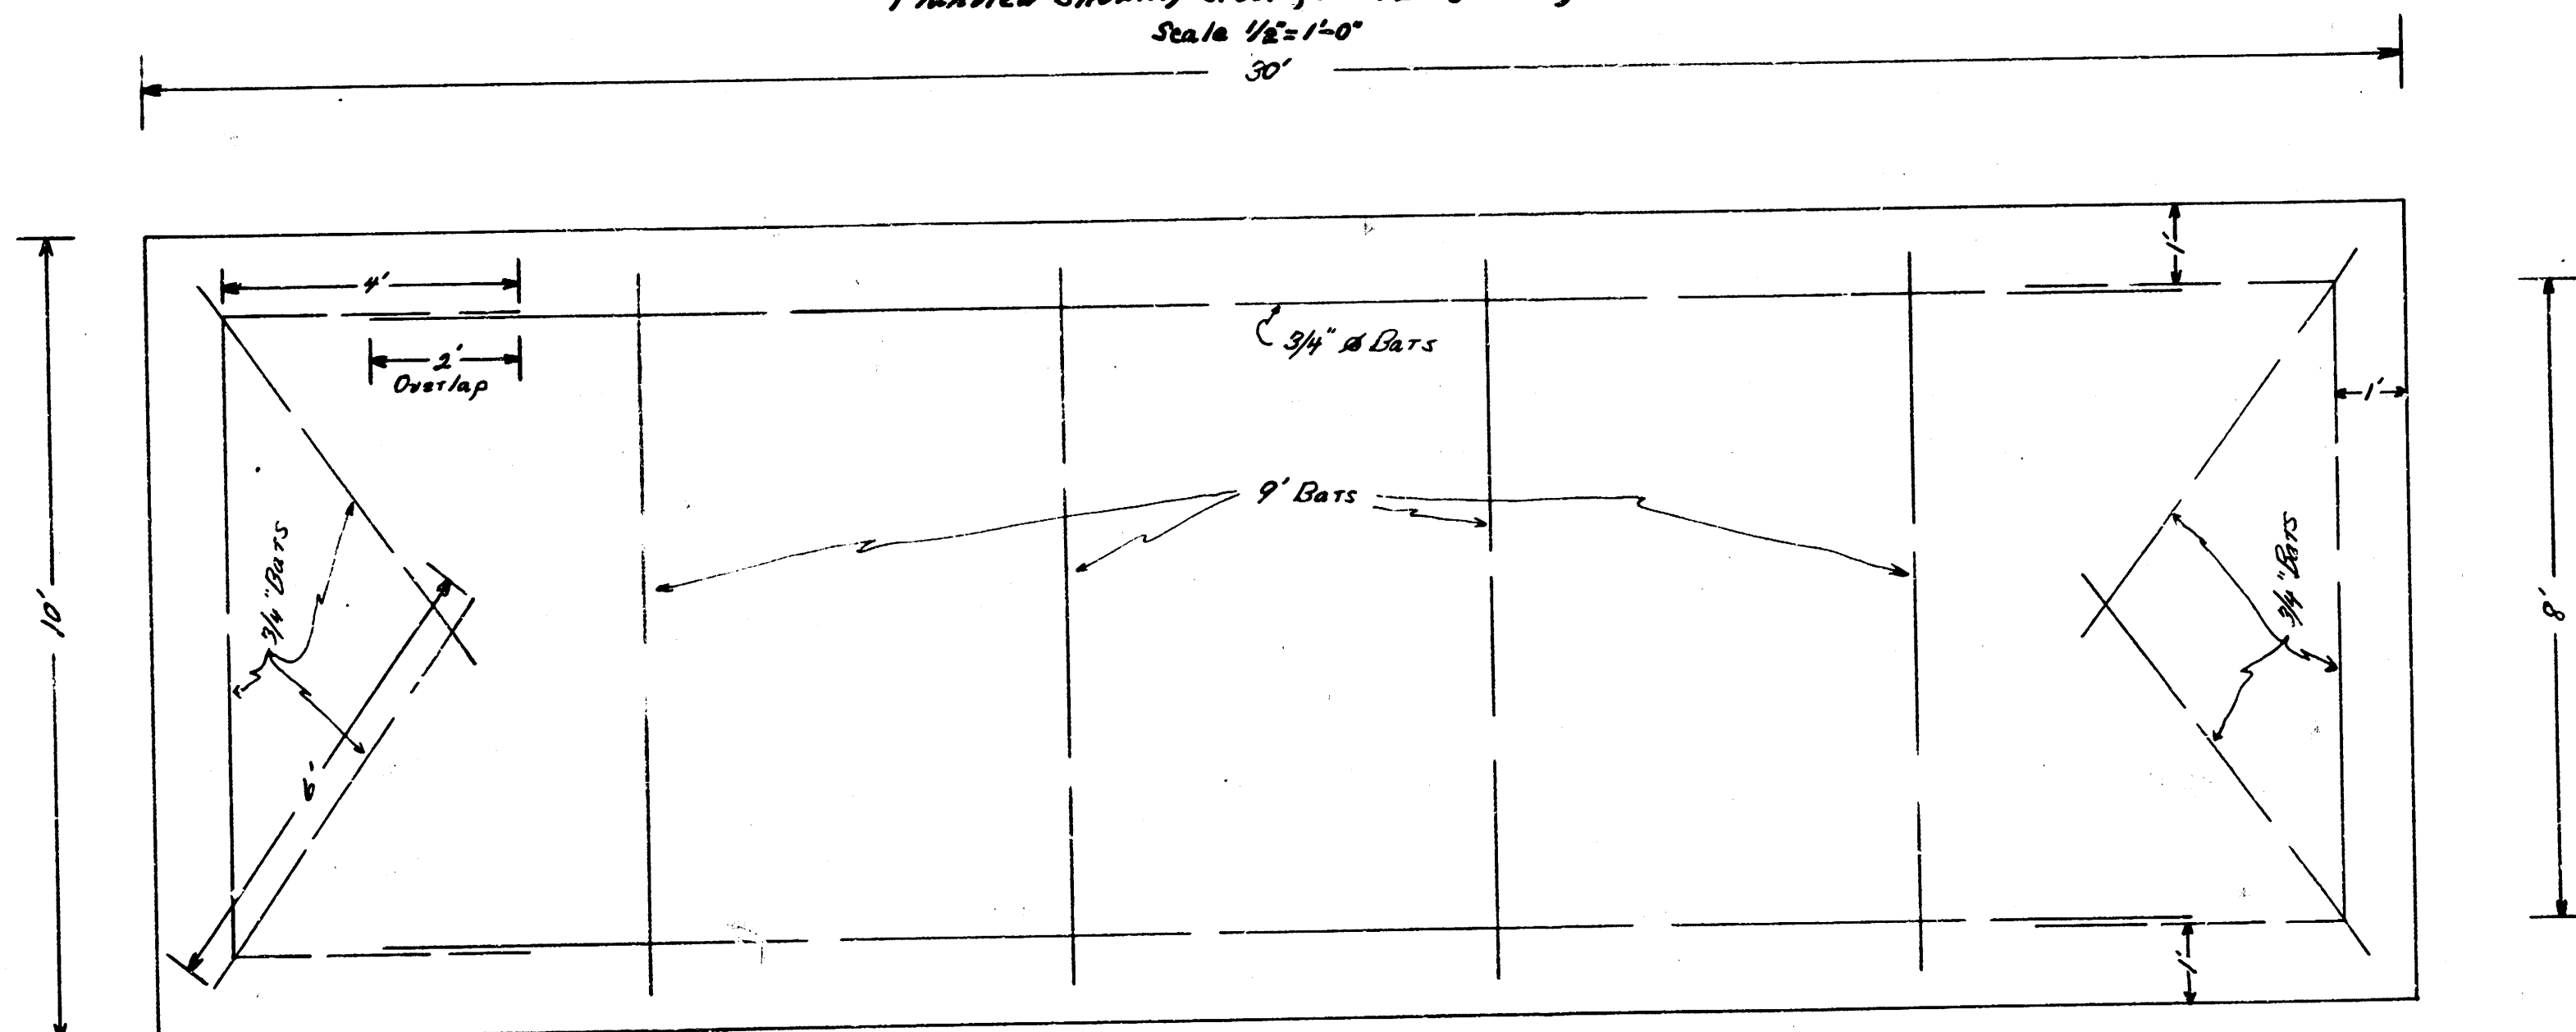

Note: Alley to be paved in two, ten foot sections.

BM. 112.13 Iron in Humble, E. Market - NS. Central
 B.M. 115.25 " on Conc. Casing, W. Alley - N.E. P.R. Property

Revised Plan
 7/7/50

use New Grades
 for Paving

350' 00"

1150' 00"

1100' 00"

0+00

AVE

CENTRAL

112.52
Alley bet. Main & Market, Central South 350'
20' Conc.
BM Elev. 112.14 Thim. No Side Central E. of Market.

