


ALLEY

BETWEEN MOSLEY AVE. & WASHINGTON AVE.
FROM N.L. 11th ST. TO S.L. 12th ST.

CITY OF WICHITA, KANSAS

R.W. BRUGGEMAN DIRECTOR OF ENGINEERING /CITY ENGINEER

PROJ. NO. 472 76 245 80907 000 000 001

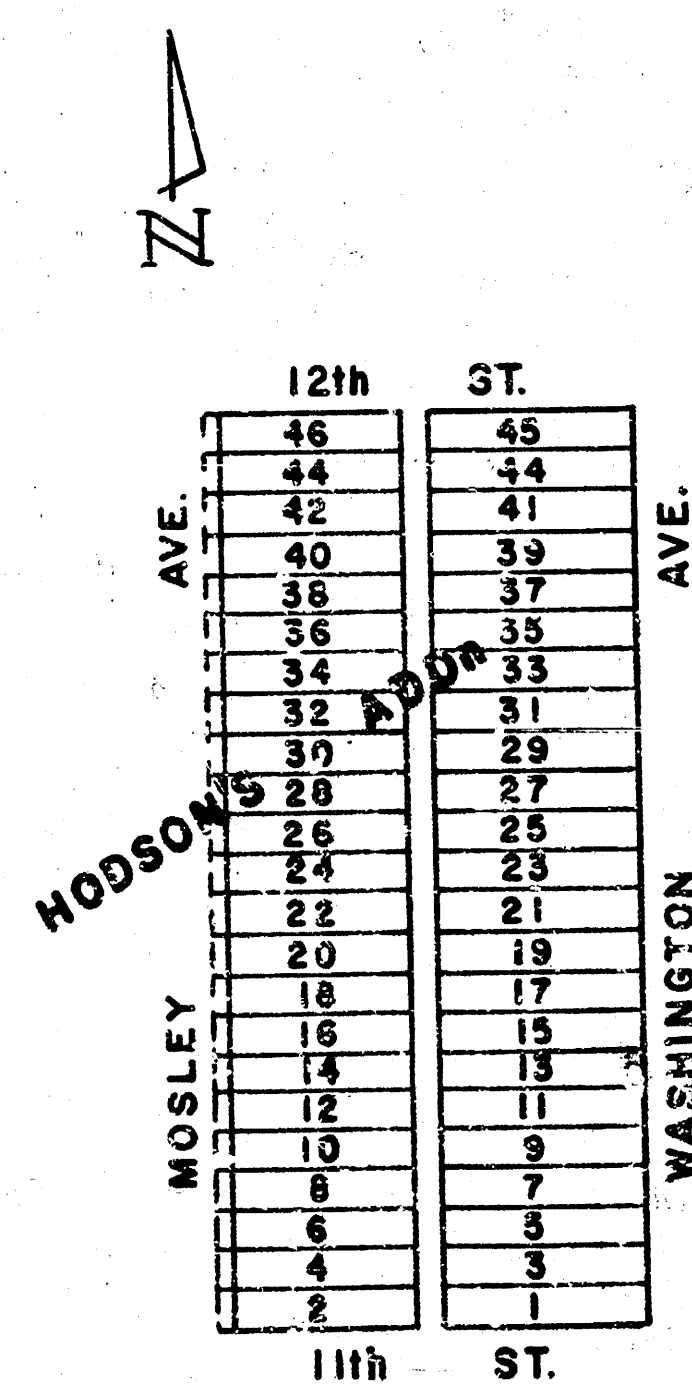


LOCATION MAP
SCALE: 1" = 150'

1/3

1/3

N 
Scale: 1" = 20'

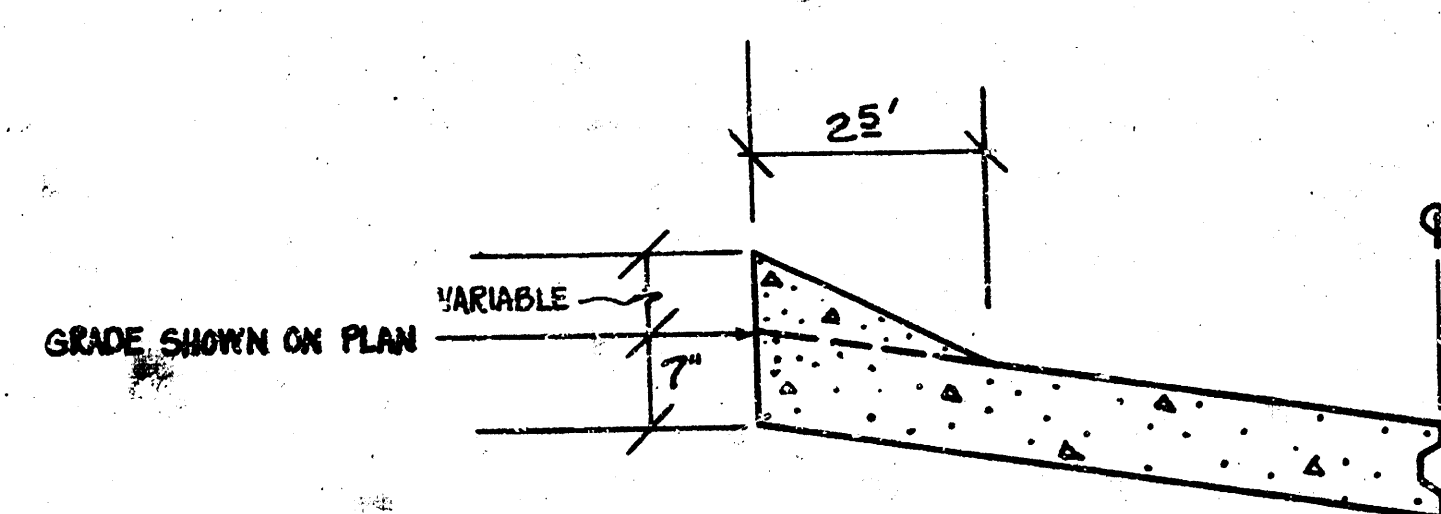

THICKENED PAVEMENT TO BE USED
ON THE OUTSIDE 2.5 FEET TO MATCH
EXISTING PARKING LOTS.
(COST INCIDENTAL TO 7" REINF. PAVMT)



*All Reinforcing Steel to be No. 6
Bars Except Dowel Bars*

15'-0"

3'-0"


Koued Joint

#2 bors-3'-0" long

$\frac{2}{3}$


PROJ. NO. 472 76 245 80907 000 000 001

$$\frac{2}{2}$$

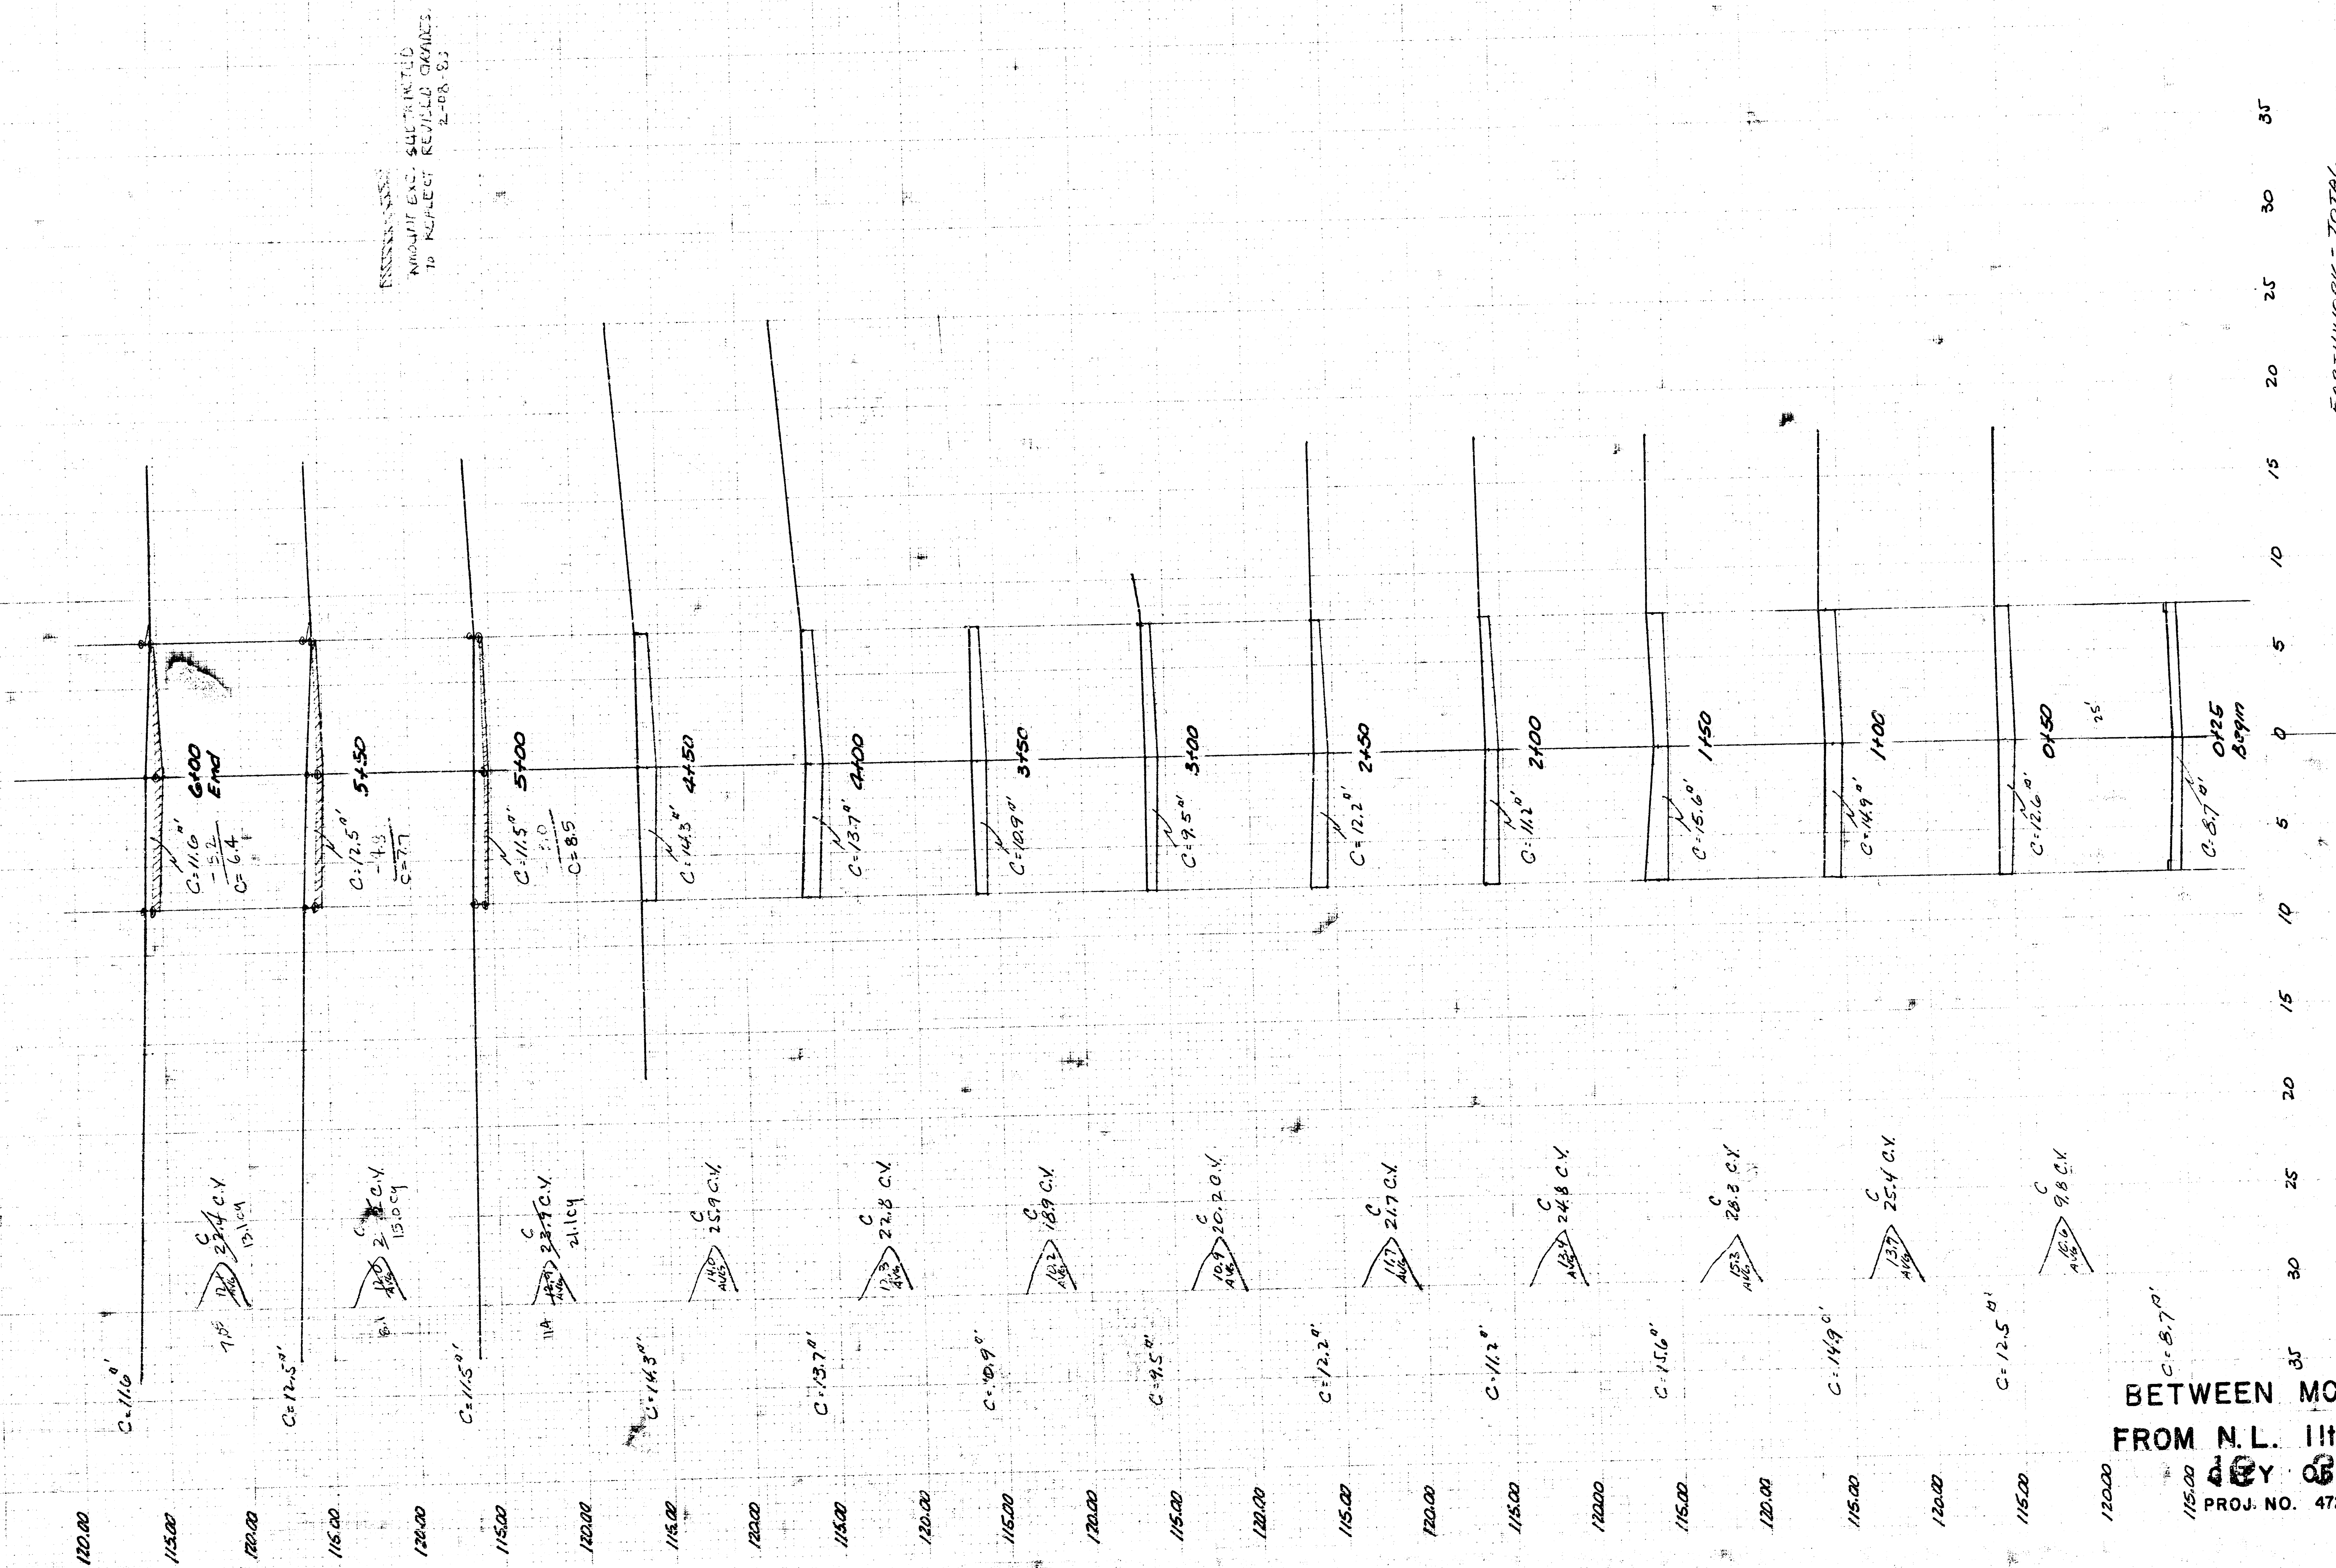

EARTHWORK

EARTHWORK - TOTAL
 EXCAV.
 246.3 C.Y.
 2470 C.Y.

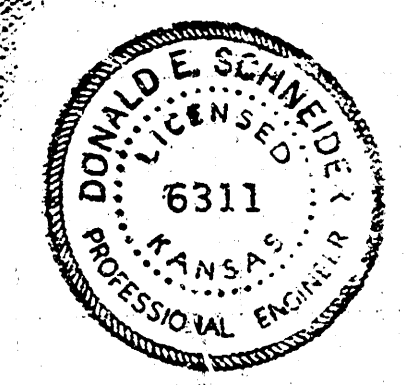

3/3

ALLEY
 BETWEEN MOSLEY & WASHINGTON
 FROM N.L. 11th ST. TO S.L. 12th ST.
 CITY OF WICHITA, KANSAS
 PROJ. NO. 472 76 245 80907 000 000 001