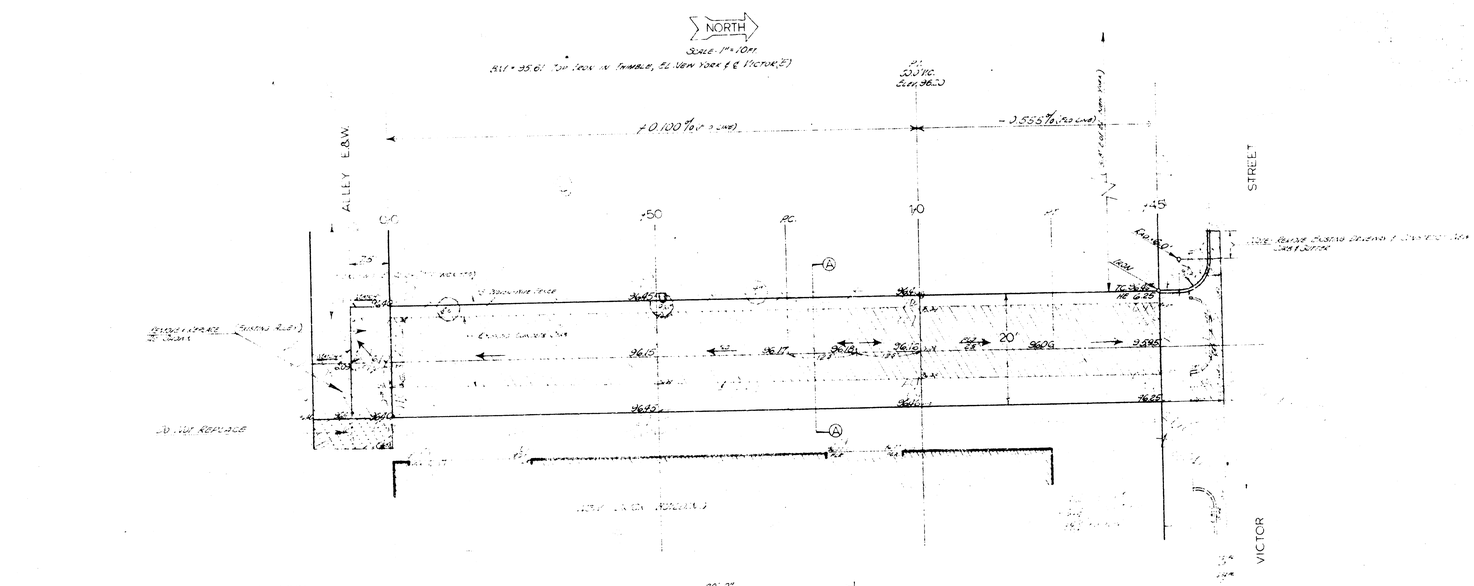

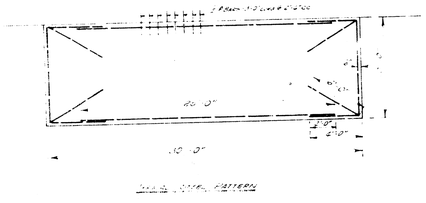

QUANTITY TOTALS

375.7	Sq. Yds. 7" Concrete Pavement
15.0	Lin. Ft. Expansion Joint Cork
5.0	" " Combined Gutter
16.5	" " Artic Joint
450	Cu. Yds. Excavation
1935	Lbs. Reinforcing Steel
2633	Sq. Yds. Pavement Removed
1547	Sq. Ft. Drive Removed
2	Ea. Trees Removed

ALLEY betw. New York and Pennsylvania
N. Alley N. of Douglas to S. Alley of Street

Lot: 7" Concrete
PRIVATE CONSTRUCTION
City of Wichita, Kansas
B.E. Smith City Engineer
Date: Dec. 1962

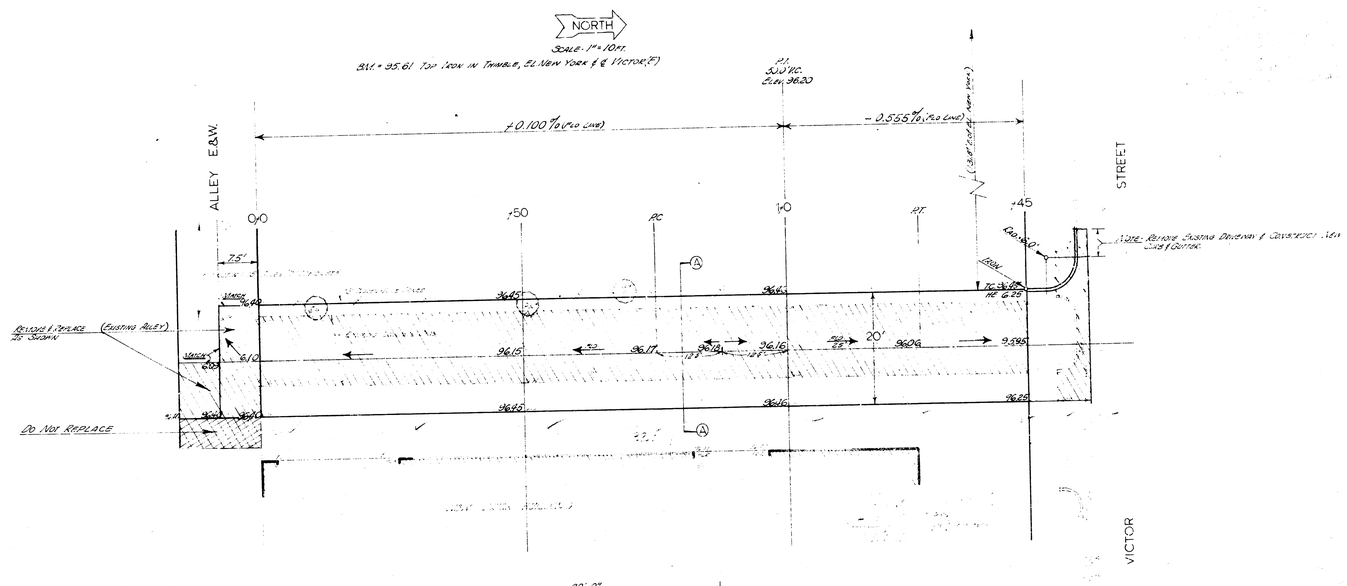

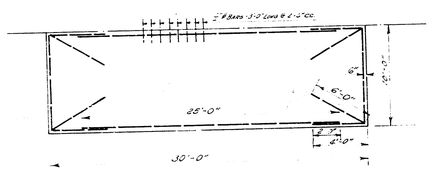

Typical Steel Pattern

Section A-A

	QUANTITY TOTALS	FINAL QUANTITIES
370.7	Sq. Yds. 7" Concrete Pavement	388.4
15.0	Lin. Ft. Reinforced 6" Curb	13.4
5.0	" " Combined Curb & Gutter	7.9
162.5	" " Mastic Joint	152.5
45.0	Cu. Yds. Excavation	61.7
1555	Lbs. Reinforcing Steel	1615
2439	Sq. Yds. Pavement Removed	242.7
1340	Sq. Ft. Drive Removed	150.3
2	Ea. Trees Anchored	none

ALLEY Betw. New York and Pennsylvania
N.L. Alley N. of Douglas to S.L. Victor Street

20 ft. - 7" Concrete
PRIVATE CONSTRUCTION

City of Wichita, Kansas
B.E. Smith City Engineer
Date: Dec. 1962