



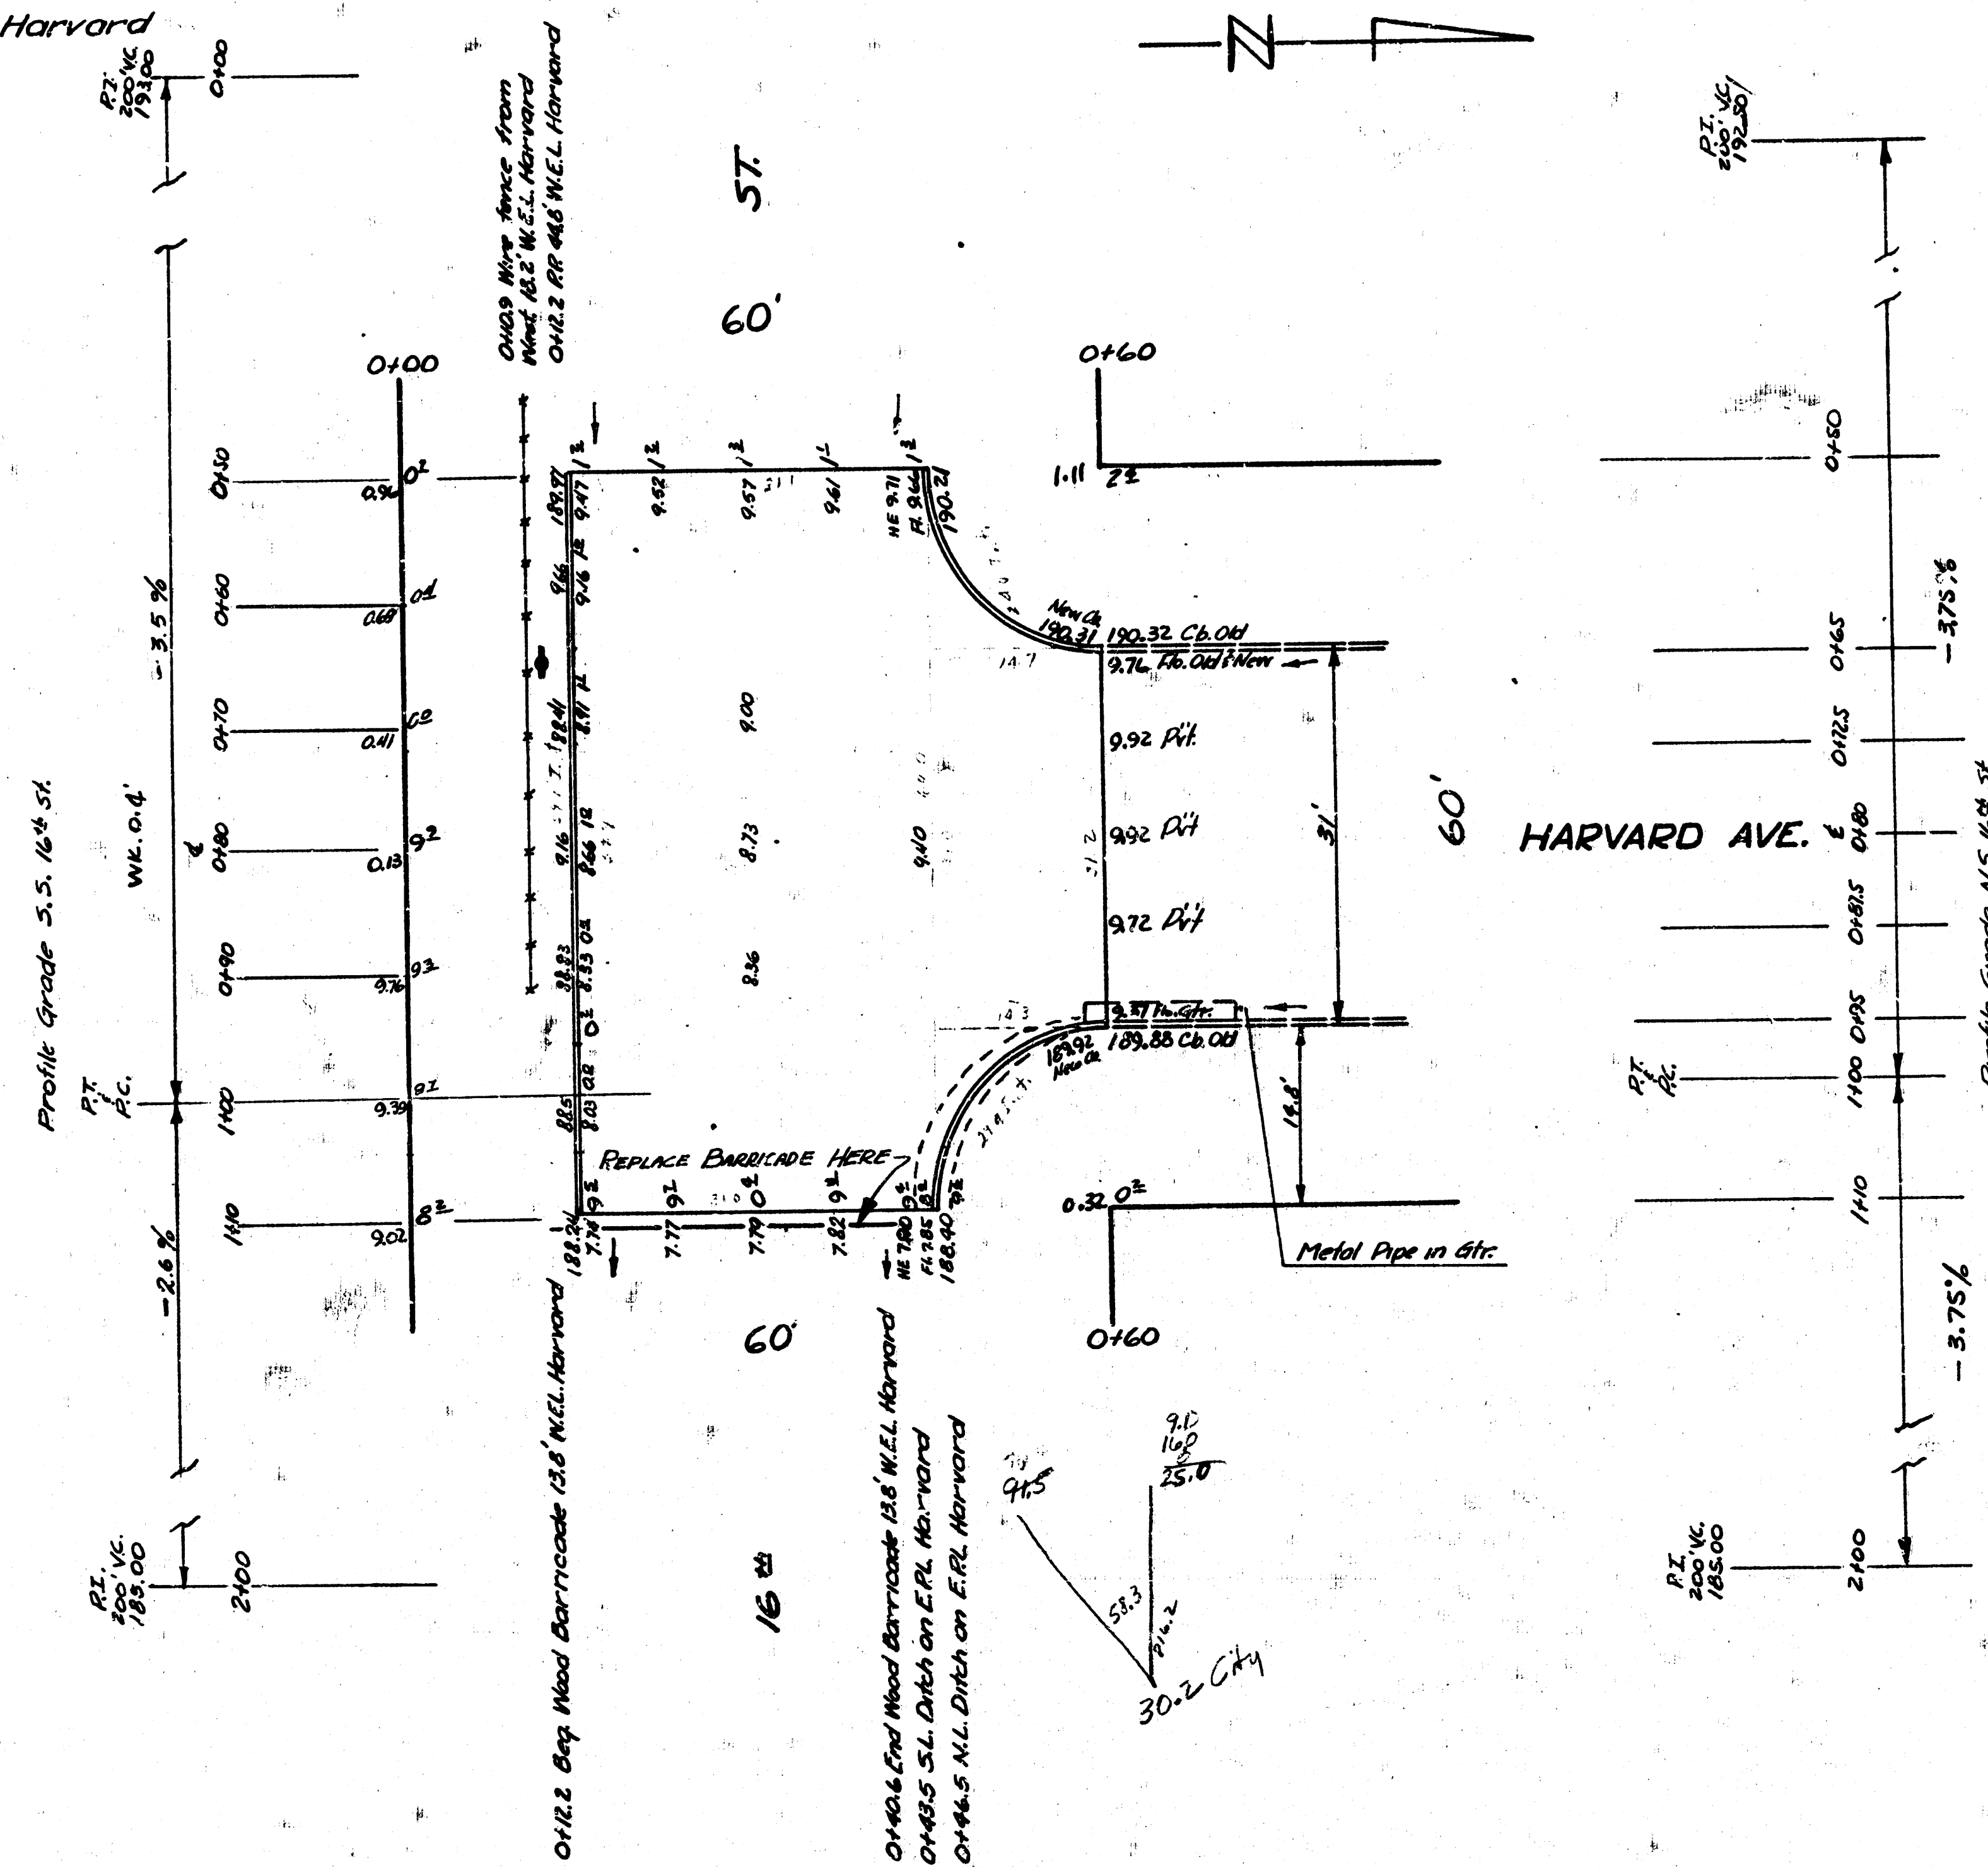


Prop.
0

City
147.1
30.2

177.3
+10% 17.7

Total 195.0 Cu. Yds.

*INTERSECTION
16th HARVARD
6" CONC.
CITY OF WICHITA, KANS.
L.K. WHITE CITY ENGINEER
JAN. 1951 PROJ. NO. C11-5*

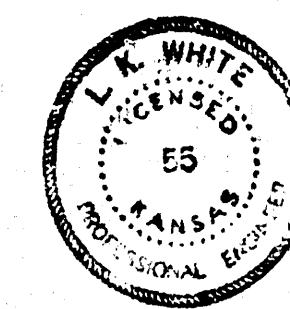

4 8 1 (58)