Decell Lane 13th & Gatewood

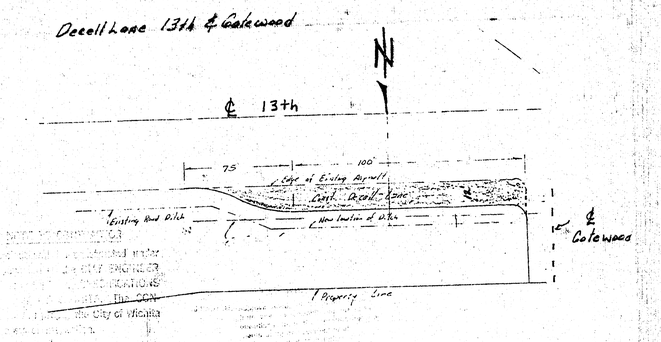

Regrade ditch to drain 5/7/81 * 5" City base (recycle)

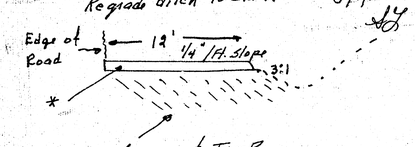

Compact Type B.
95% - top 6"
90% - below top 6"

472-76-245-80000-000-000-008

14 5 1 4

FILMED FROM THE BEST