


+ 0.1377%

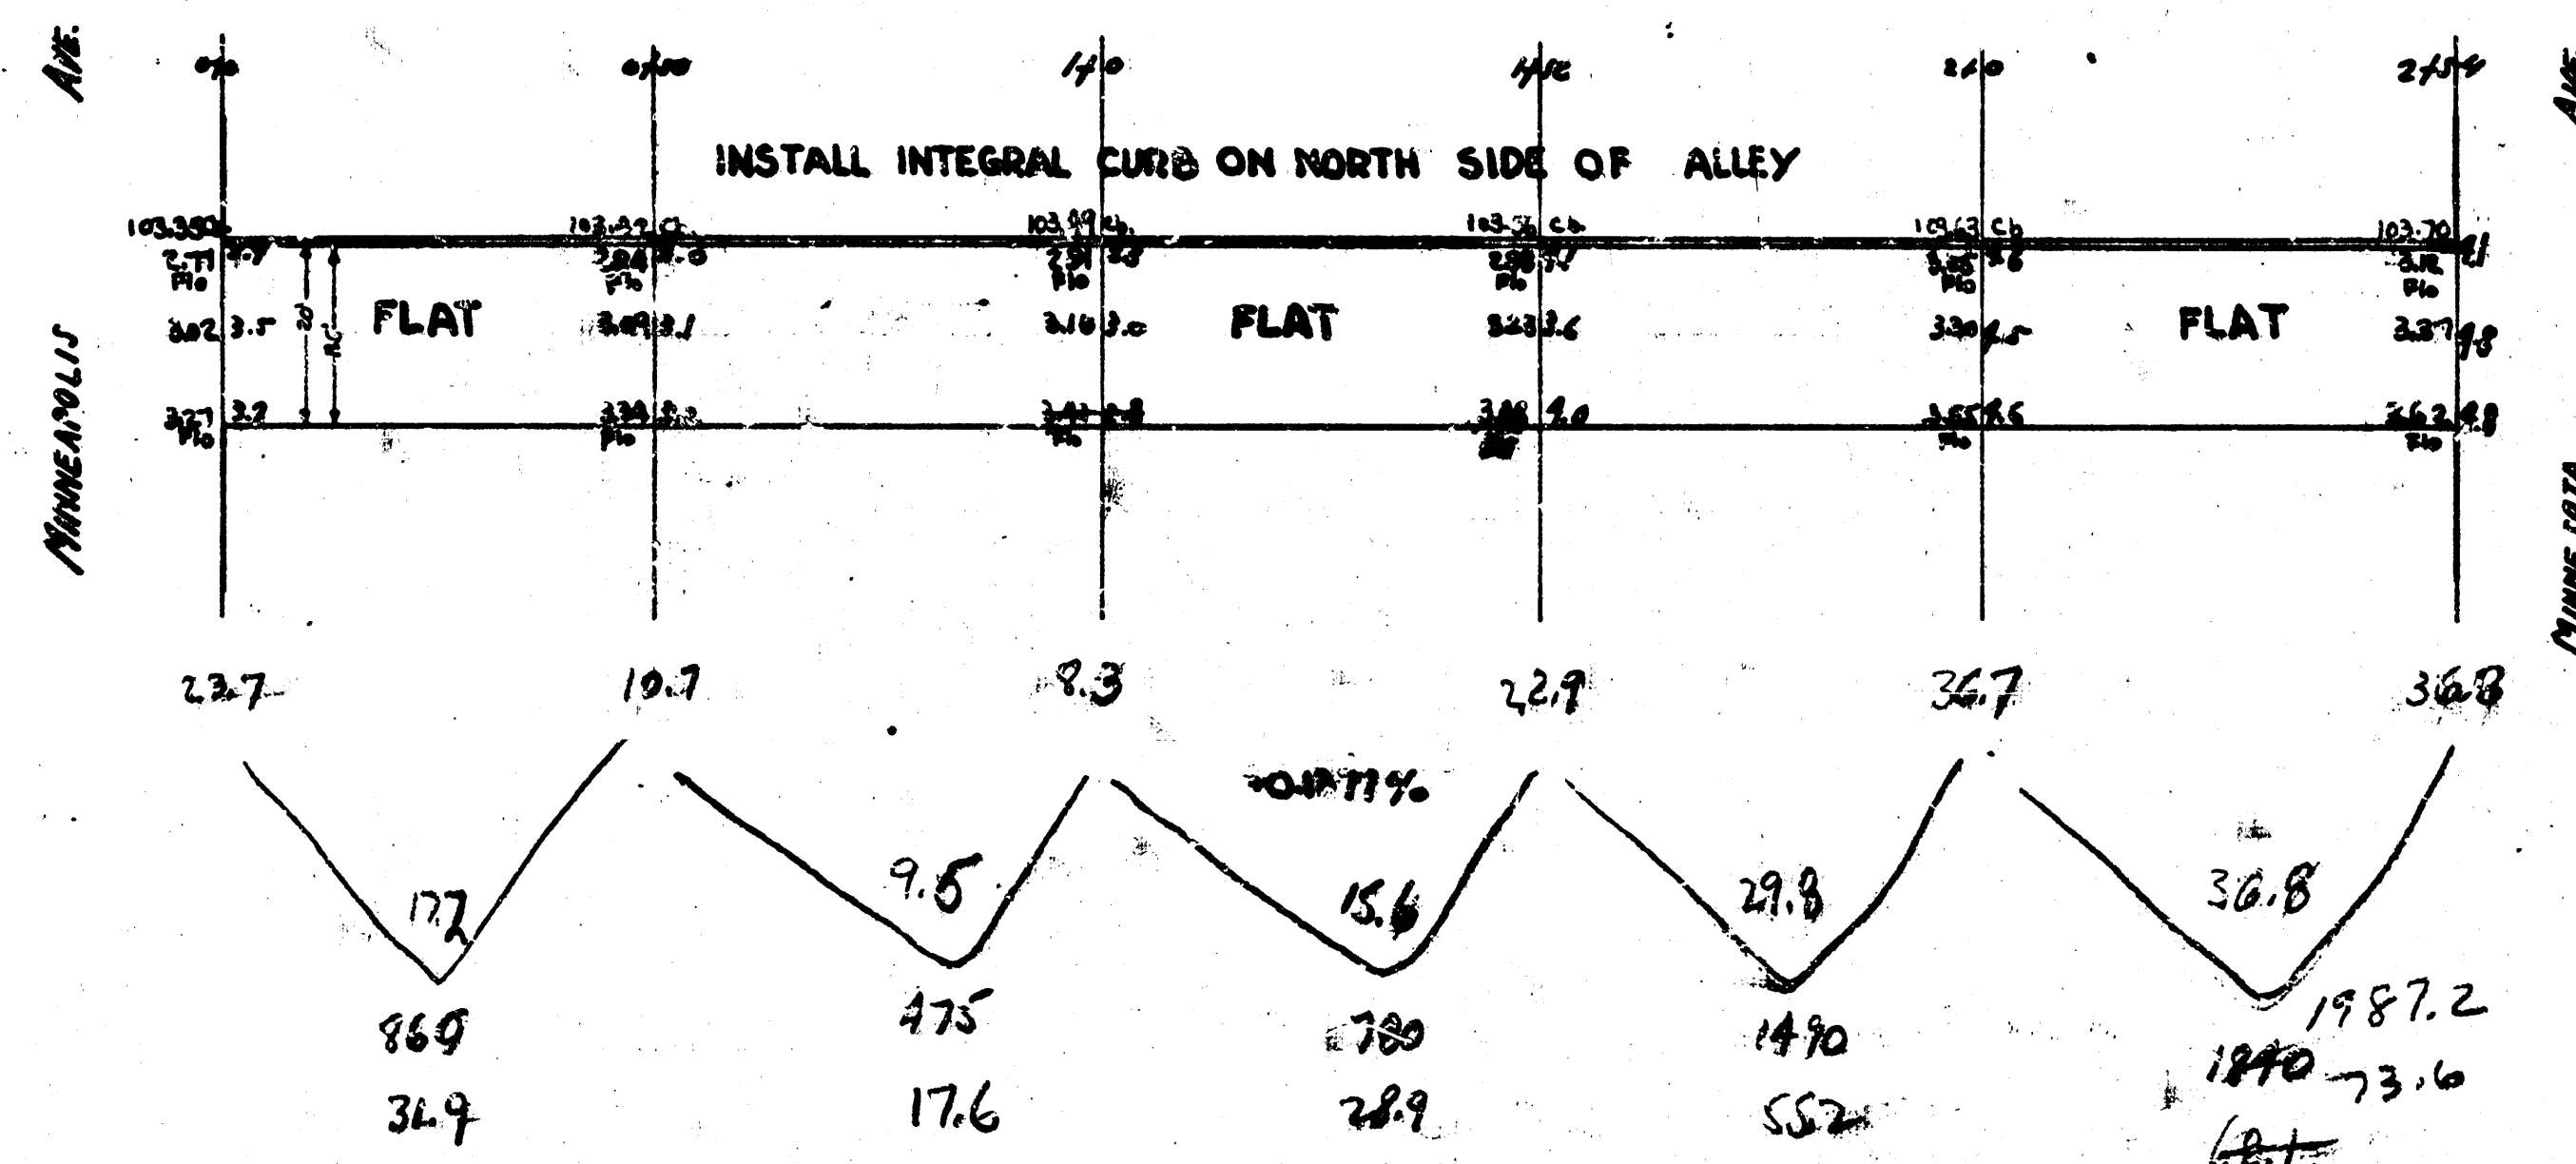

Property
31.9
17.6
28.9
55.2
68473.6

201.7207.2
+10%

221.9 *ans*

ALLEY NORTH of MYRIS
EL MINNEAPOLIS to MIL MINNEAPOLIS
6" CONCRETE 20'
CITY of WICHITA, KANSAS
ENGINEERING DIVISION
L. K. WHITE CITY ENGINEER
JULY 1949

4 1 2