


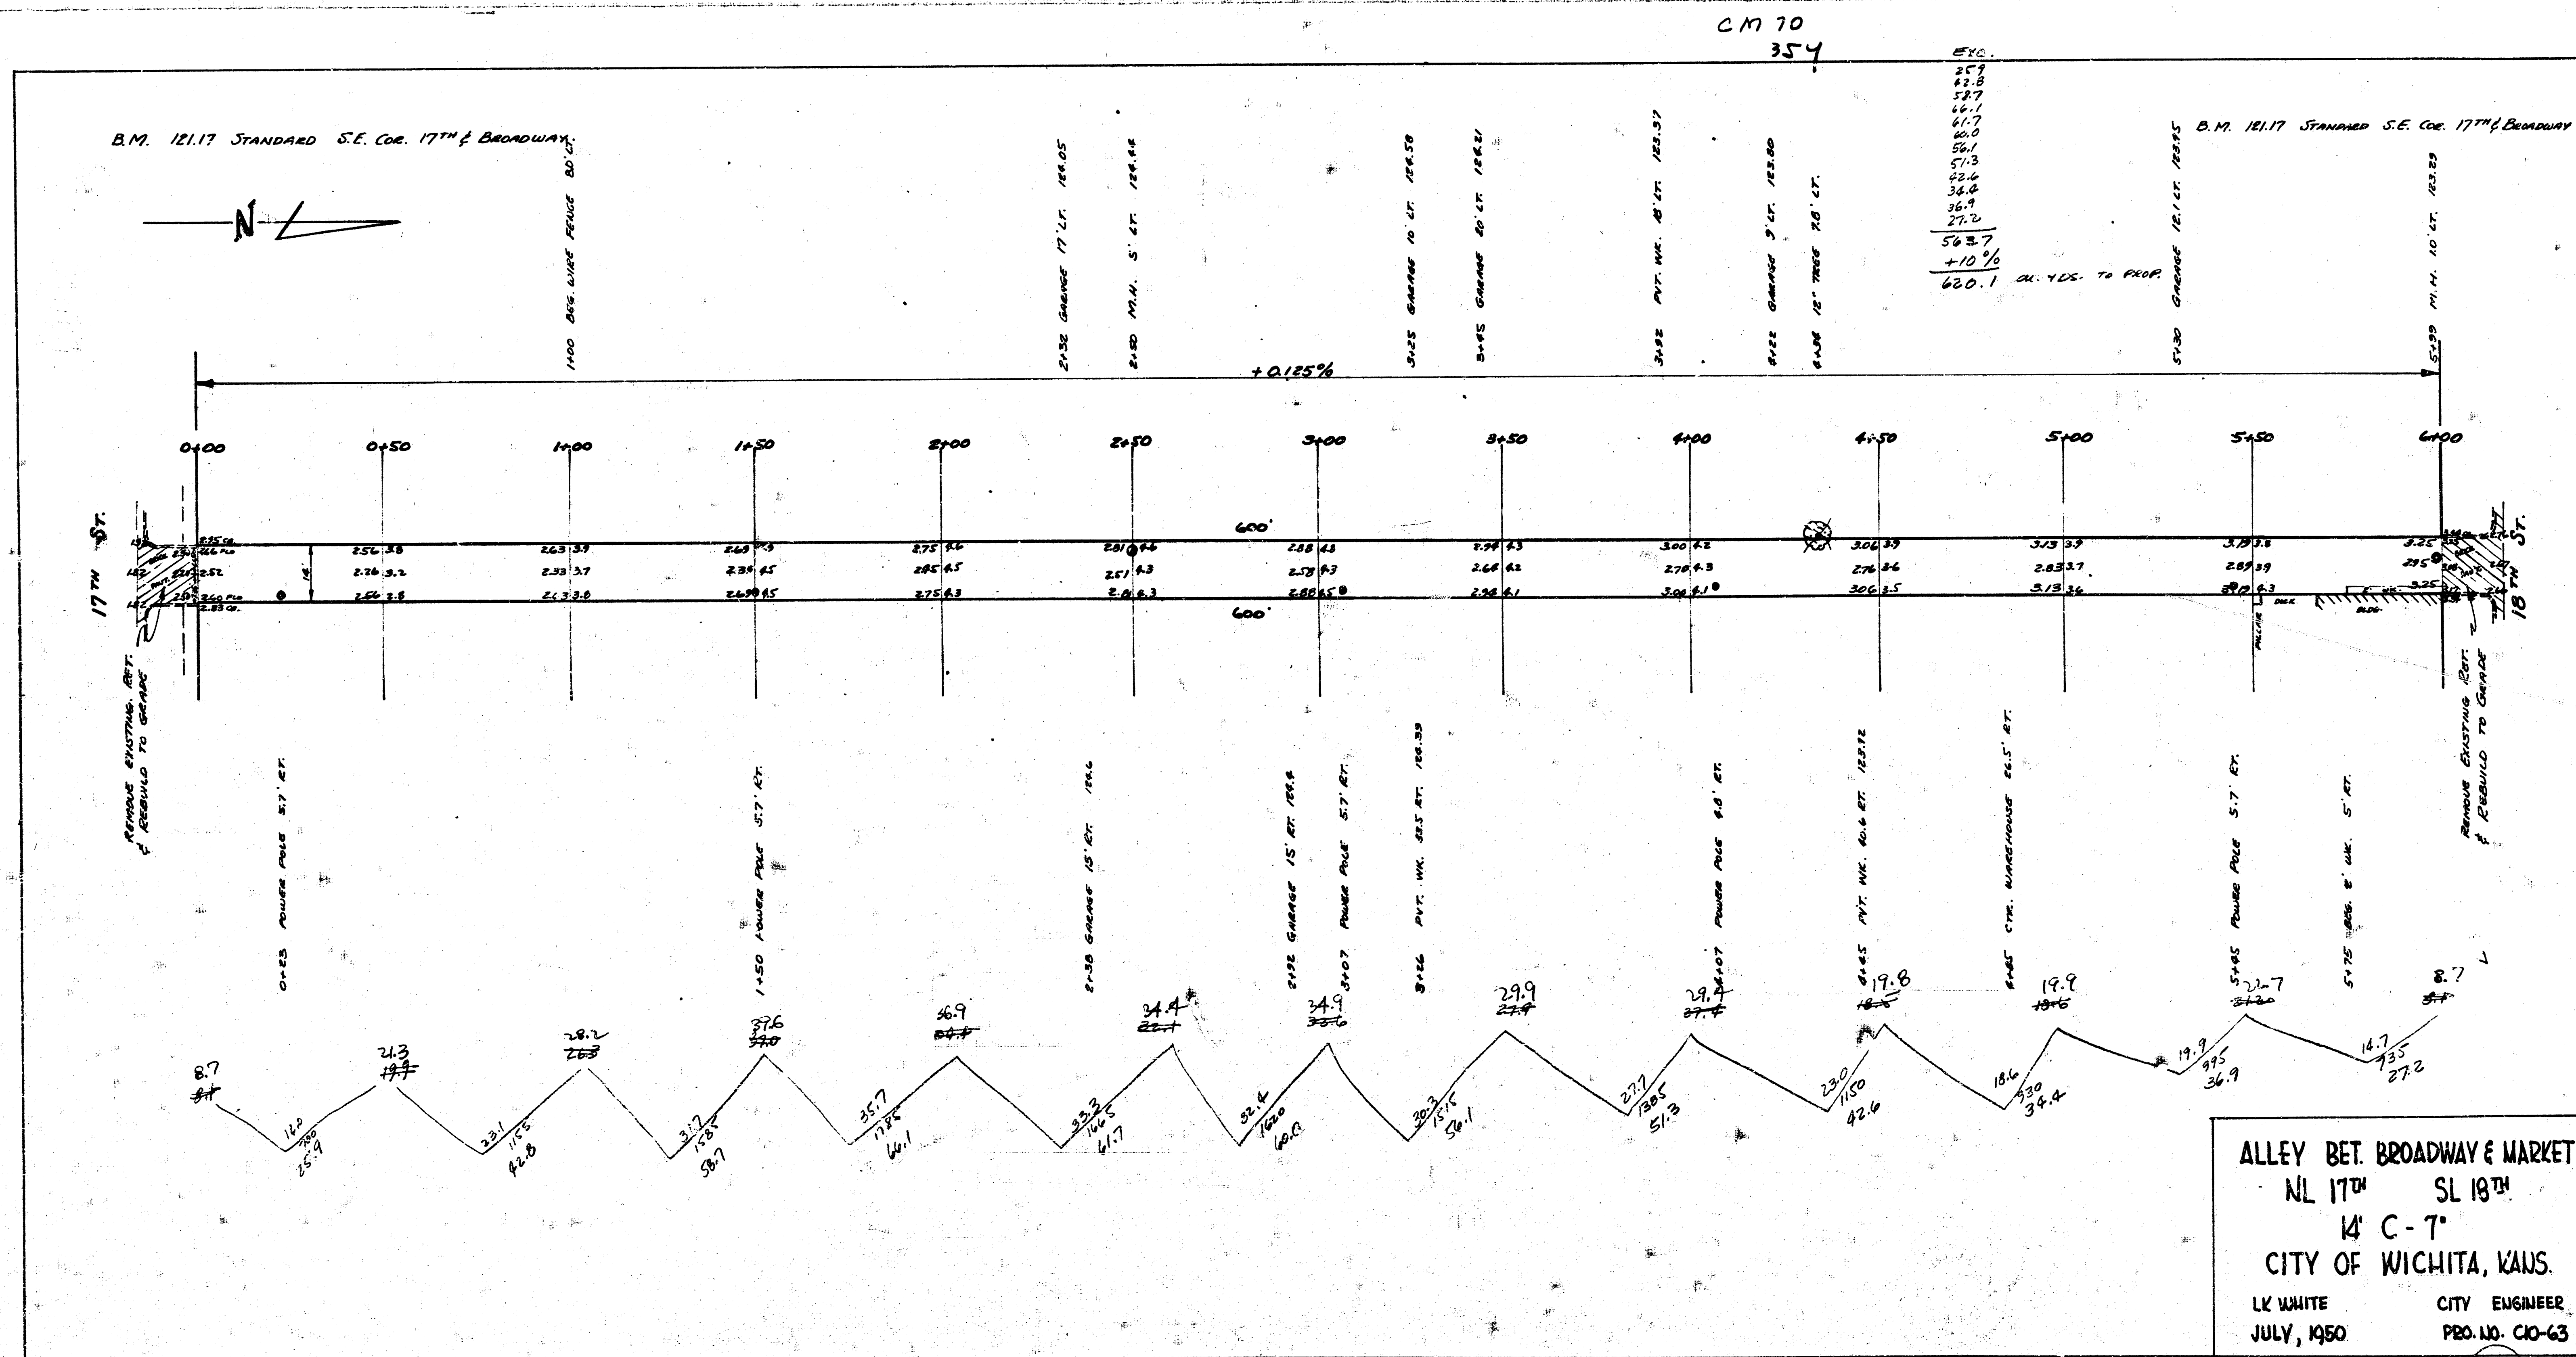

ALLEY BET. BROADWAY & MARKET
14' C - 7'
CITY OF WICHITA, KANS.
LK WHITE CITY ENGINEER
JULY, 1950 PRO. NO. CIO-63

