B.M. 107.85 Iron in thimble W.S. Ellis & E English W.
B.M. 108.43 "L" in Lefever C. Wk. E., (E.S. Alley West of Ellis) S.S. English
B.M. 108.64 N Rim N.M.H. Alley intersection, 2'E of E Alley S.
B.M. 109.80 Top of cap 2" pipe, 15'E. & 10'S of S.E. Cor. Alley Intersection

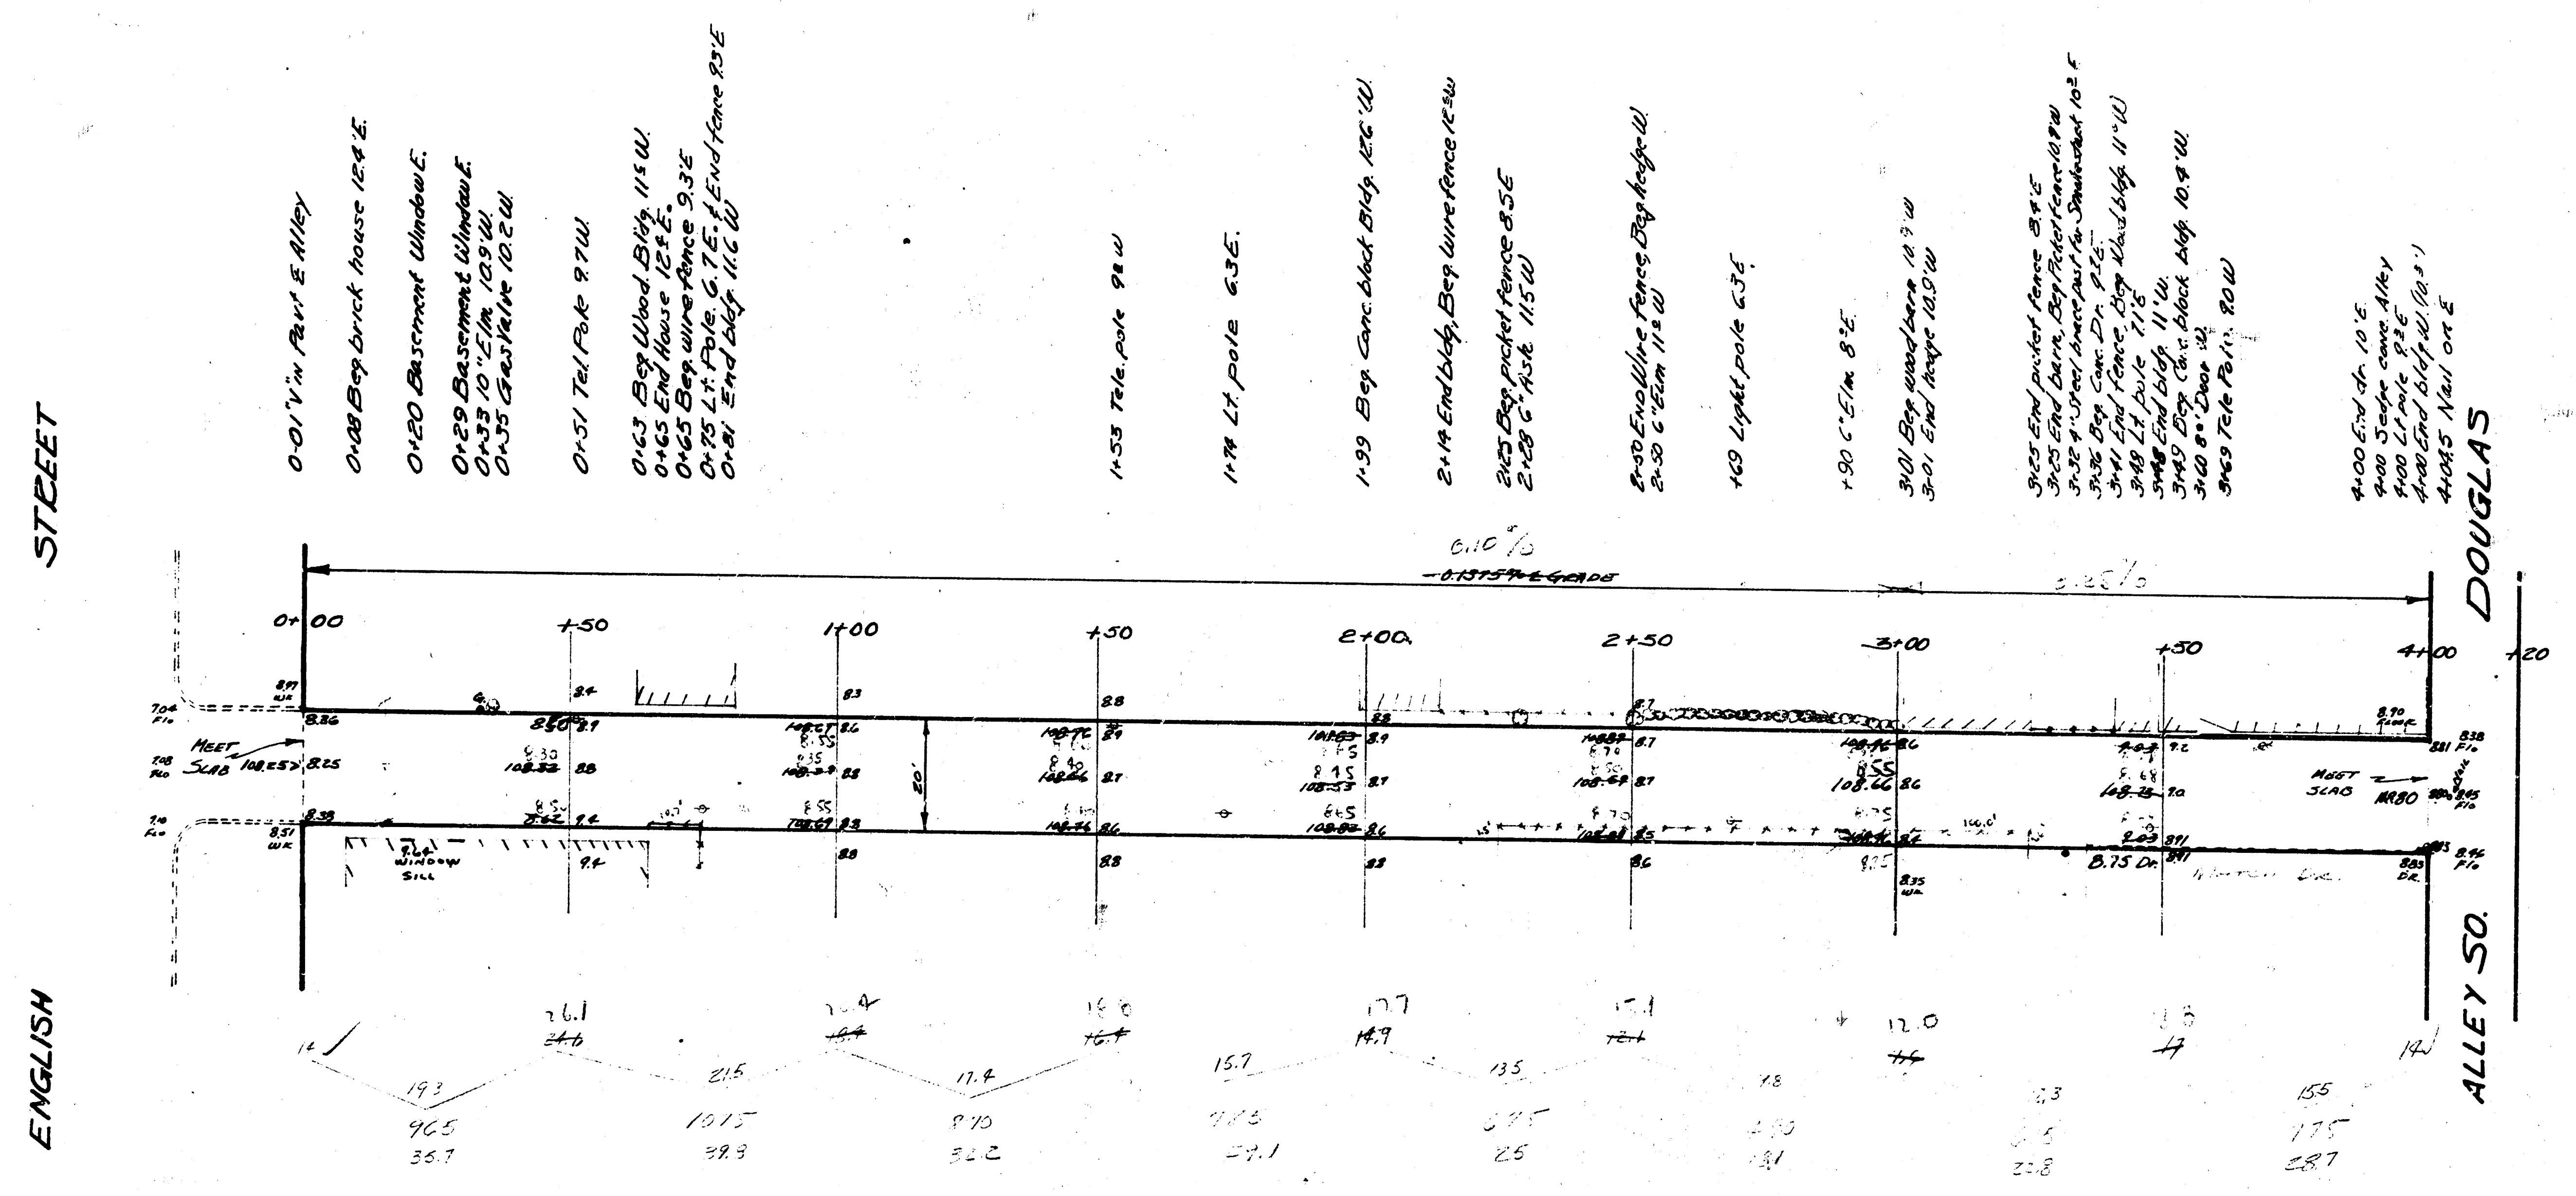
0-01 "V" in Pavt E Alley
0+08 Beg. brick house 12.4'E.
0+20 Basement Window E.
0+29 Basement Window E.
0+33 10" Elm 10.9'W.
0+35 Gas Valve 10.2 W.
0+51 Tel. Pole 9.7 W.
0+63 Beg Wood Bldg. 11.5 W.
0+65 End House 12.4 E.
0+65 Beg. wire fence 9.3'E
0+75 Lt. Pole 6.7 E. & End fence 9.3'E
0+81 End bldg. 11.6 W
1+53 Tele. pole 9.8 W
1+74 Lt. pole 6.3E.
1+99 Beg. Conc. block Bldg. 12.6'W.
2+14 End bldg, Beg. Wire fence 12.5 W
2+25 Beg. picket fence 8.5E
2+28 6" Ash 11.5 W
2+50 End Wire fence, Beg. hedge W.
2+50 6" Elm 11.0 W
+69 Light pole 6.3E
+90 6" Elm 8'E.
3+01 Beg wood barn 10.9'W
3+01 End hedge 10.9'W
3+25 End picket fence 8.4'E
3+25 End barn, Beg Picket fence 10.9'W
3+32 4" Steel brace post for Sidewalk 10.2 E
3+36 Beg. Conc. Dr. 9.3'E
3+41 End fence, Beg Wood bldg 11.0'W
3+48 Lt. pole 7.1'E
3+48 End bldg. 11'W.
3+49 Beg Conc. block bldg. 10.9'W.
3+60 8' Door W
3+69 Tele Pole 9.0 W
4+00 End dr. 10'E.
4+00 Sedge conc. Alley
4+00 Lt pole 9.3E
4+00 End bldg W. (10.3')
4+04.5 Nail on E
ENGLISH STREET
DOUGLAS
ALLEY SO.
0.10%
~~-0.1375% E GRADE~~
0.25%
0+00
+50
1+00
+50
2+00
2+50
3+00
+50
4+00
+20
MEET SLAB
WINDOW SILL
20'
B.75 Dr.
19.3
21.5
17.4
15.7
14.9
13.5
13
12.0
23
15.5
14
9.65
10.15
9.70
35.7
39.3
32.2
29.1
25
22.8
28.7

Refigure cuts
center of alley stakes
0.1% Grade & [illegible] .2
6/9/53

[illegible]

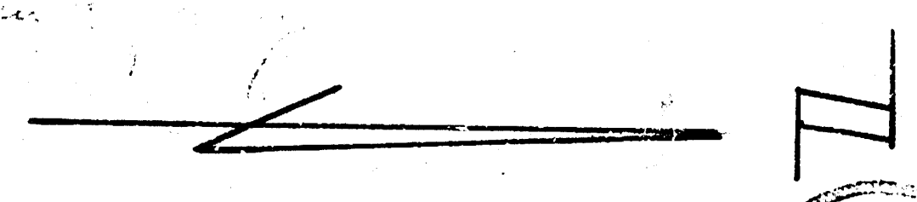

B. E. SMITH 436

ALLEY BET. ELLIS & LULU
N.L. ENGLISH TO S.L. ALLEY SO. OF DOUGLAS
8" CONC. 20'

CITY OF WICHITA, KANSAS
B.E. SMITH CITY ENGINEER
JAN. 26, 1953 PROJ. NO. C12-235