



BM. W.C.N.C. Cor. 3rd & N. Douglas Elev. 112.25


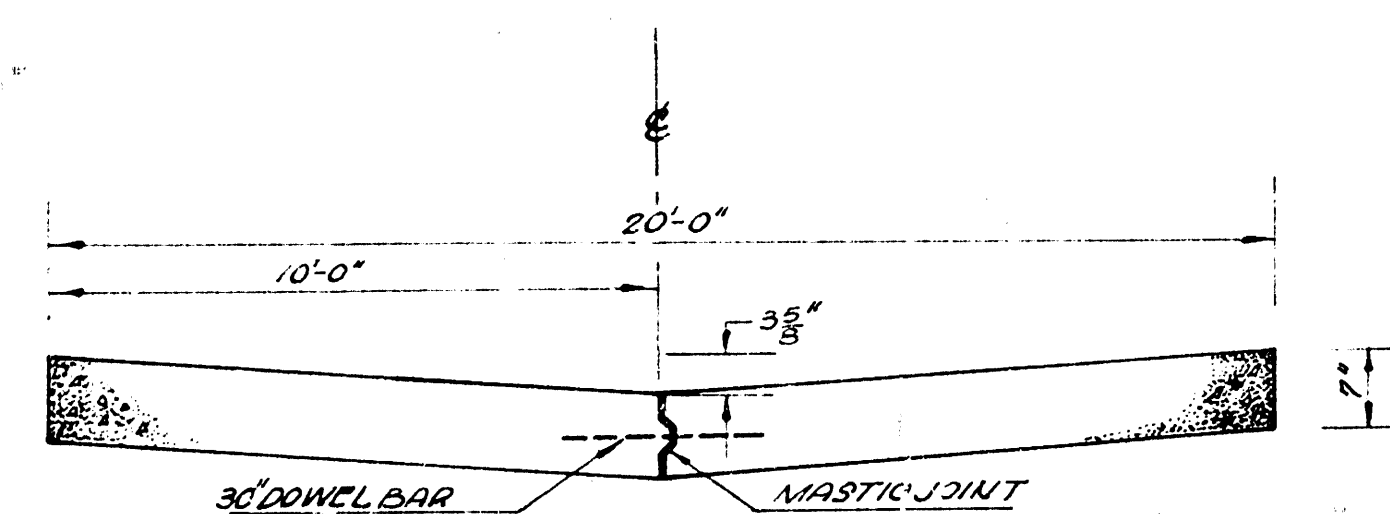


TYPICAL CONC. SECTION
NO SCALE

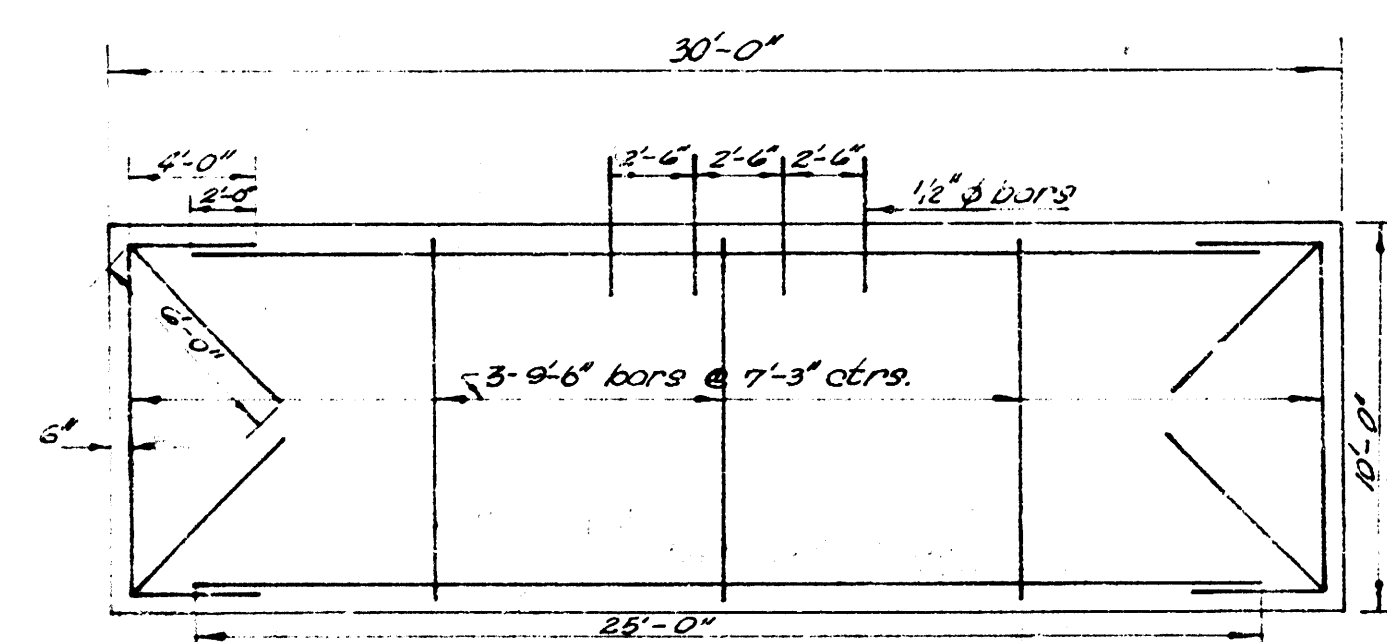

TYPICAL STEEL PATTERN
NO SCALE

Note:
All Steel to be 3/4" bar
unless otherwise noted.

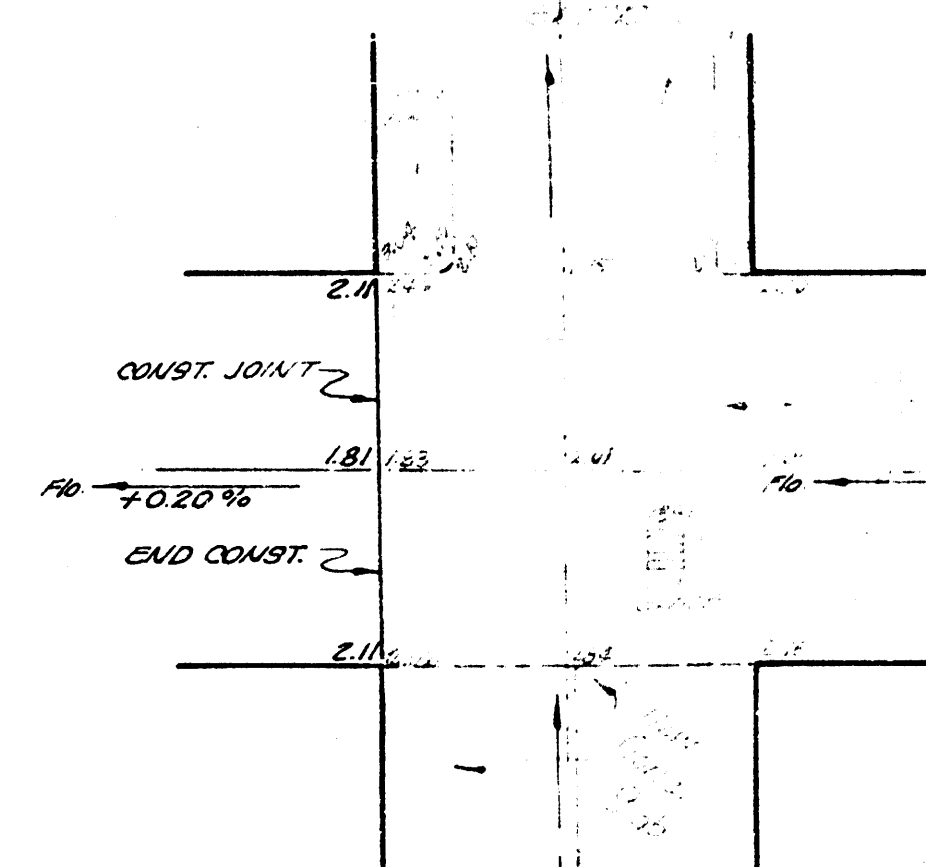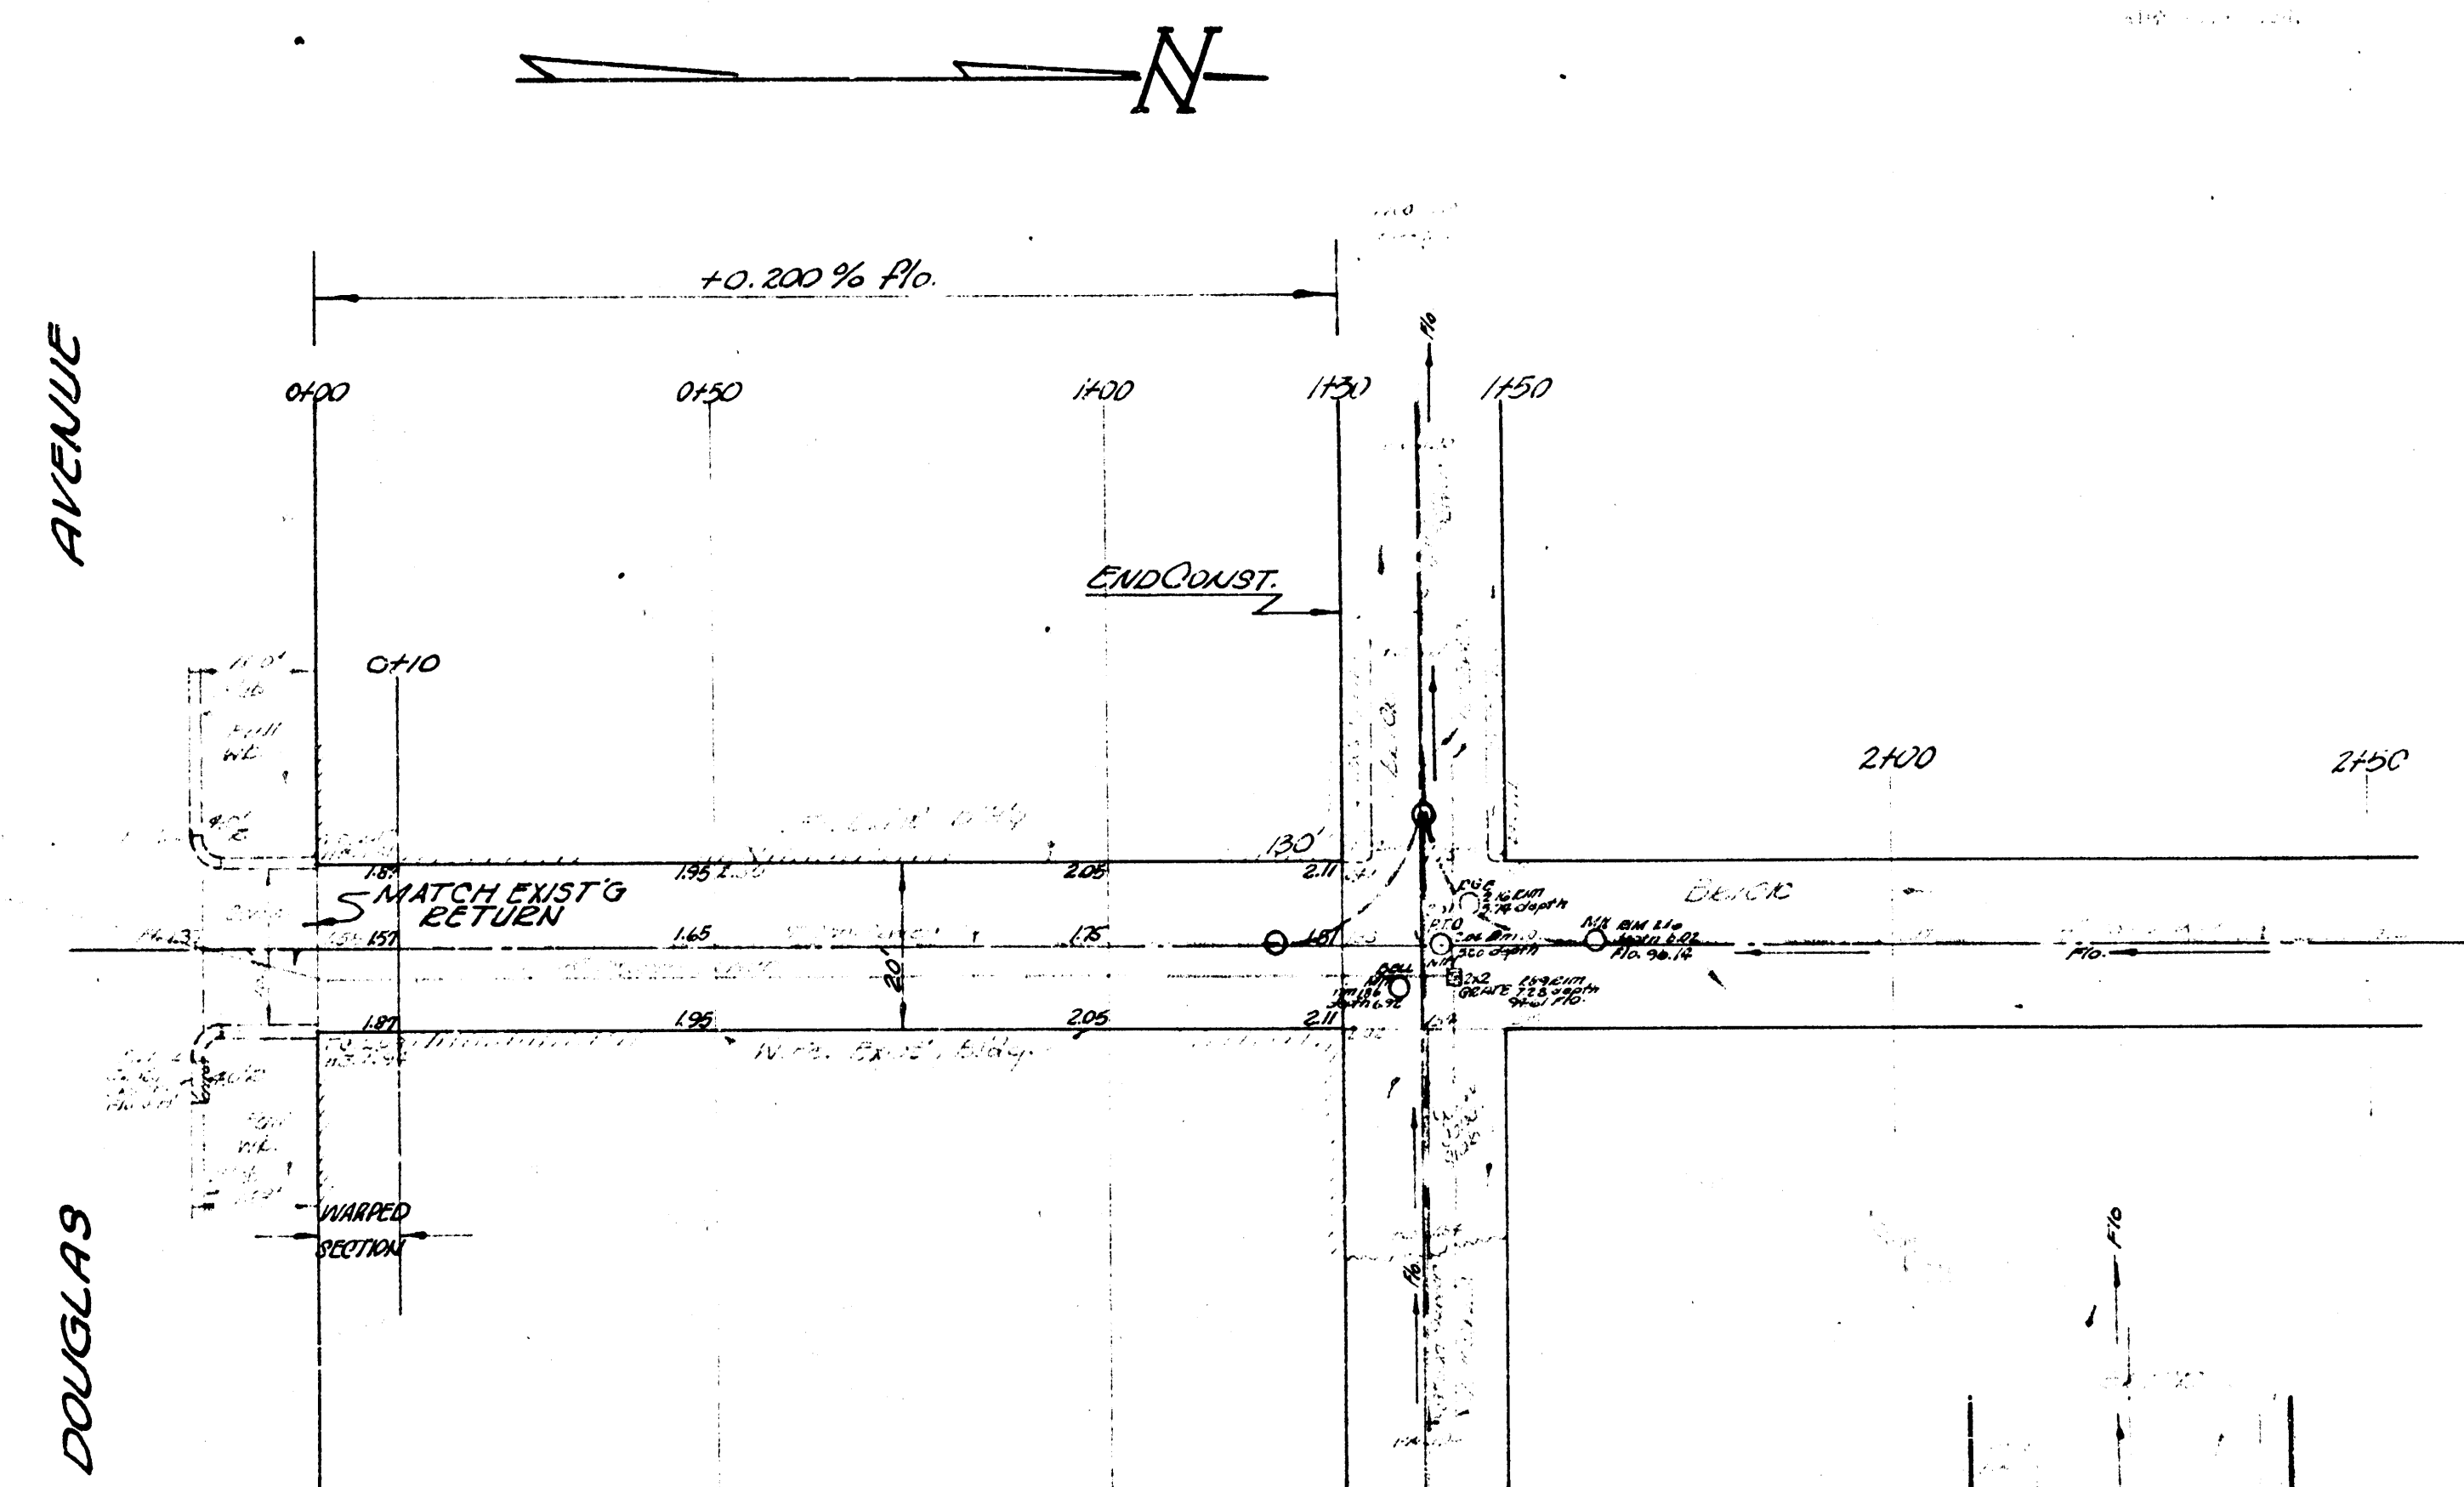

ALLEY BET. MAIN & WATER
Lt. Douglas to Alley No. Douglas
7" CONC.
CITY OF WICHITA, KANSAS
B.E. SMITH CITY ENGINEER
OCT. 1957 PRIVATE PROJ.