


B.M. 167.26 'M' IN MUELLER F.P. N.W. Cor. ORME & LIGHTNER

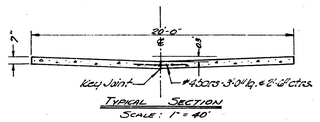

TYPICAL SECTION
SCALE: 1" = 40'

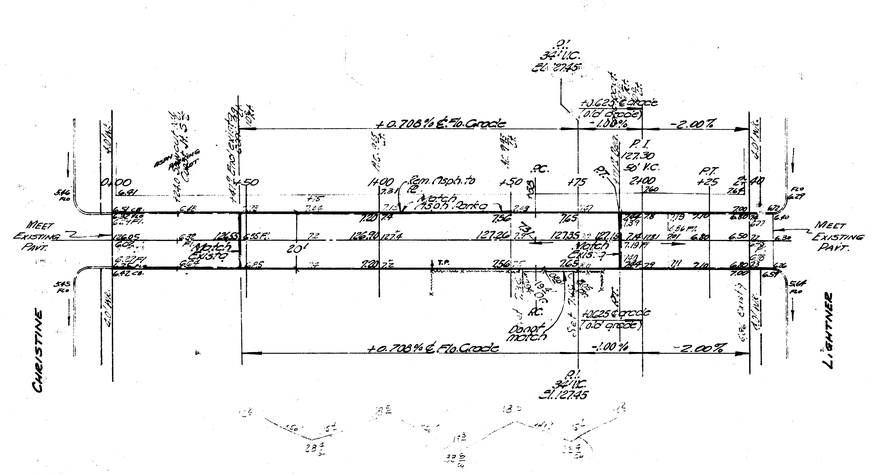

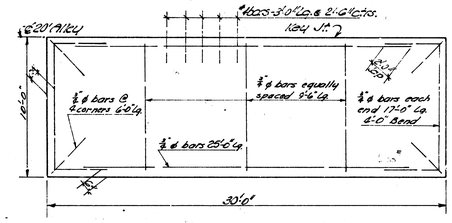

STEEL PATTERN
No Scale

EARTHWORK QUANTITIES
Excavation
355 C.Y.
80 C.Y. (40%)
972 C.Y.

Revised 7-19-68

"ALLEY BET. KELLOGG & ORME
417.9' E. of EL. Christine to 191.8' E. of EL. Christine.
20'-7" Conc.

City of Wichita, Kansas
B.E. Smith City Engineer
Date: JULY 1968, Proj. No. C-13-79

ALLEY BETWEEN KELLOGG & ORME
E.L. CHRISTINE TO W.L. LIGHTNER
20' - 7" CONC.
CITY OF WICHITA, KANSAS
B. E. SMITH - CITY ENGINEER
SEPT., 1954 PRIVATE JOB

B. E. SMITH LICENSED 436 PROFESSIONAL ENGINEER