


1942
 Alley - Between Topeka & Broadway
 N.L. 3rd to N.L. lot 78 Topeka Ave.
 20' Conc.

MO *re X* *Return*

111.41 ft. E. Ch Broadway W of Sta. 3+05
 112.87 ft. W. E.S. Broadway

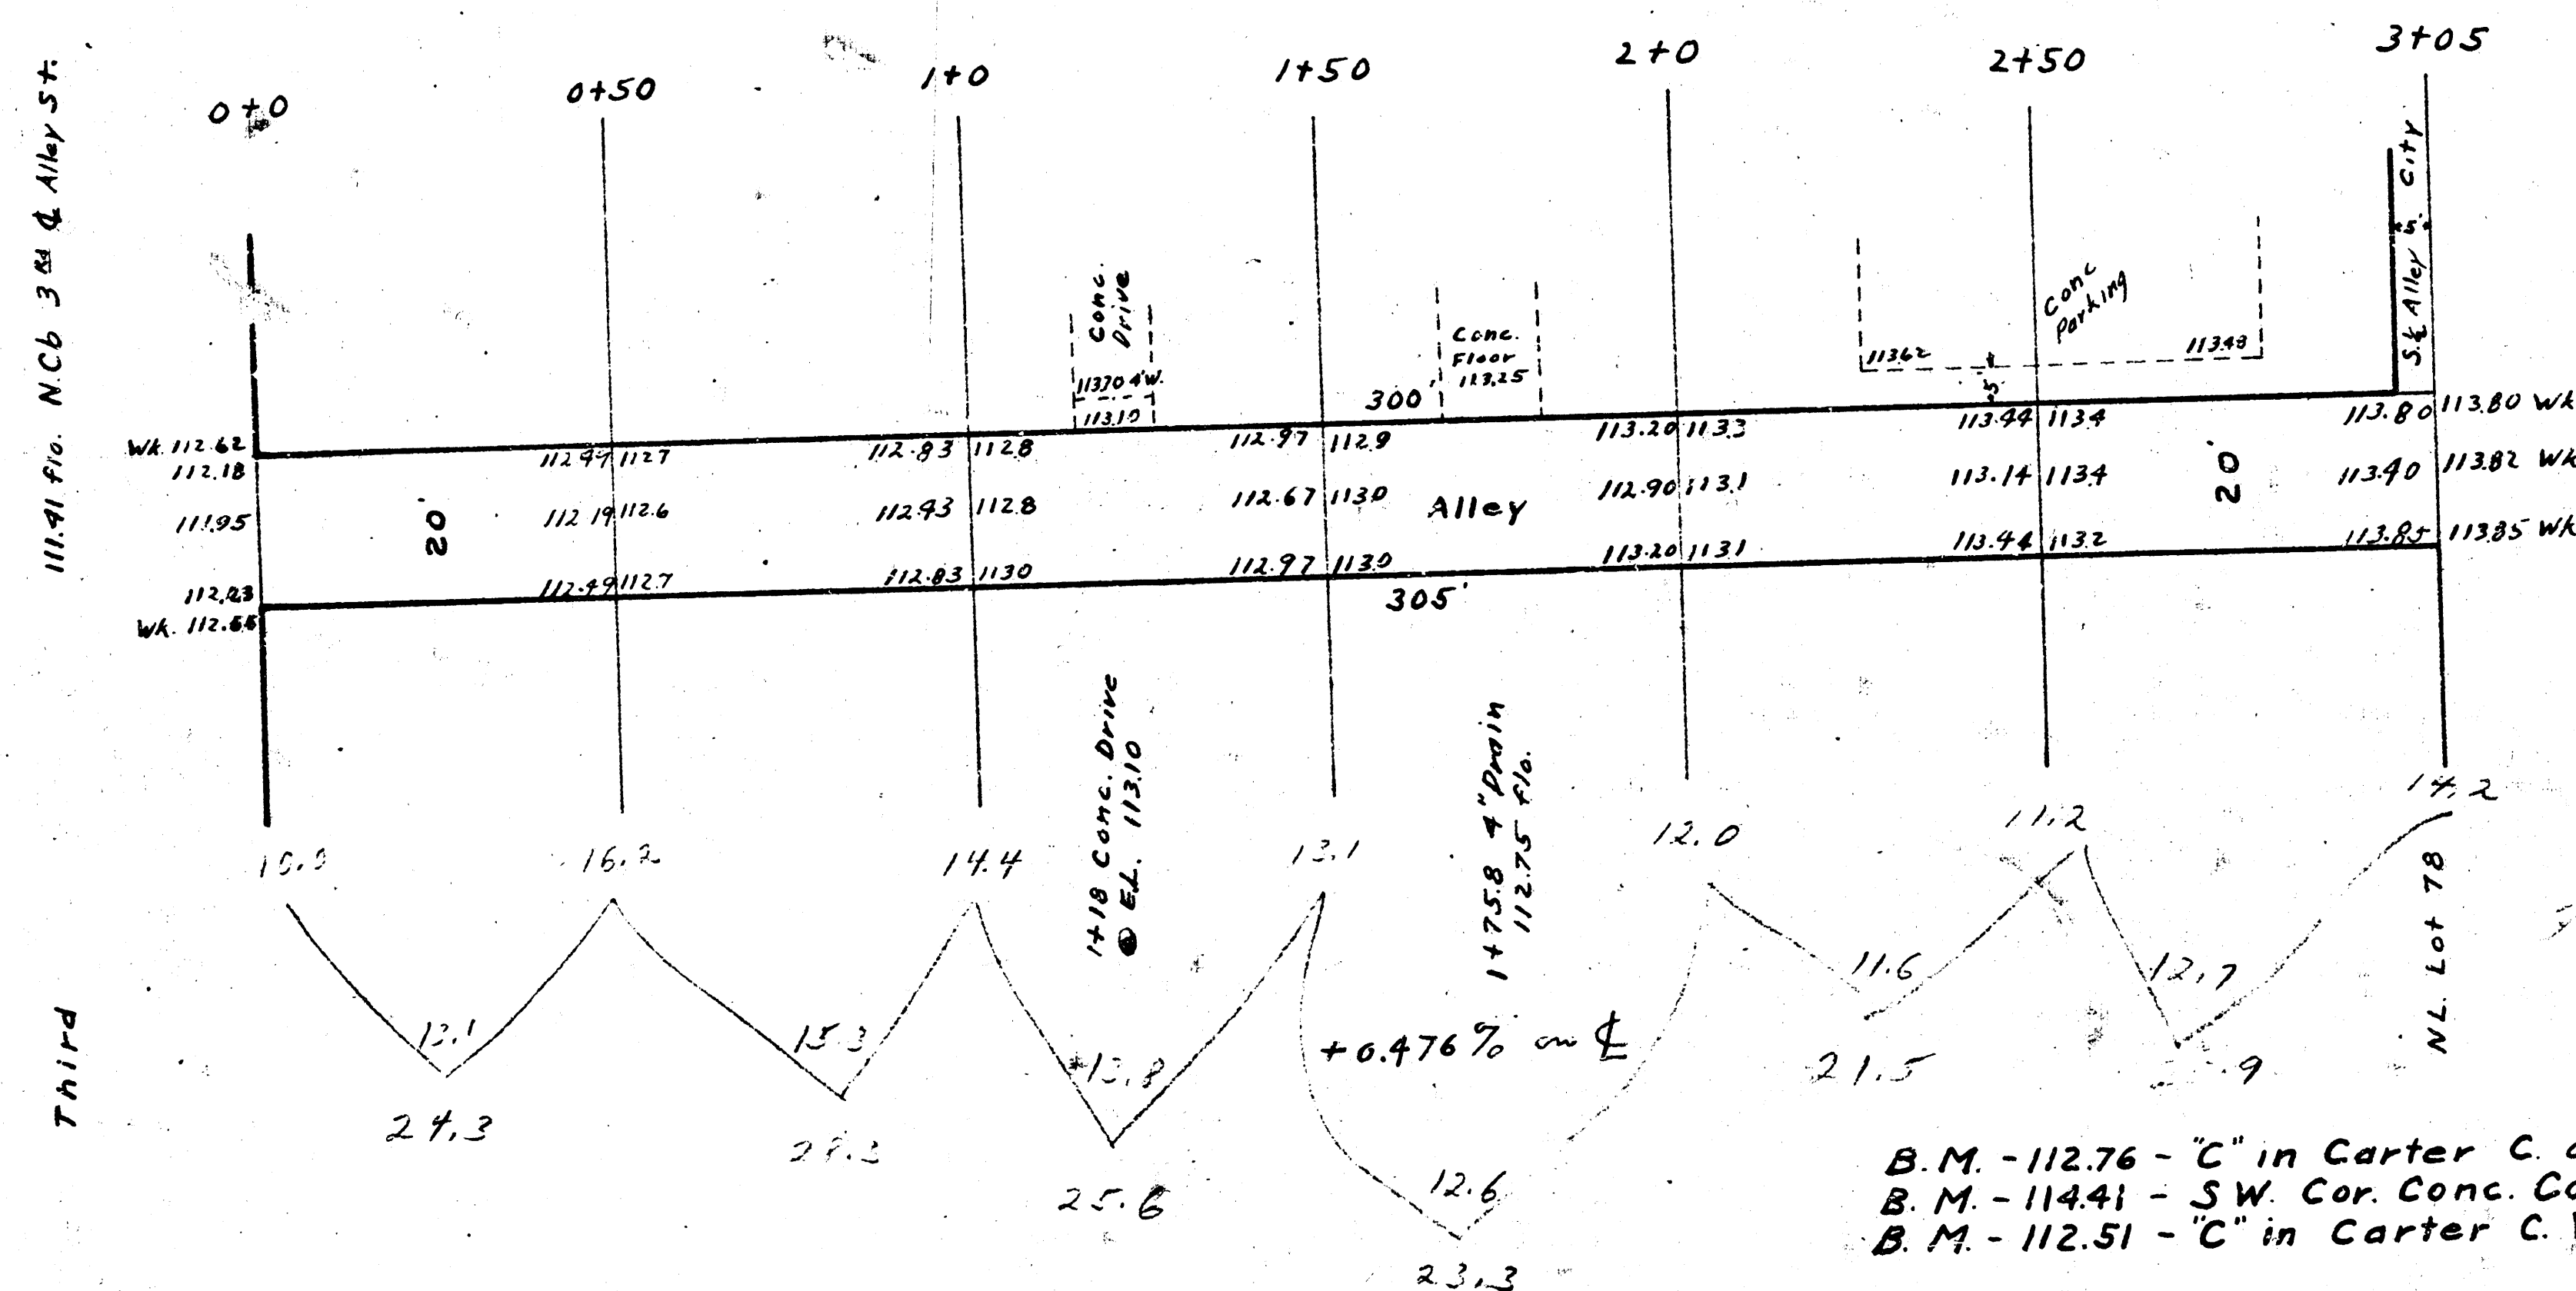

24.3
 24.2
 25.0
 23.7
 21.5
 25.9
 14.7
 14.9
 14.1