


FF #32

BM. 15749 "X" on ch. S. of S. Det. Alley
 BM. 15450 SE cor. E. Headwall Culvert 6850' S. of SL Cottonwood on Woodlawn.

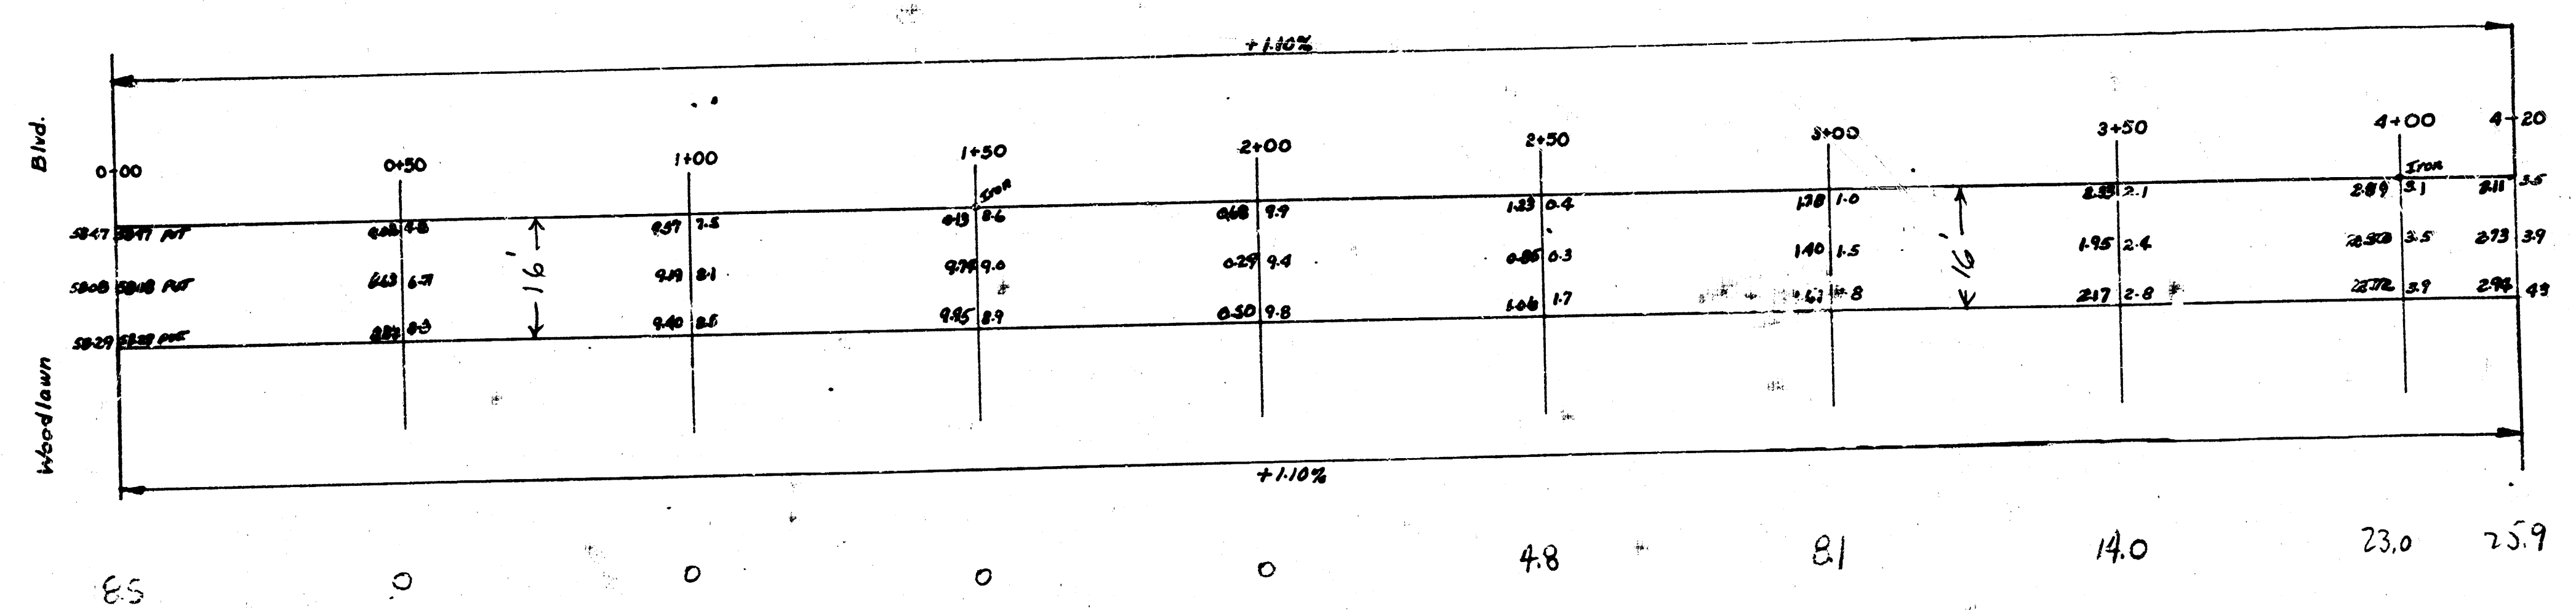

ALLEY- Bet Kellogg & Cottonwood
 EL. Woodlawn Blvd. to W. Hunter St.
 20' Conc.
 City of Wichita, Kansas
 L.K. White - City Engineer
 Nov 1950 Proj. No.