

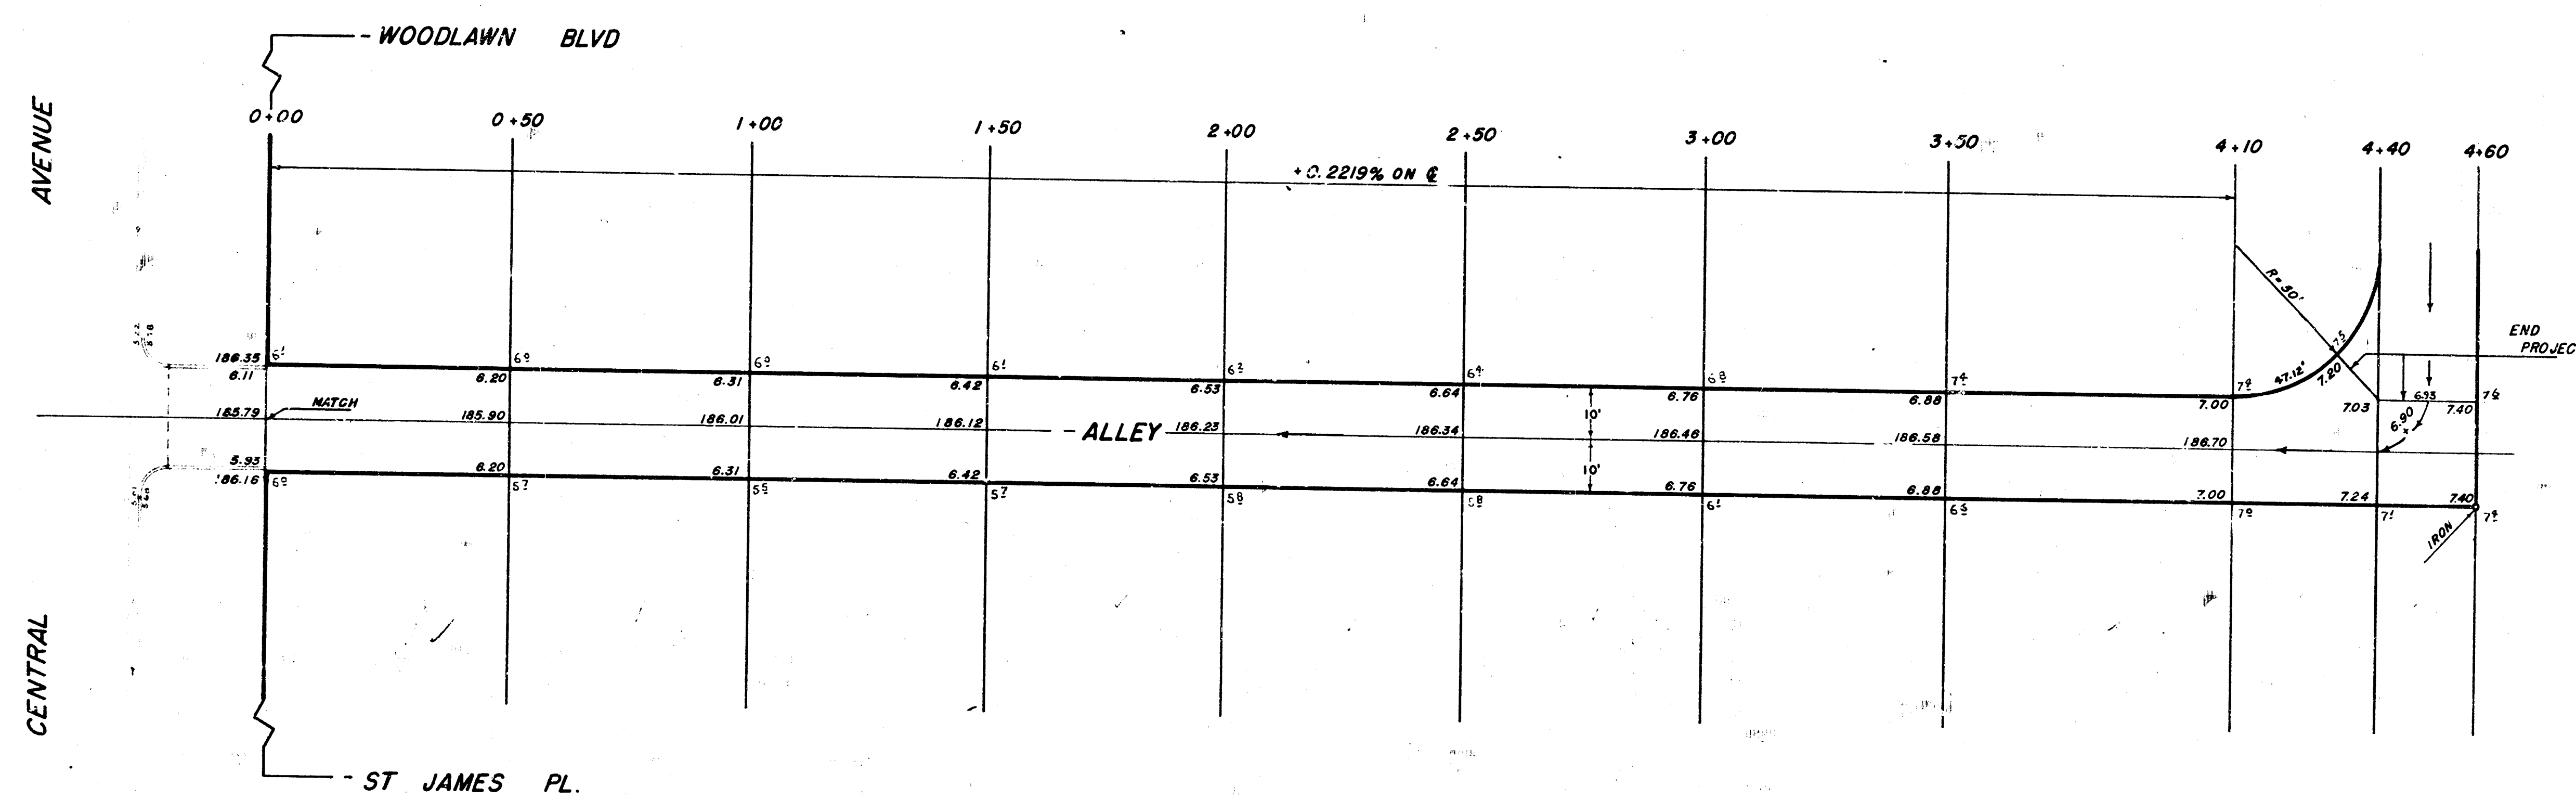


BM+192.15 STANDARD N.W. COR WOODLAWN & CENTRAL  
 BM+194.12 "E" IN RITCHIE, W. CURB, ST JAMES & N.L. CENTRAL.  
 B.M.+195.86 R.R. SPIKE N. SIDE P. POLE ON N. SIDE CENTRAL 40' EAST  
 OF ALLEY, BET WOODLAWN & ST JAMES.

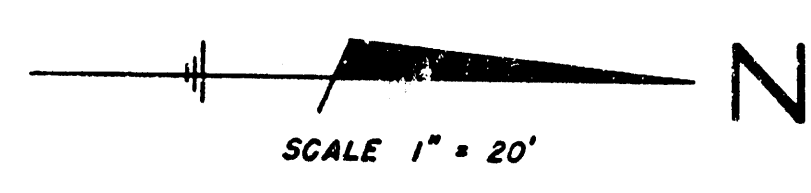


Survey Young  
 Plan Engineer  
 Exc. Engr.  
 Checked

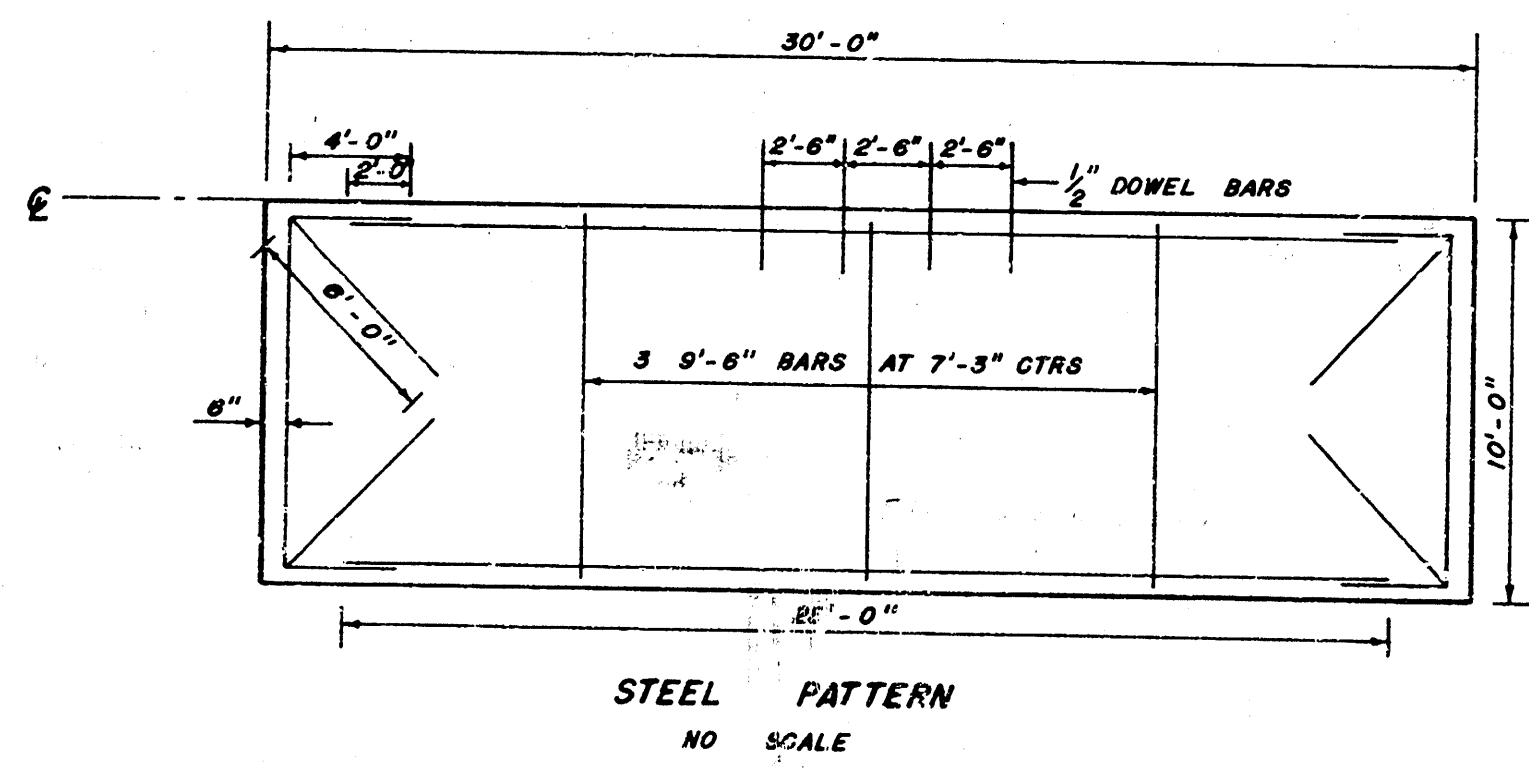

EXCAVATION  
 162.4 CU YARDS  
 10% 16.2 " "  
 TOTAL 178.6 CU YARDS

COMP. FILL  
 3.3 CU YARDS  
 10% 0.3 " "  
 3.6 CU YARDS

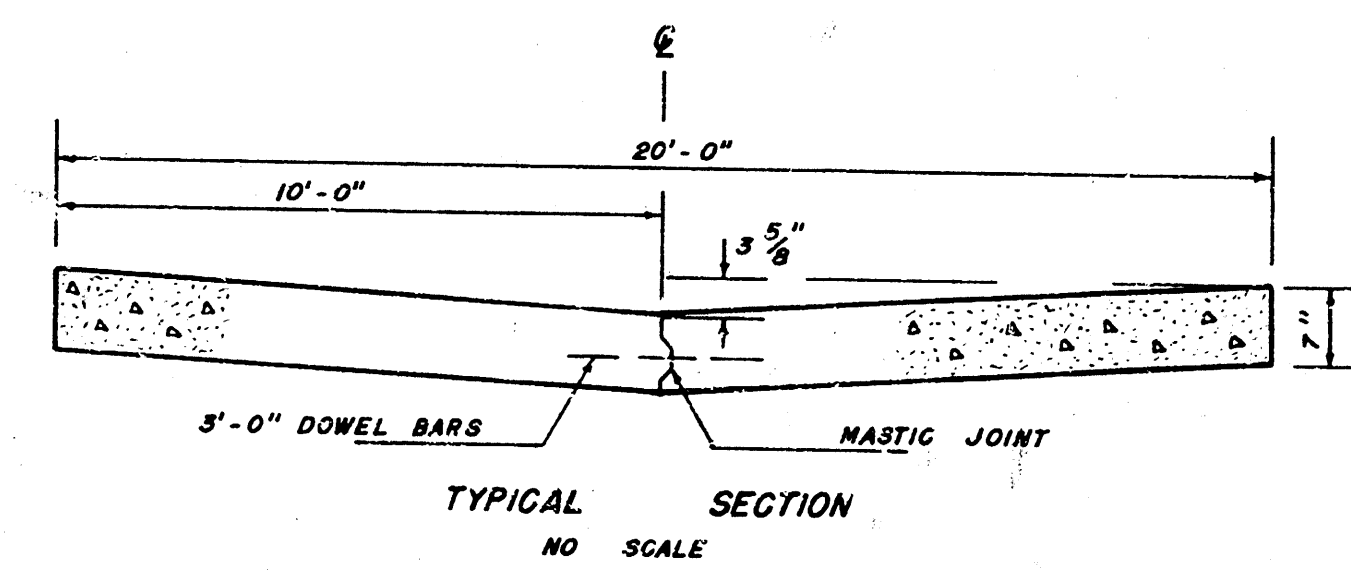

| LIST OF QUANTITIES |          |             | FINAL    |
|--------------------|----------|-------------|----------|
| 1030.0             | SQ YDS   | PAVEMENT    | 1,040.35 |
| 178.6              | CU YDS   | EXCAVATION  | 162.50   |
| 3.6                | CU YDS   | COMP. FILL  | 3.30     |
| 460.0              | LIN FEET | MASTIC      | 863.04   |
| 6705.0             | LBS      | REIN. STEEL | 6,930.45 |

**ALLEY E. OF WOODLAWN**  
 N.L. CENTRAL TO N.L. ALLEY N. OF CENTRAL.  
**20' - 7" CONC-PAVEMENT**  
 B.E. SMITH CITY ENGINEER  
 CITY OF WICHITA, KANSAS  
 DATE: 4-1-1965 PRIVATE PROJECT