1941

ALLEY BETWEEN EMPORIA + TOPEKA FROM S.L. OF E-W. ALLEY TO 150' S.

20' CONC.

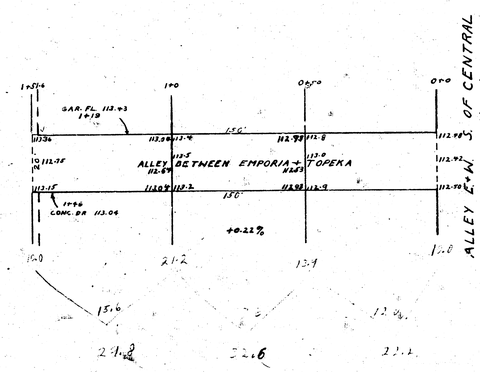

P-P
21.8
22.6
22.2
24.6
+12.3
93.1

B.M. 112.92 BK OF WK. S.E. COR. TOPEKA + CENTRAL