


INTERSECTION 2ND & RIDGEWOOD 26' 30' Conc. ~~Exp.~~
 BM Elev. 105.31 3' ch. 2nd WL Ridge Wood (W.G. in Globe)

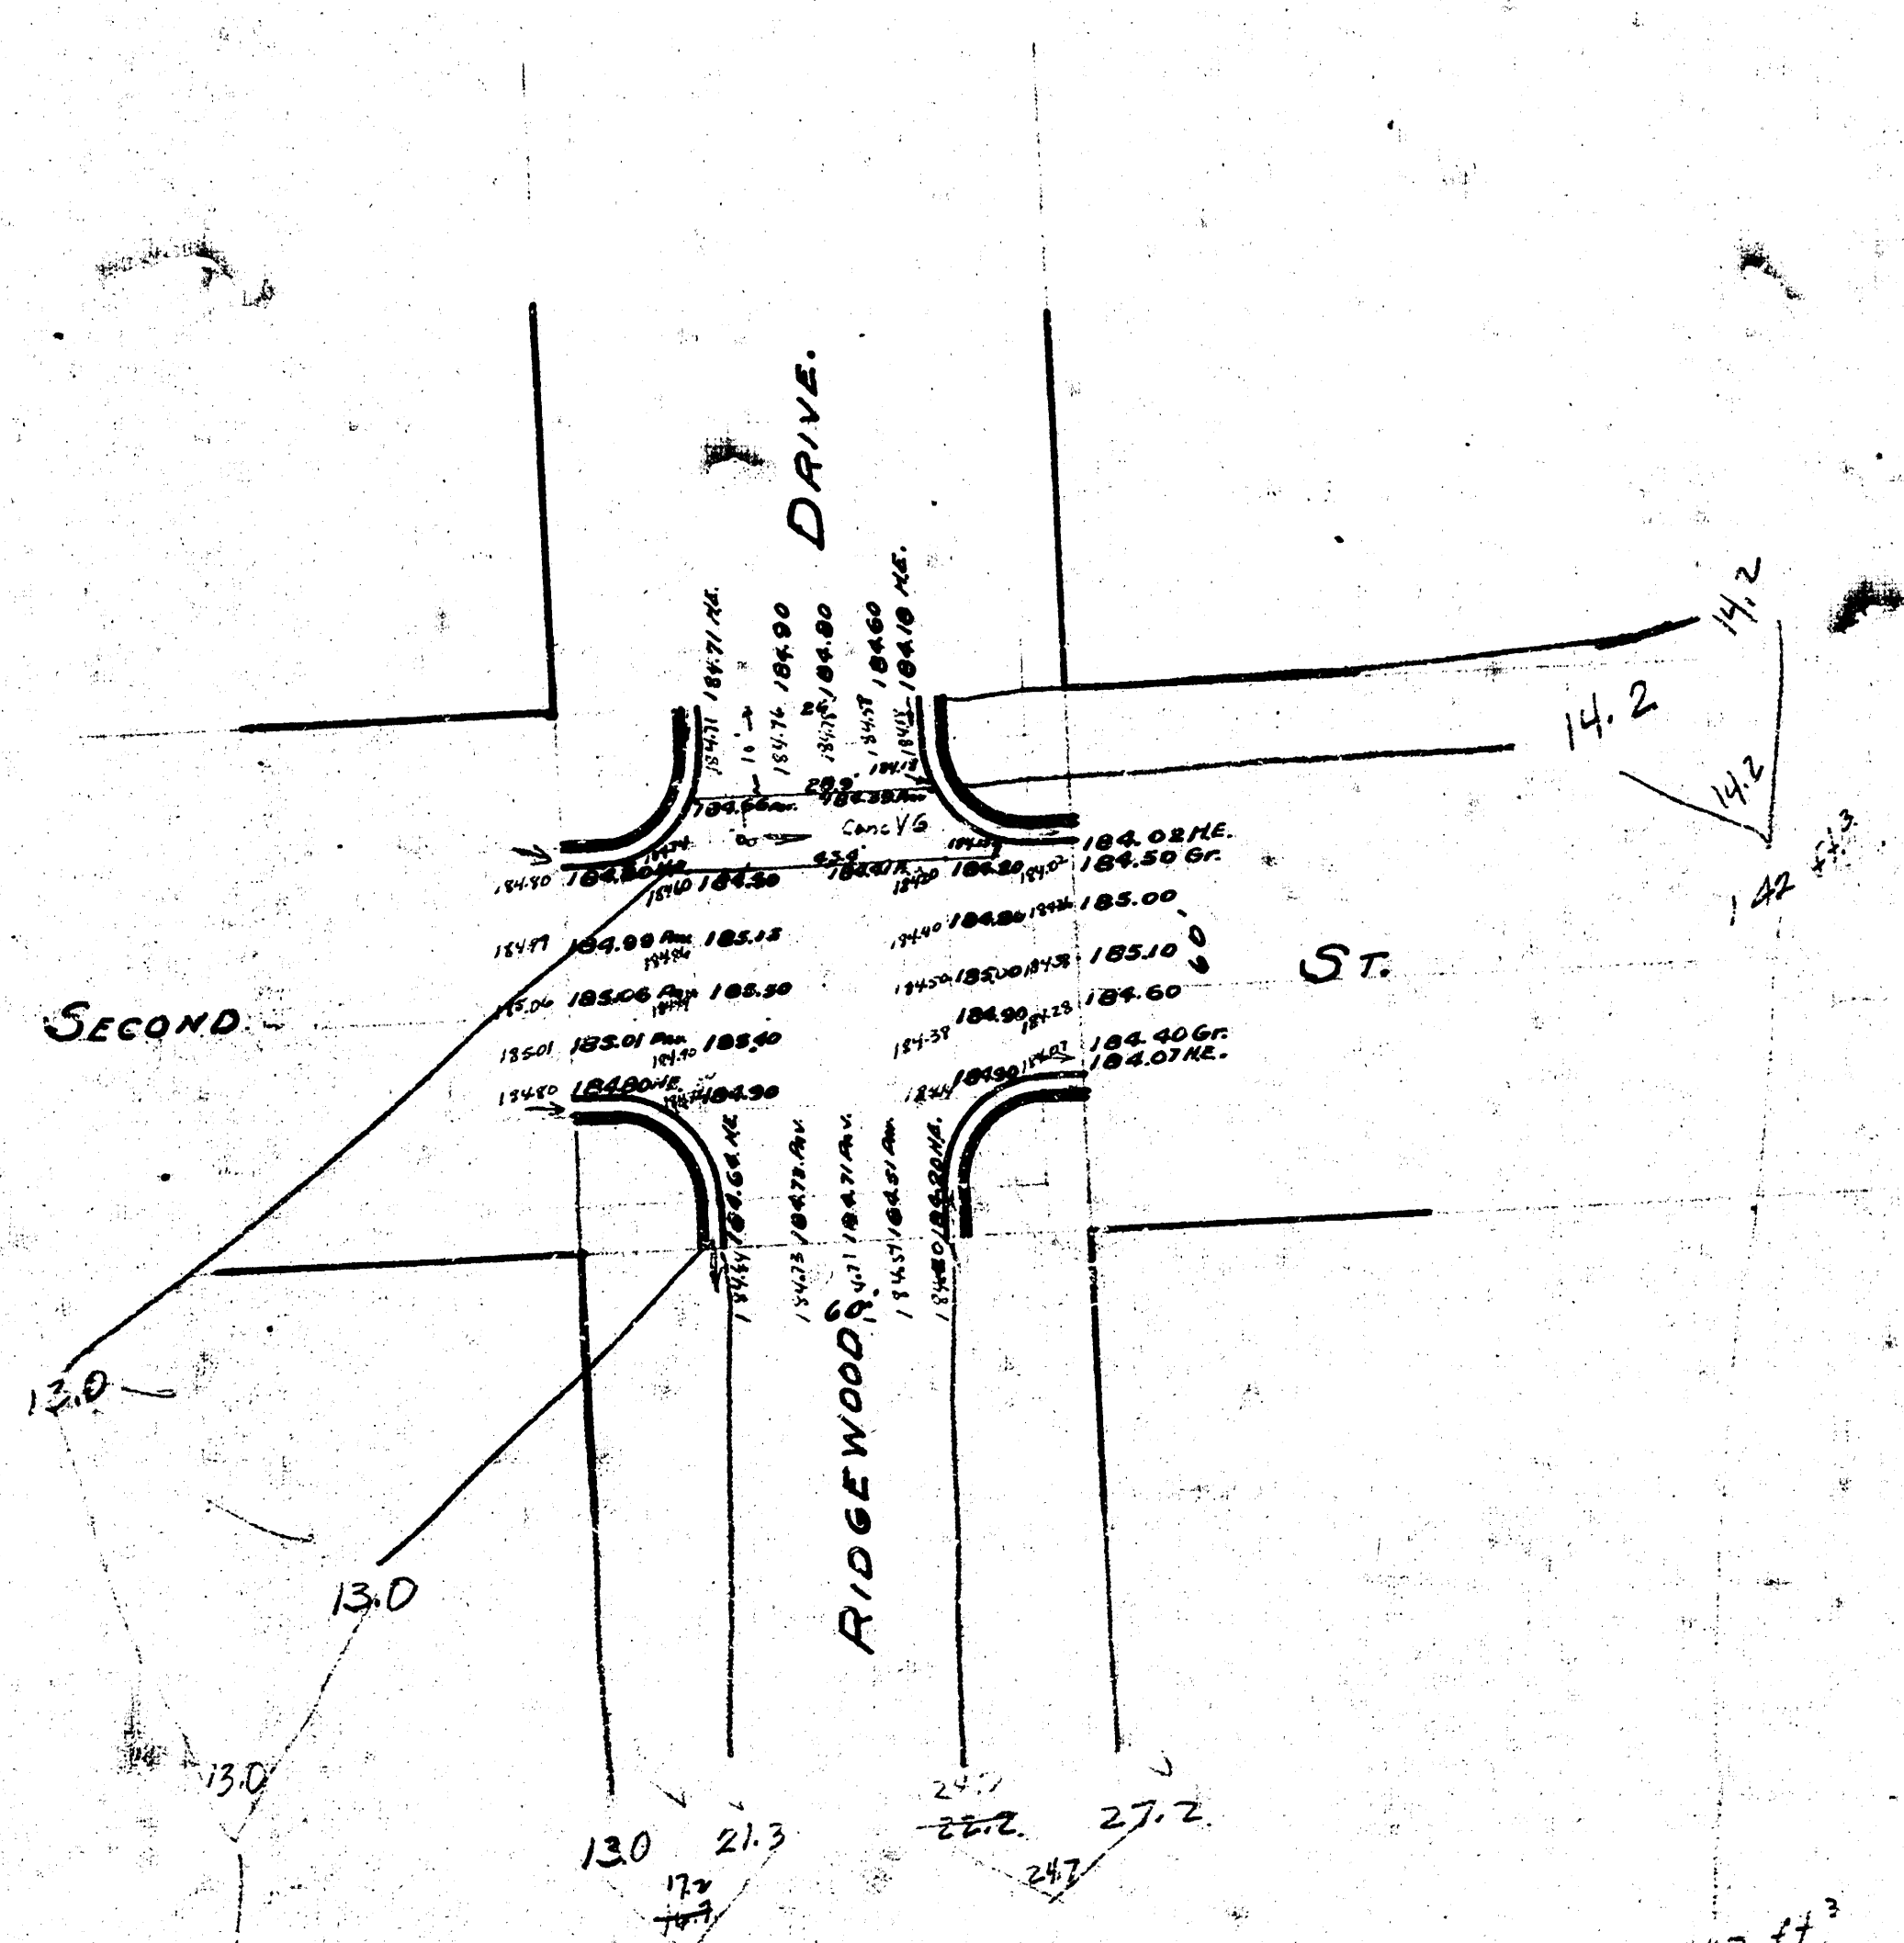

546.432
 20.2 yds
 200.4 ft
 7.4 yds
 296.4 ft
 11.0 yds
 2.2 ft
 5.3 yds
 City 43.9 yds + 4.4 = 48.3 cu yds Eq

Paving Plan
 Intersection
 2nd & Ridge Wood
 1940