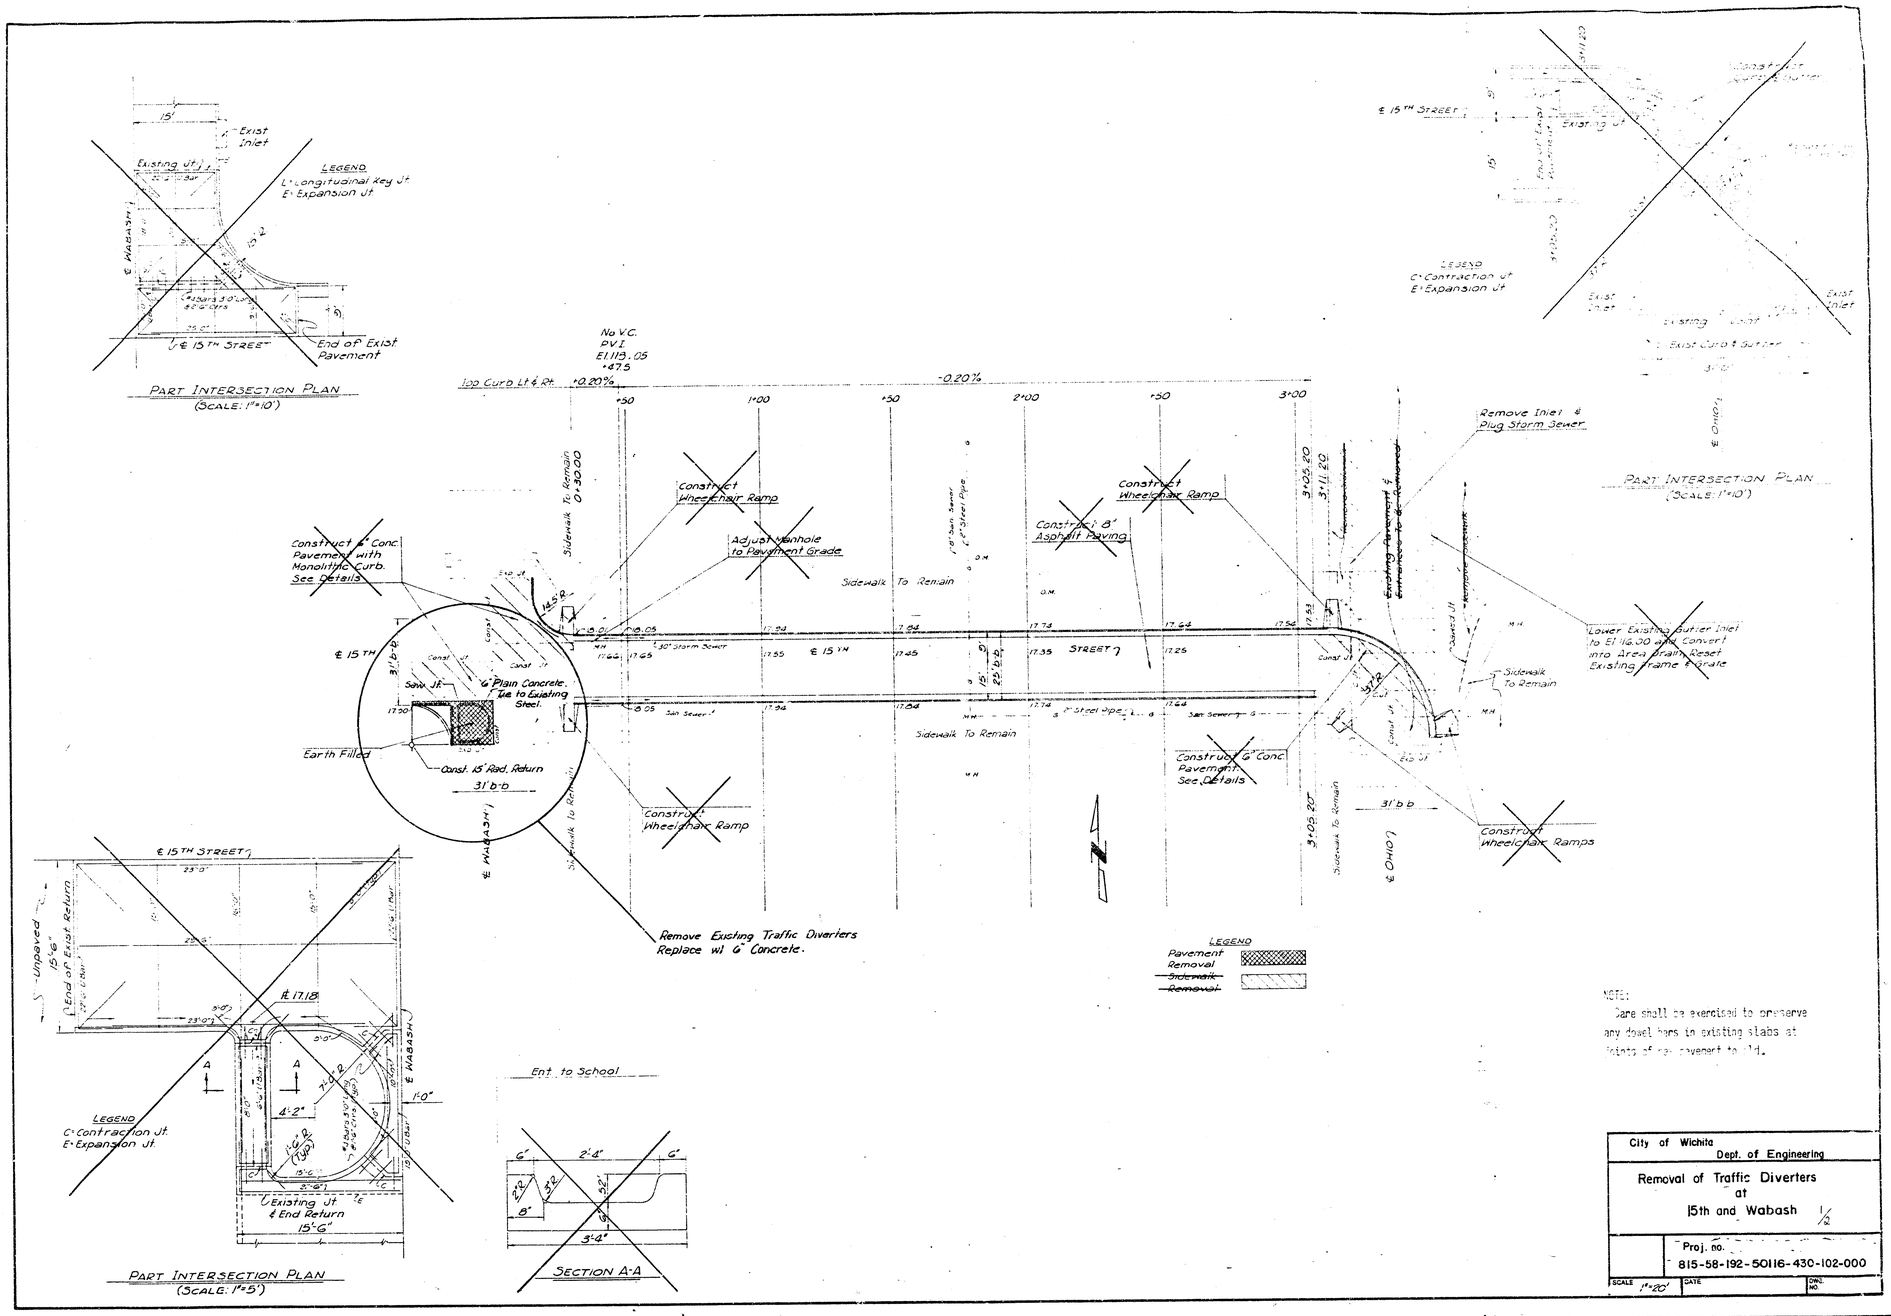

NOTE:
Care shall be exercised to preserve any dowel bars in existing slabs at joints of new pavement to old.

City of Wichita Dept. of Engineering	
Removal of Traffic Diverters at 15th and Wabash 1/2	
	Proj. no. 815-58-192-50116-430-102-000
SCALE 1"=20'	DATE / DWG. NO.

FILMED FROM THE BEST AVAILABLE COPY....

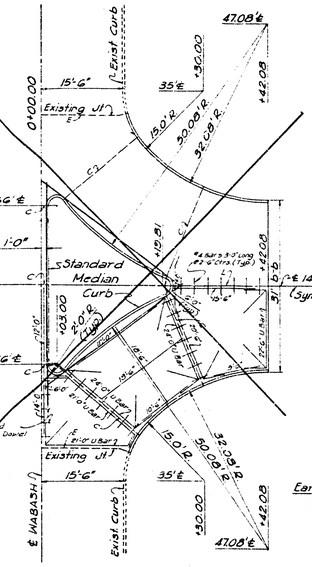

LEGEND
C = Contraction Jt.
E = Expansion Jt
L = Longitudinal Key Jt.

PART INTERSECTION PLAN
(NOT TO SCALE)

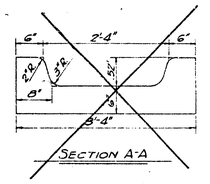

SECTION A-A

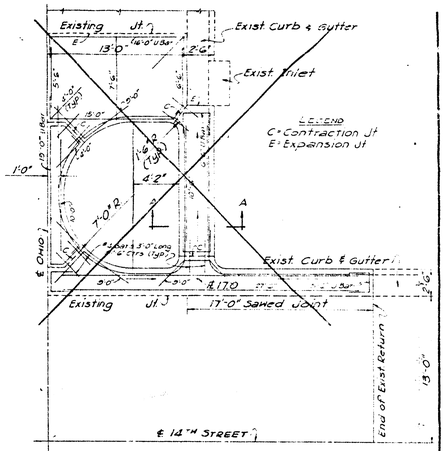

PART INTERSECTION PLAN
(SCALE: 1"=5')

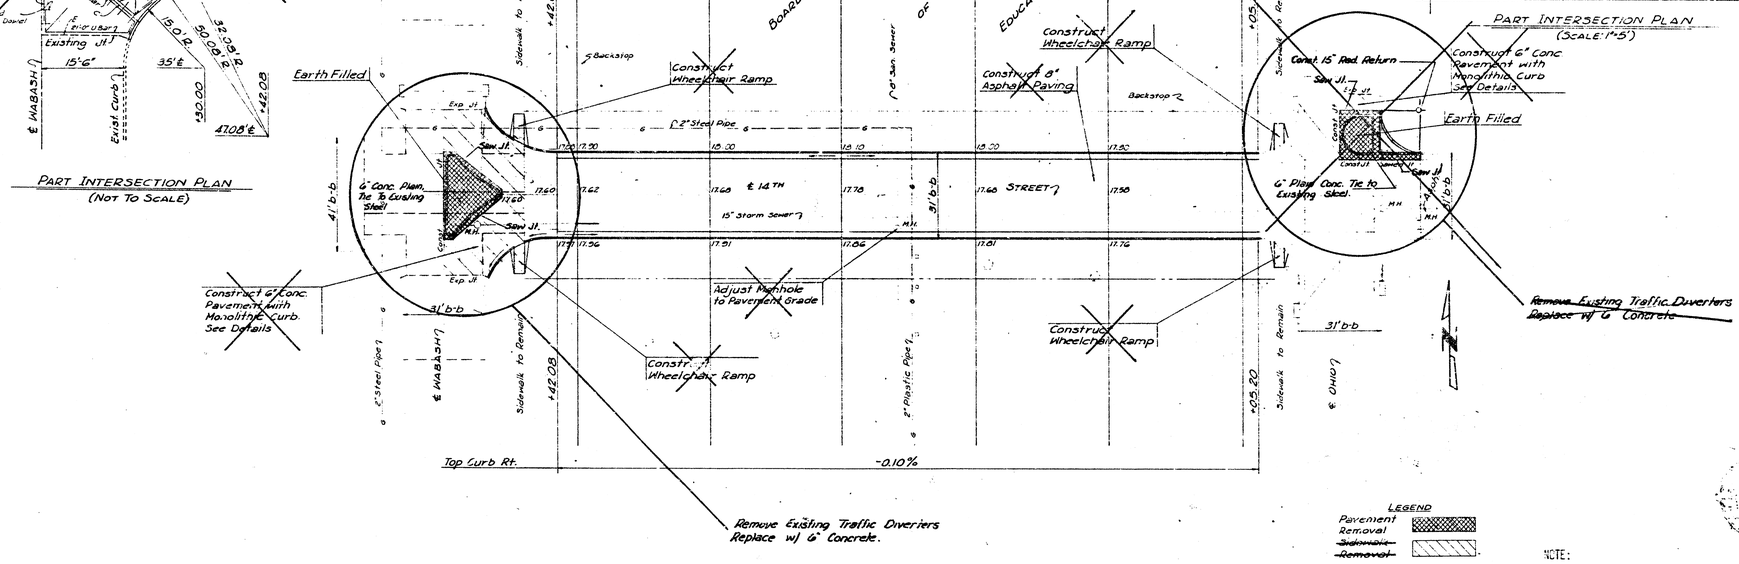

LEGEND
Pavement Removal
~~Sidewalk Removal~~

NOTE:
Care shall be exercised to preserve any dowel bars in existing slabs at joints of new pavement to old.

City of Wichita — Dept. of Engineering	
Removal of Traffic Diverters at 14th and Wabash	
2/2	Proj. no 815-58-192-50116-430-102-000
SCALE 1"=20'	DATE

FILMED FROM THE BEST AVAILABLE COPY....