


B.M. 174.62 Top of Prop. Iron NW Cor. Ridgewood & Courtleigh Dr.

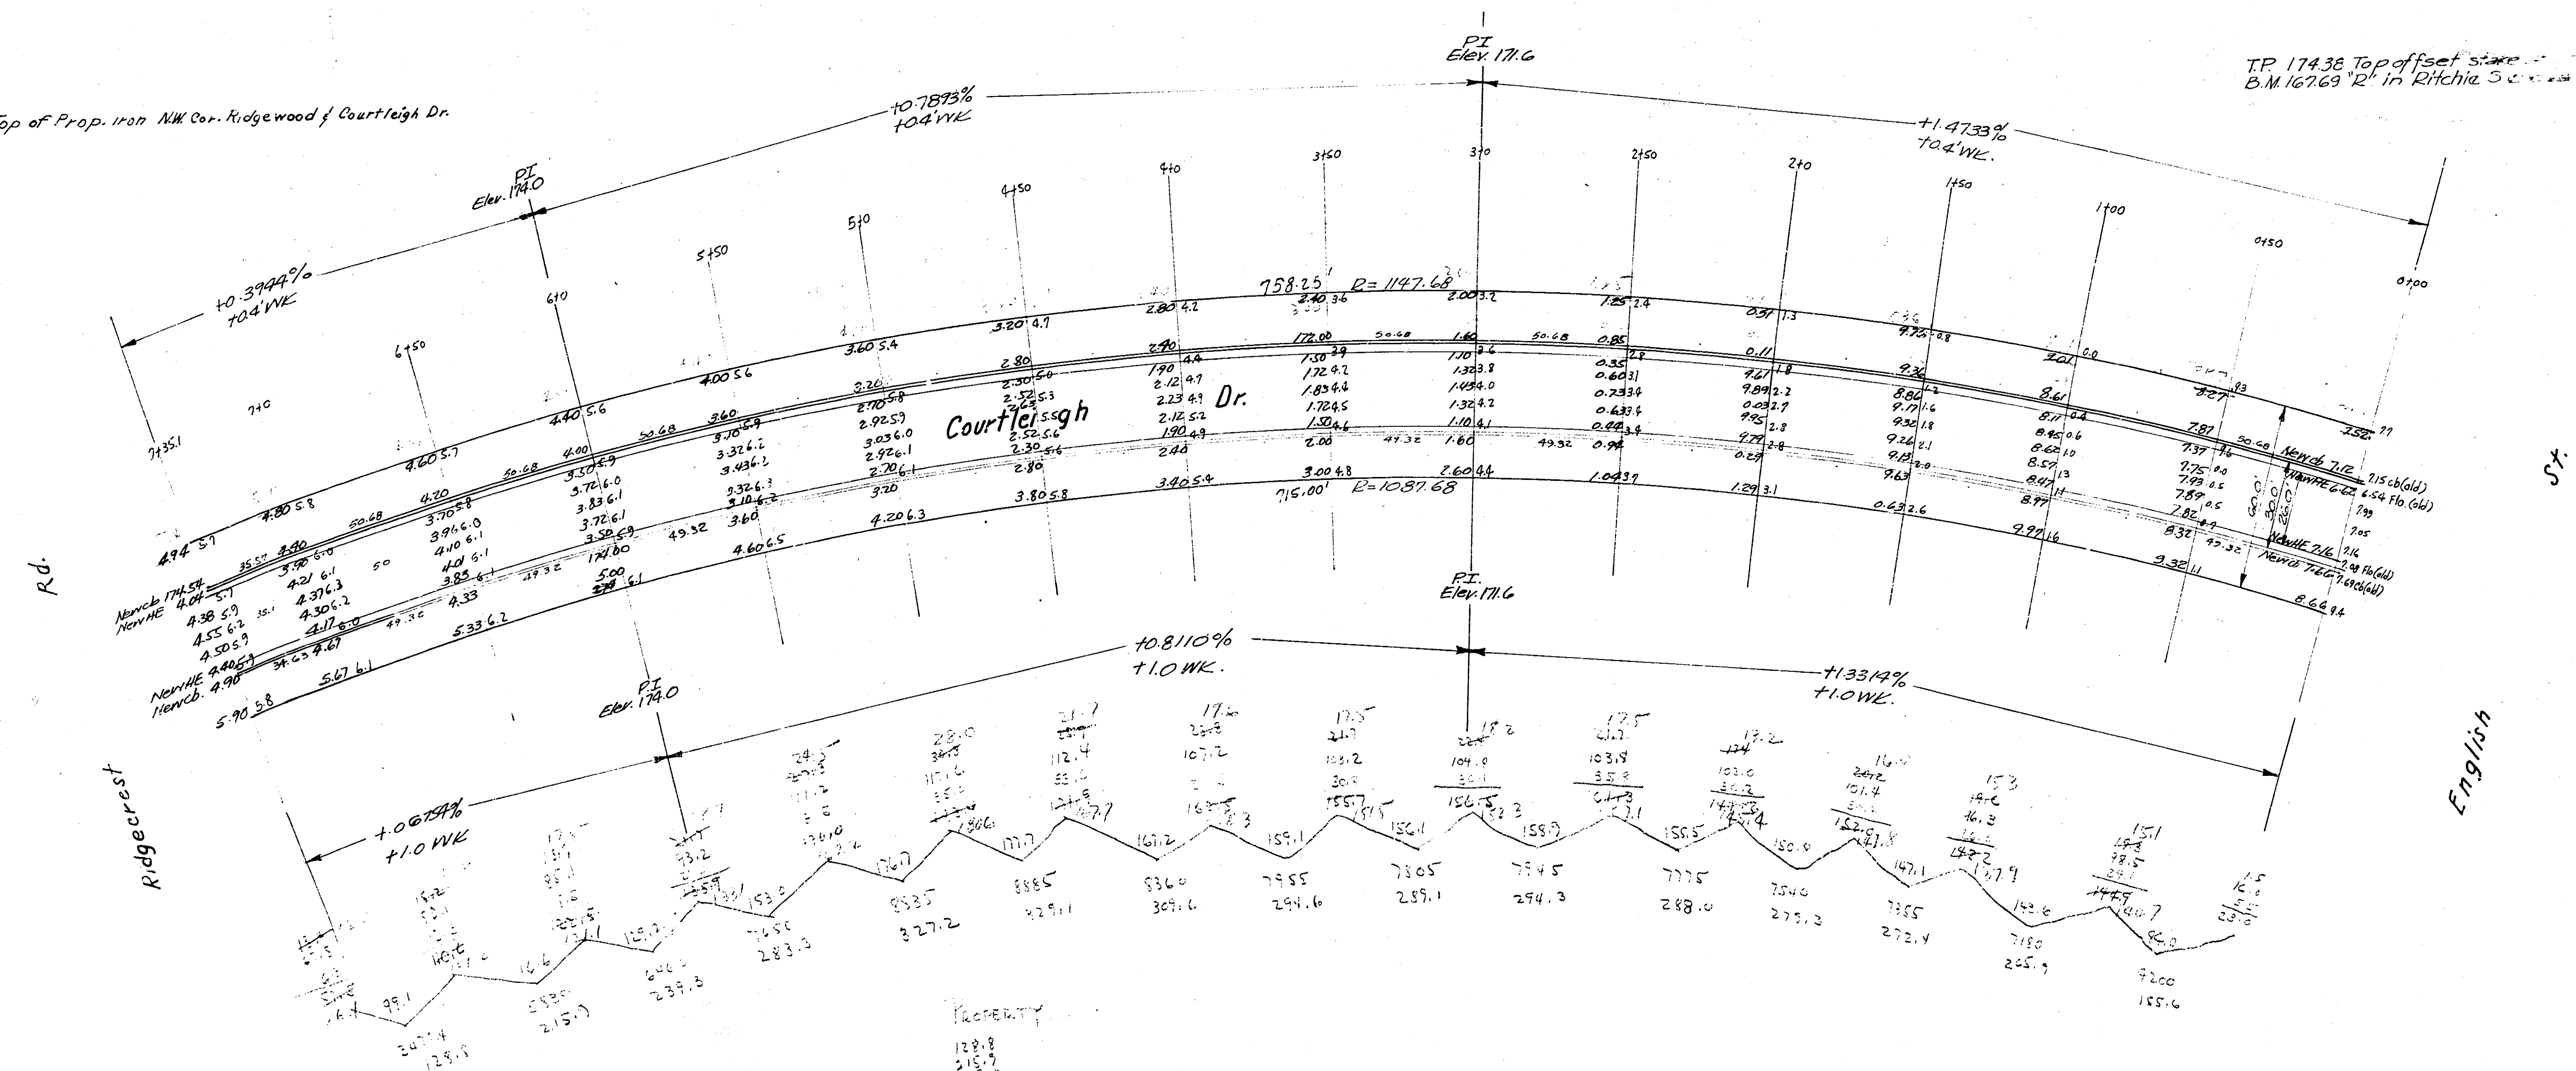

