

Surveying
 Plan
 Sec. 1
 (Check)

- NOTE: CONTRACTOR TO CLEAR RIGHT-OF-WAY, GRADE PARKING, & COMPACT FILL IN SIDEWALK AREAS. SIDEWALK TO BE CONSTRUCTED BY "OTHERS".
- NOTE: INLETS & STORM SEWER TO BE CONSTRUCTED BY "OTHERS" PRIOR TO CONSTRUCTION OF THIS PROJECT.
- NOTE: FIELD ENGINEER SHALL DETERMINE WHICH PORTIONS ARE TO HAVE LINE TOLERATED SUB-GRACE AND WHICH ARE TO BE SUB-GRACE MODIFIED.
- NOTE: ELEVATION ELEVATION FROM THIS PROJECT SHALL BE STOCKPILED AT LOCATIONS DETERMINED BY THE ENGINEER, IN WESTLINK VILLAGE TENTH ADDITION.
- NOTE: ROLL-TYPE COMB CURB & GUTTER TO BE USED THROUGHOUT PROJECT EXCEPT AS NOTED.
- NOTE: TRANSITION FROM FULL CURB & GTR. TO ROLL CURB & GTR. SHALL BE PRD AS LIND. 71 COMB. CURB & GUTTER.
- NOTE: BASELINE = C. CRESTLINE CIRCLE.
- NOTE: SANITARY SEWER TO BE CONSTRUCTED BY "OTHERS" PRIOR TO CONSTRUCTION OF THIS PROJECT.

CURVE DATA BASED ON $\frac{1}{2}$ RADIUS = 150.00'

$\Delta = 18^{\circ} 50'$ 11.4551 MIN/111 ARC.

STATION	APC	CHORD	LENGTH	DEFLECTION	TOTAL DEFLECTION
D.C. 2181.05					
3105.88	24.17'	20.95'	27.55'	4' 31"	0' 00' 00"
P.T. 3129.40'	24.18'	20.94'	27.55'	4' 31"	0' 14'

CURVE DATA BASED ON $\frac{1}{2}$ RADIUS = 149.95'


$\Delta = 18^{\circ} 50'$ 11.4553 MIN/111 ARC.

STATION	APC	CHORD	LENGTH	DEFLECTION	TOTAL DEFLECTION
D.C. 3129.87'					
3188.04'	24.17'	20.95'	27.55'	4' 31"	0' 00' 00"
P.T. 3213.41'	24.17'	20.95'	27.55'	4' 31"	0' 20'

N
 SCALE 1"=20'

B.M. 151.858 ~ R.R. SPK. N.E. FACE PP 25 FT. SOUTH & 7 FT. WEST
 OF IRON N.W. COR. LOT 1 BLK. 8

NOTE TO CONTRACTOR:
ELEVATION OF MANHOLES IN
PARKING TO BE ESTABLISHED BY
FIELD ENGINEER.

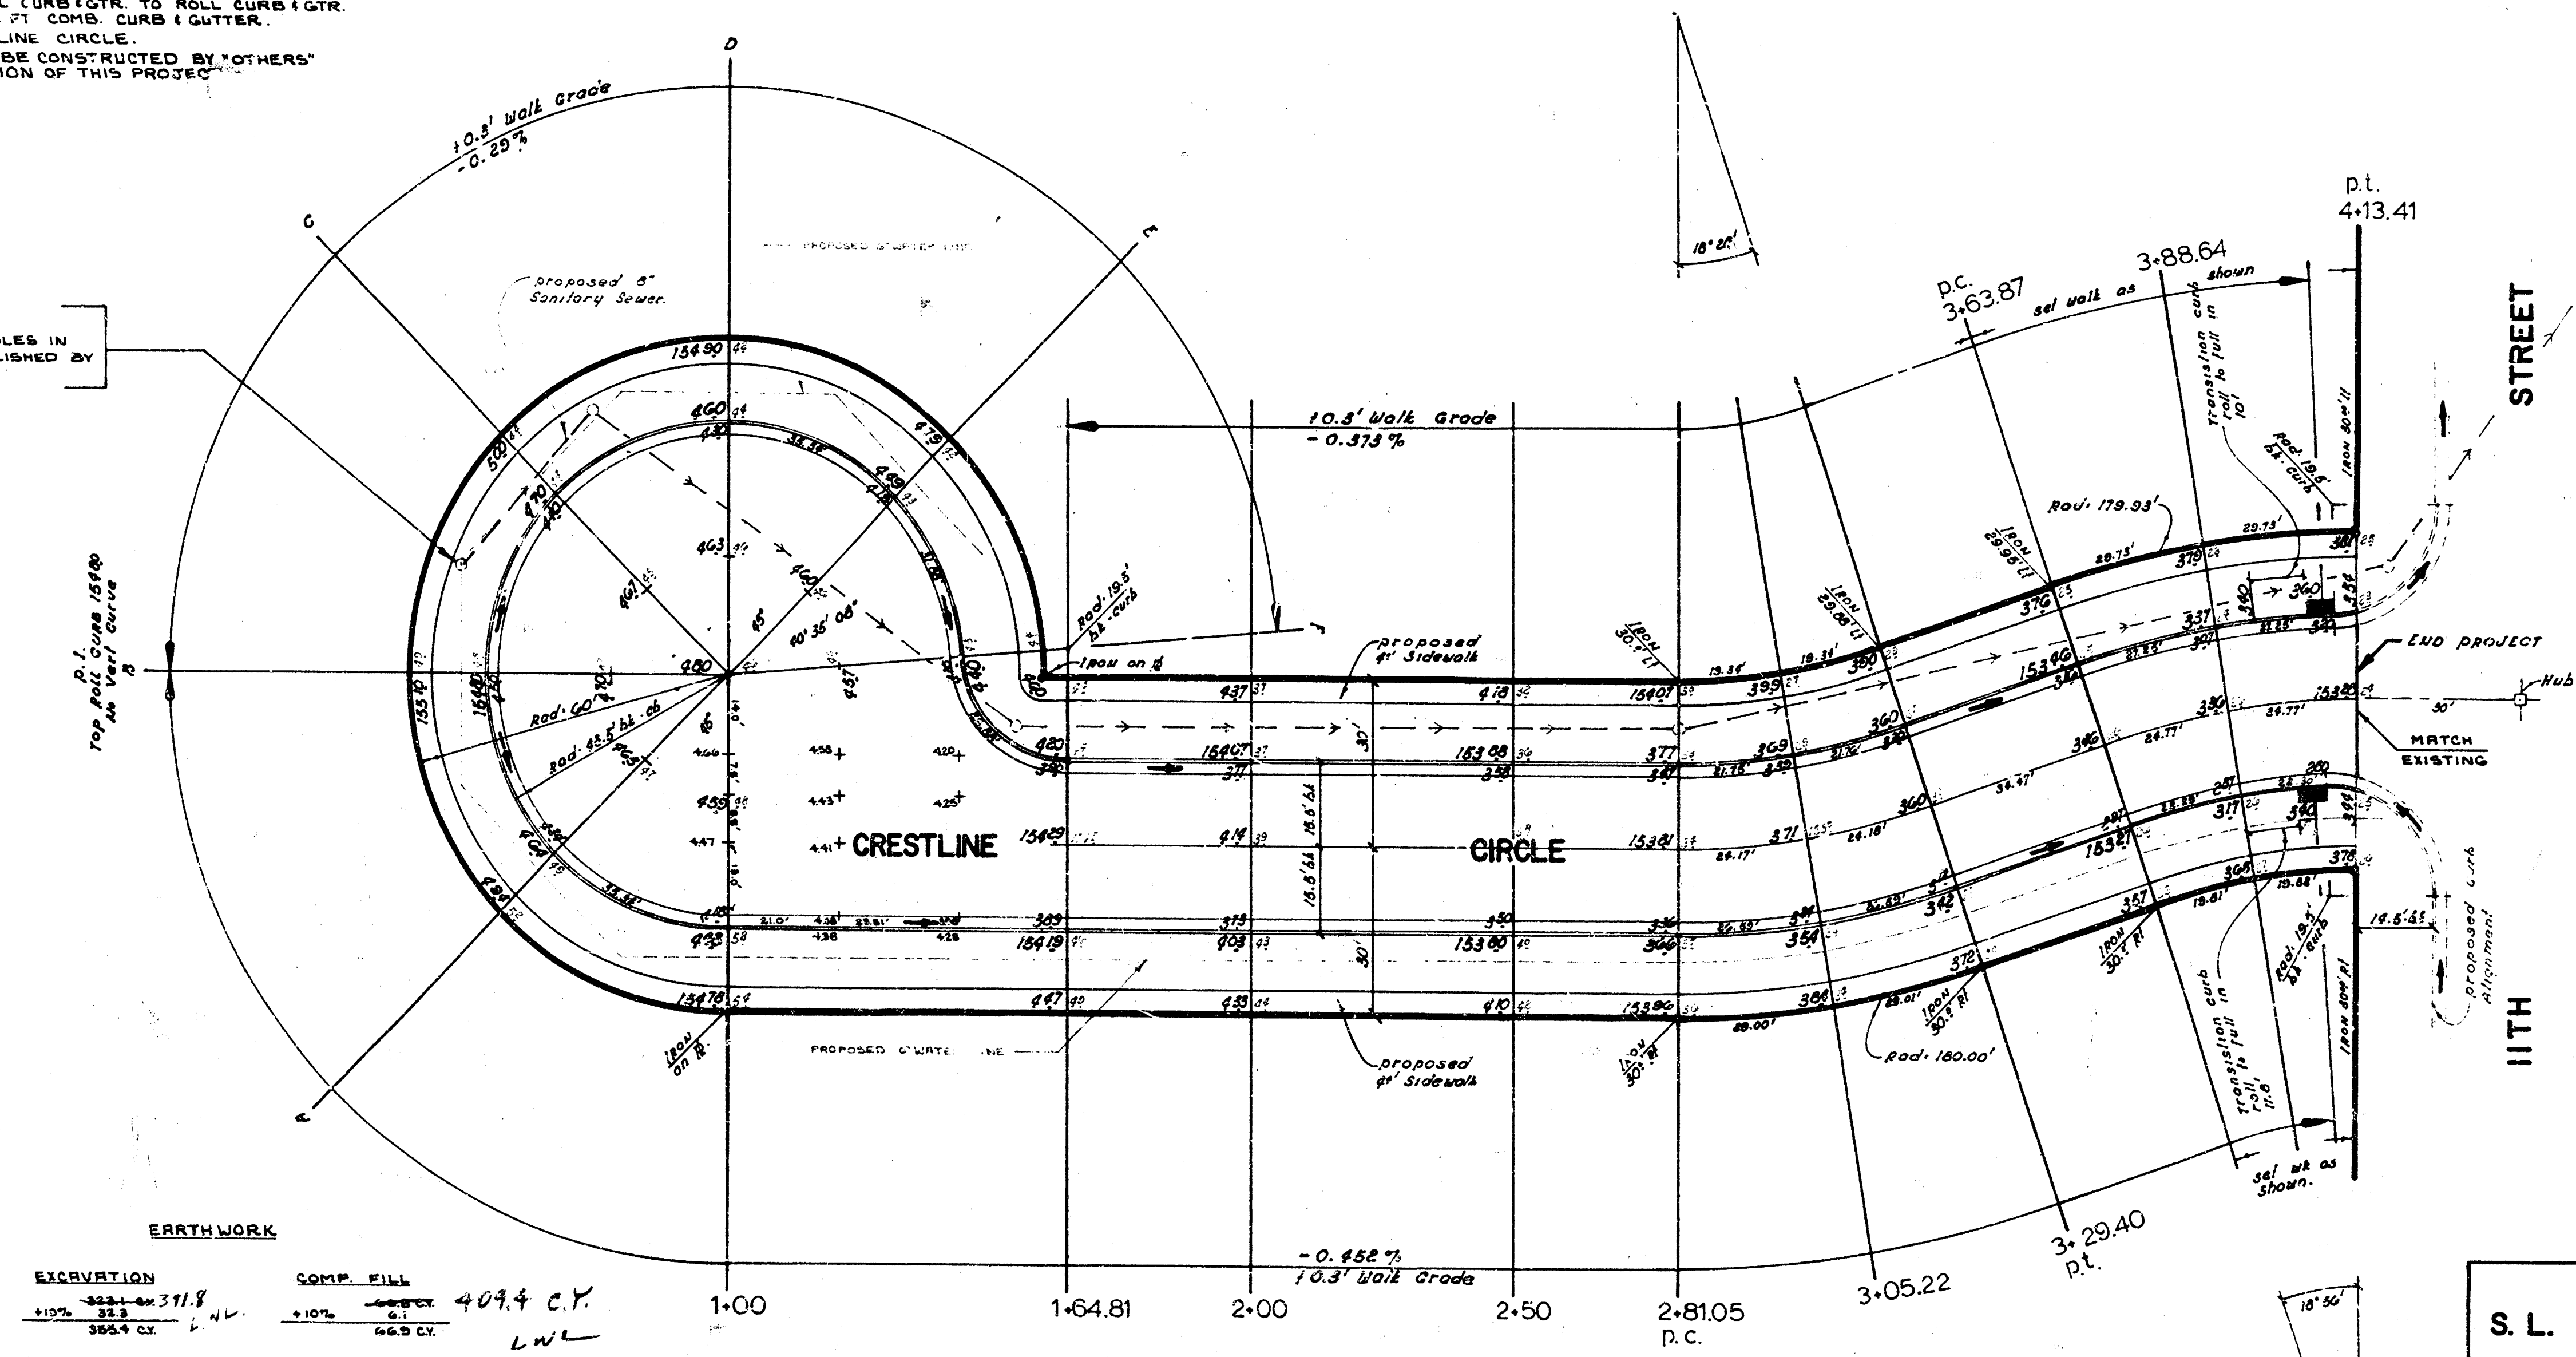

EXCAVATION 33.3
 365.4 CY
 COMP. FILL 409.4 CY
 46.5 CY
 L.W.

CRESTLINE CIRCLE
 S. L. 11TH ST. TO & INCLUDING
 CUL-DE-SAC
 ASPHALTIC CONCRETE PAVEMENT
 31" B-B (Roll Type Comb Curb & Gtr.)
 CITY OF WICHITA, KANSAS
 R. W. LINN CITY ENGINEER
 PROJ. NO. DAKS 572034
 DATE: