




Surveyed by Young & Son, Inc.
 Checked by E.L. Capri
 City Engineer

B.M. 164.50 "R" in Ritchie E.L. Capri
 N. Curb Zimmerly

B.M. 155.31 "R" in Ritchie top S. Curb
 Bayley - E.L. Capri

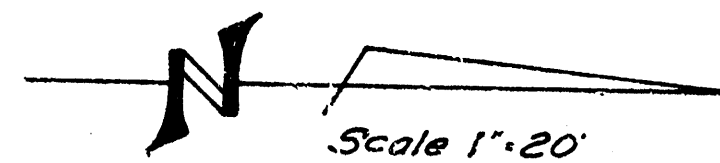


Baseline - W Property Line Dalton Drive

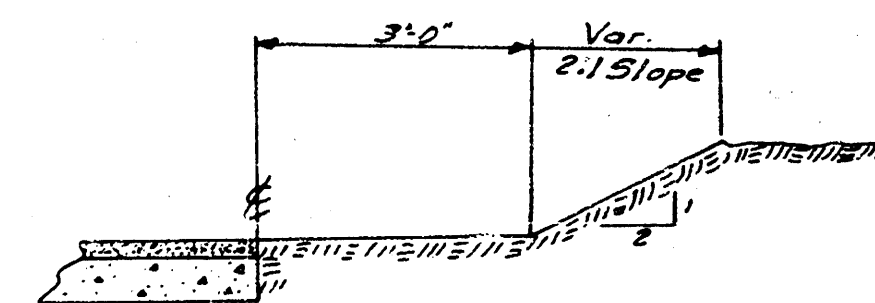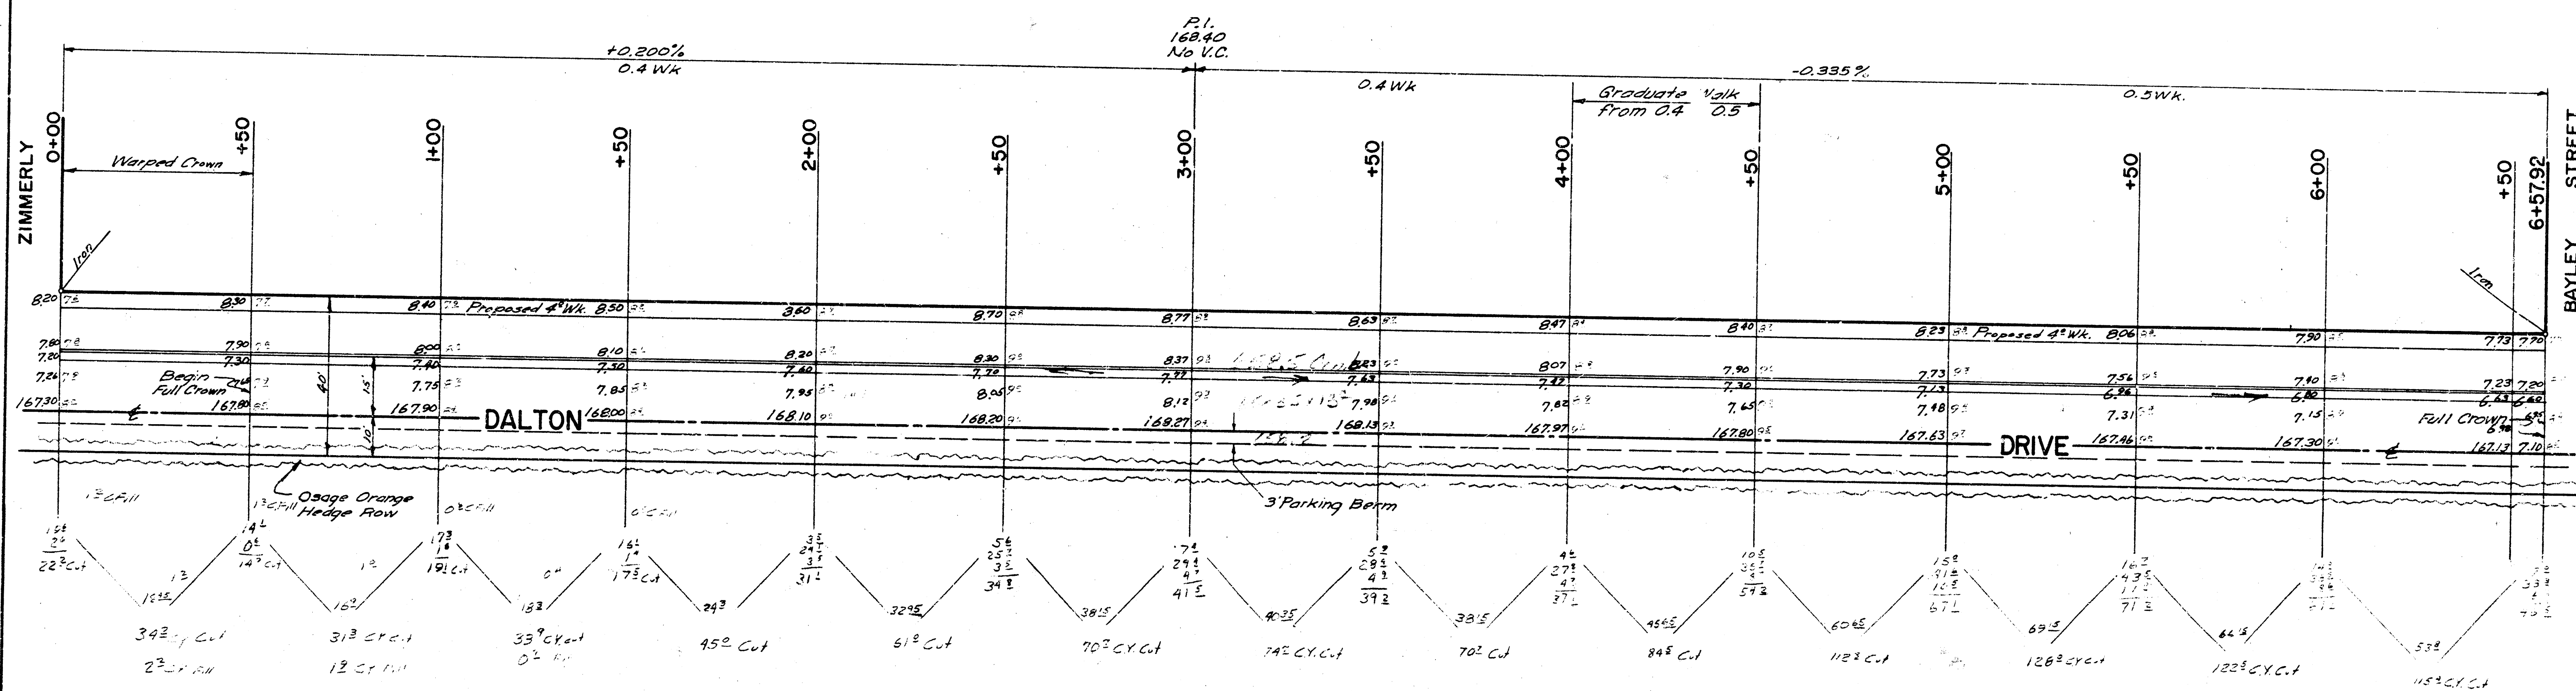

TYPICAL 3' PARKING BERM

Estimated Quantities		
Est.	Item	Final
955	Sp. Vls. Asphalt Comp. Pavement	370.1
440	Lin. Ft. Comp. Curb and Gutter	158.2
200	Lin. Ft. Separate Curb	---
550	Lin. Ft. Separate Gutter	---
1650	Sp. Ft. 6" Drive	---
810	Lin. Ft. Marble Joint	153.4
3850	Lbs. Reinf. Steel	252.0
985	Cu. Yds. Excavation	165.4
5	Cu. Yds. Comp. Fill	6.6

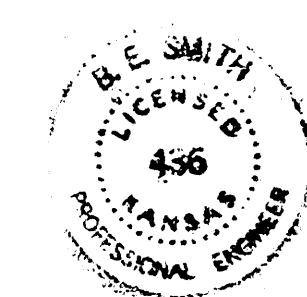

W 1/2 DALTON DRIVE
 From N.L. ZIMMERLY ST.
 To S.L. BAYLEY ST.
 13'-2'-15' A.C.

B.E. SMITH CITY ENGINEER
 CITY OF WICHITA, KANSAS
 DATE PRIVATE JOB

1/1

11 5 5 2