


S. Sec. 17
Richardson

B.M. 90.27 "P" in P.K.S. S. Co. Catalina / S.W. Cor. Pattie. (Used)

Station On N.R.

Note:
Drive way grades were set, but builder did not follow these grades.
Do Not Match Driveways.

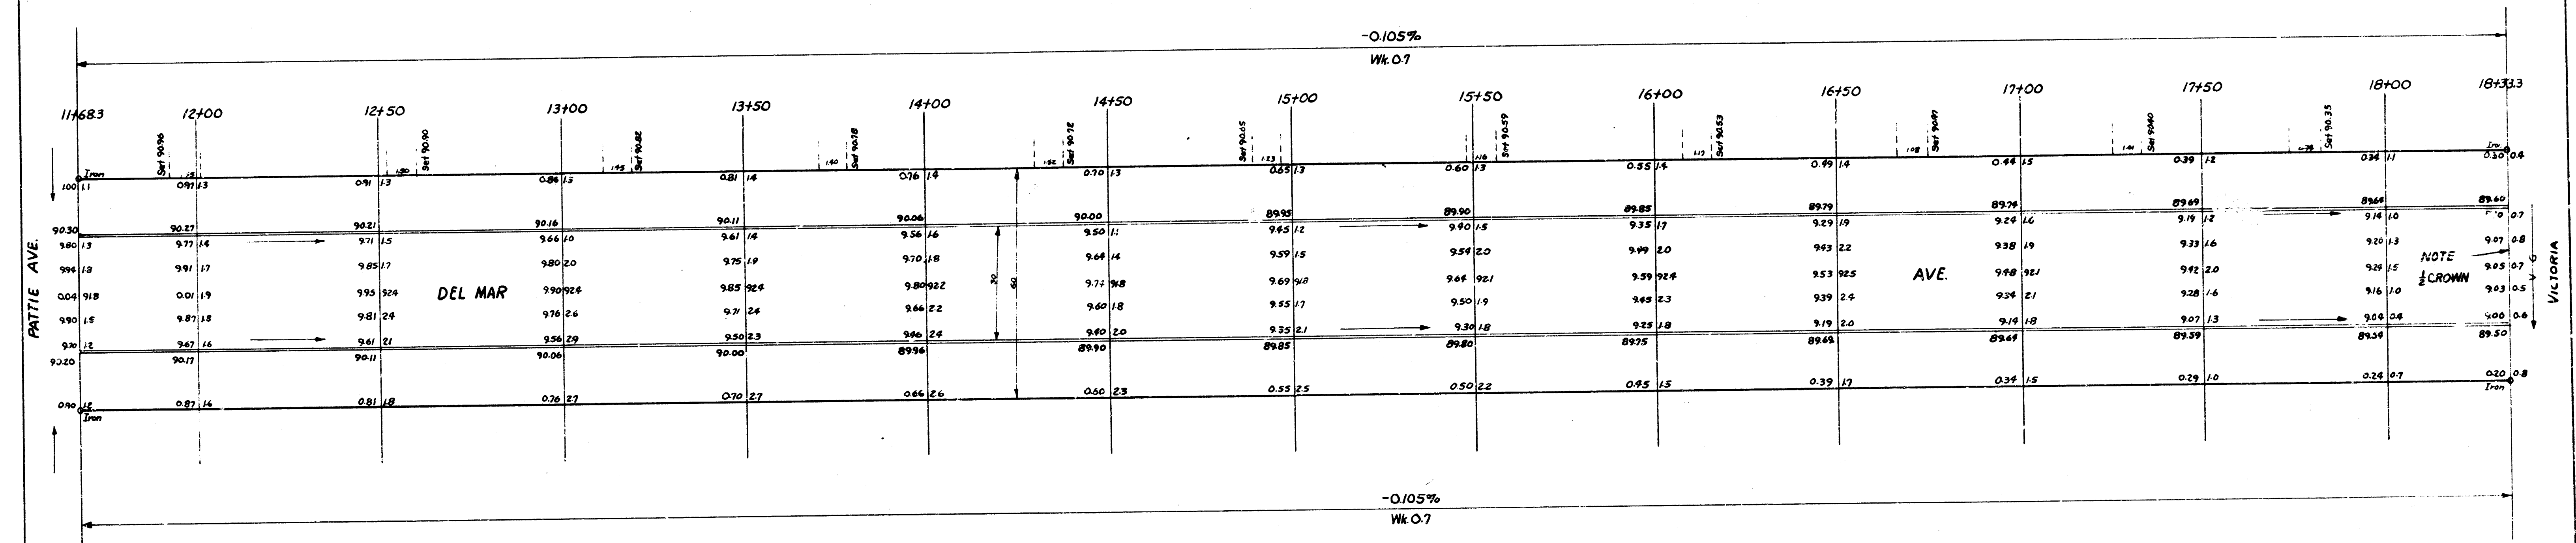

DEL MAR AVE.
E.L. PATTIE To W.L. VICTORIA
30 CONC. & C.B.
CITY OF WICHITA KANSAS
B.E. SMITH CITY ENGINEER
APRIL 1955 Proj. No. C14-142