B.M. = 89.37 'C' in GLOBE. S. end of S.C. return - Intersection DEL MAR and VICTORIA.
E. el. = 90.78 R.R. Spike in W. side P. Pole. E. Side HYDRAULIC - N.L. CATALINA.

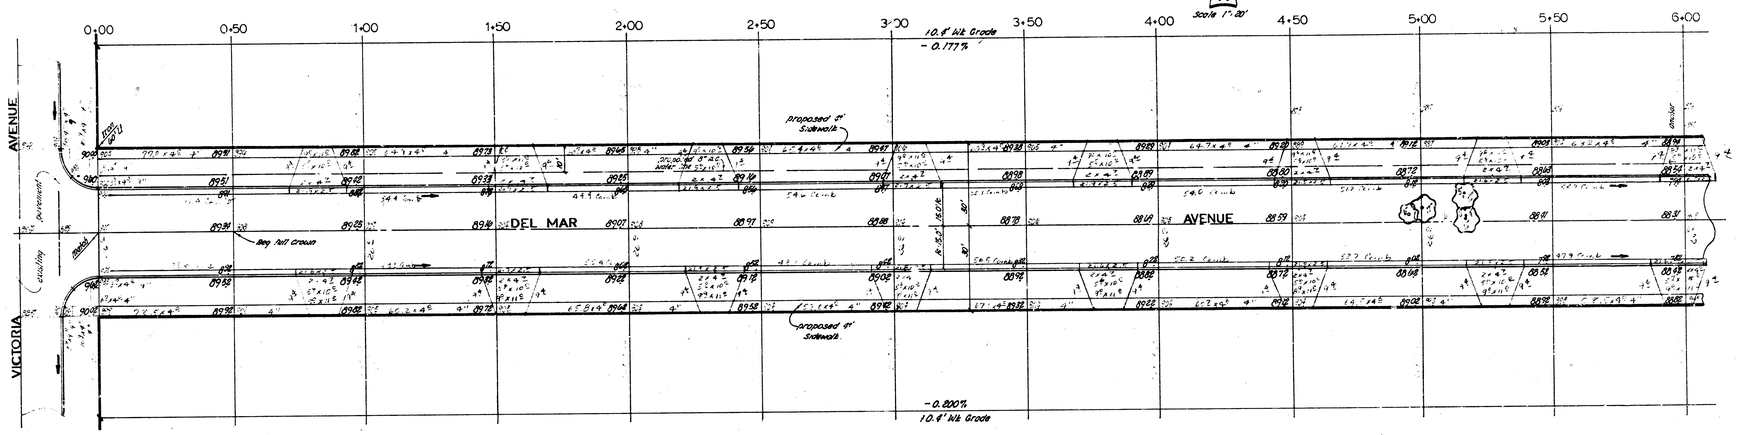

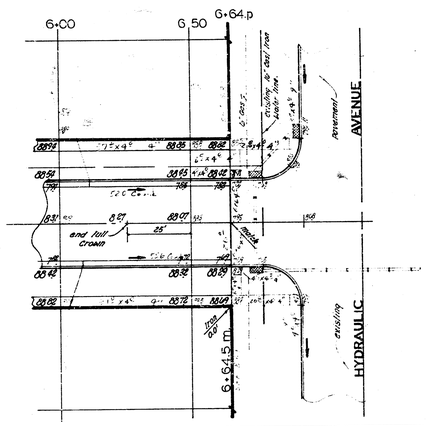

NOTE TO FIELD ENGINEER and CONTRACTOR
Sub grade modification or cement treated subgrade will be required as directed by the Engineer.

"SIDEWALK"
Grade parkway and clear right of way for proposed sidewalk. Compact fill in sidewalk area. Work by Others".

DEL MAR AVENUE
E.L. Victoria Ave to W.L. Hydraulic Ave.
CITY OF WICHITA, KANSAS
B.E. SMITH City Engineer
Date FEB. 1971 Private Project