

BM--103.95 "G" in Globe E' cb. Fern # NL Dora.

BM--104.23 "G" in Globe W' cb. Elizabeth # NL Dora.


NOTICE TO FIELD ENGINEER & CONTRACTOR:-

Extreme care must be exercised in setting and pouring Valley gutter on the N side of Fern. All cross-hatched areas to be removed and replaced with Conc. & Int. cb. Engineer is to measure removal quantities before replacement.

NOTICE TO CONTRACTOR:-

All entrance pipes to be disposed of in accordance with instructions of Dirt Checker.

Existing
Top
173.4
173
173.3 C. 10.
154.0
154.15
169.85 + 10.

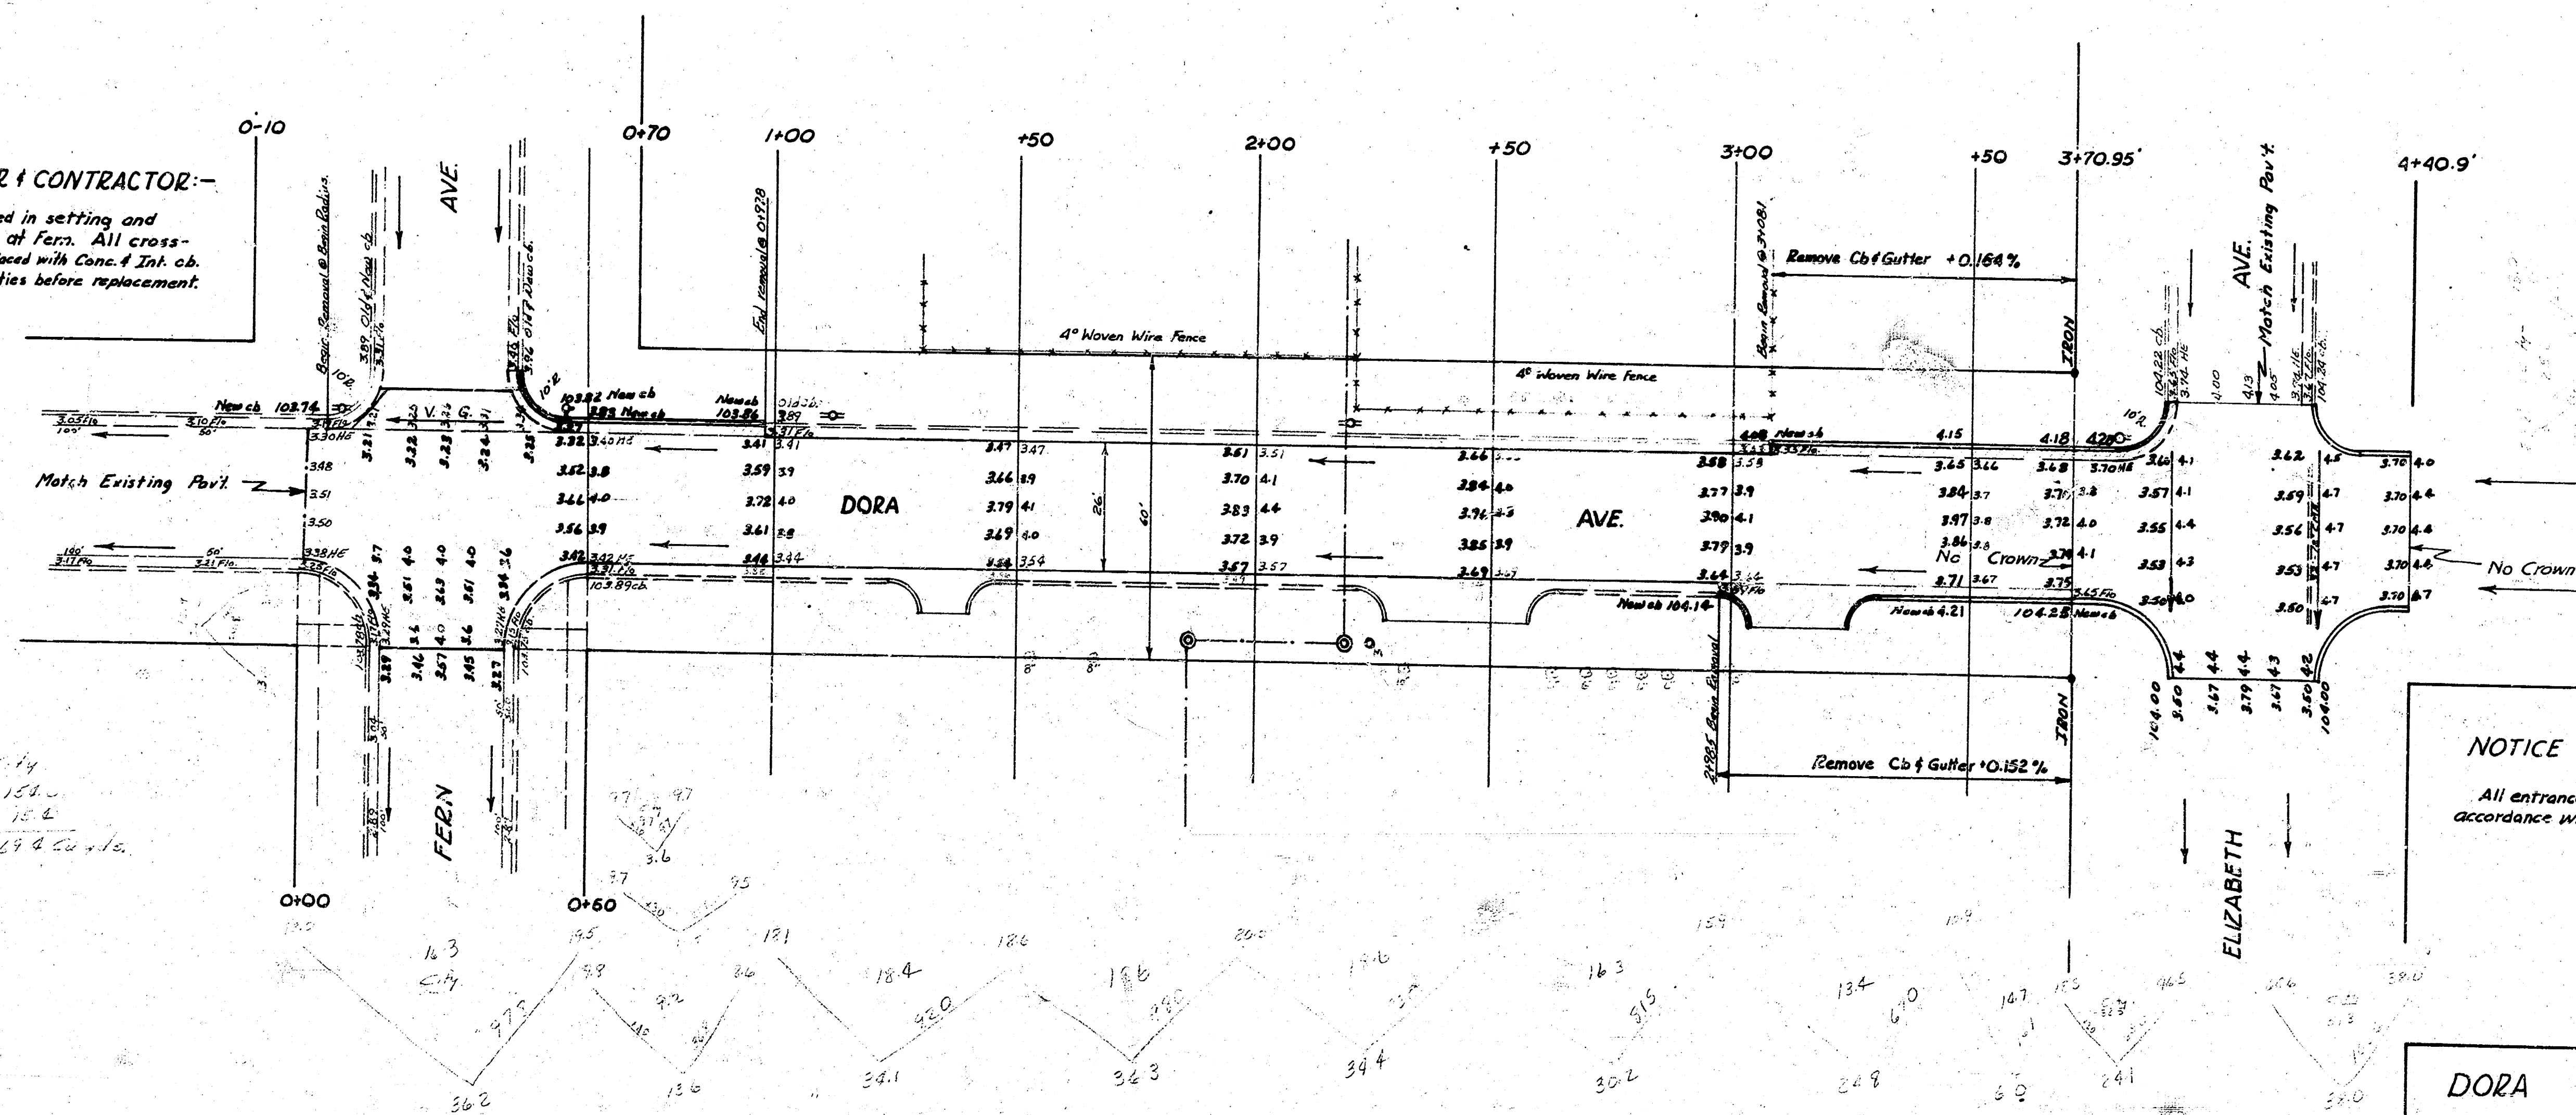

DORA AVE.
WL Fern to EL Elizabeth
26" Conc.
CITY OF WICHITA, KANSAS
B.E. SMITH CITY ENGINEER
APRIL 1956 PROJ. NO. C15-281



SAVED: Hanson WA 2433
L. H. Greene
L. H. Greene
L. H. Greene