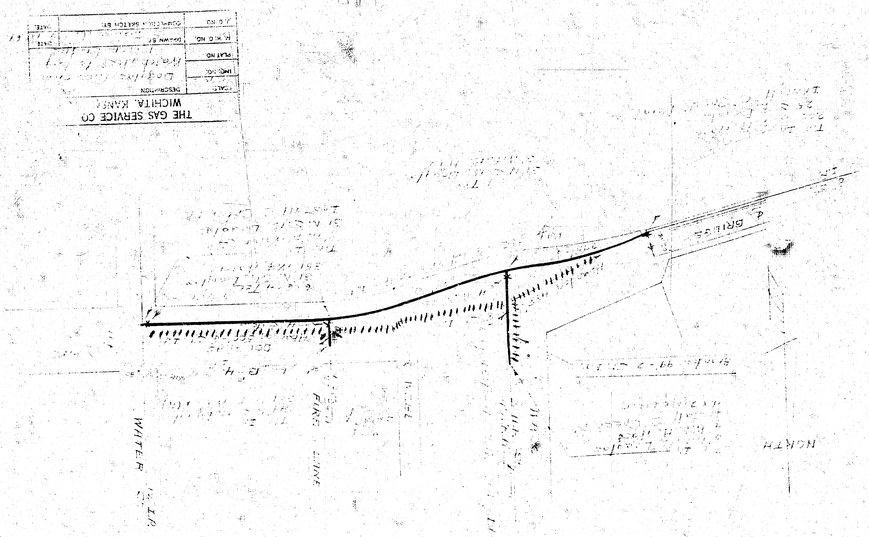
THE GAS SERVICE CO
WICHITA, KANSAS
DESCRIPTION
DATE
APPD
CHKD
PLAT NO.
DRAWN BY
M. NO. NO.
DRAWING & SECTION NO.
DATE
4" BRIDGE
WATER
NORTH