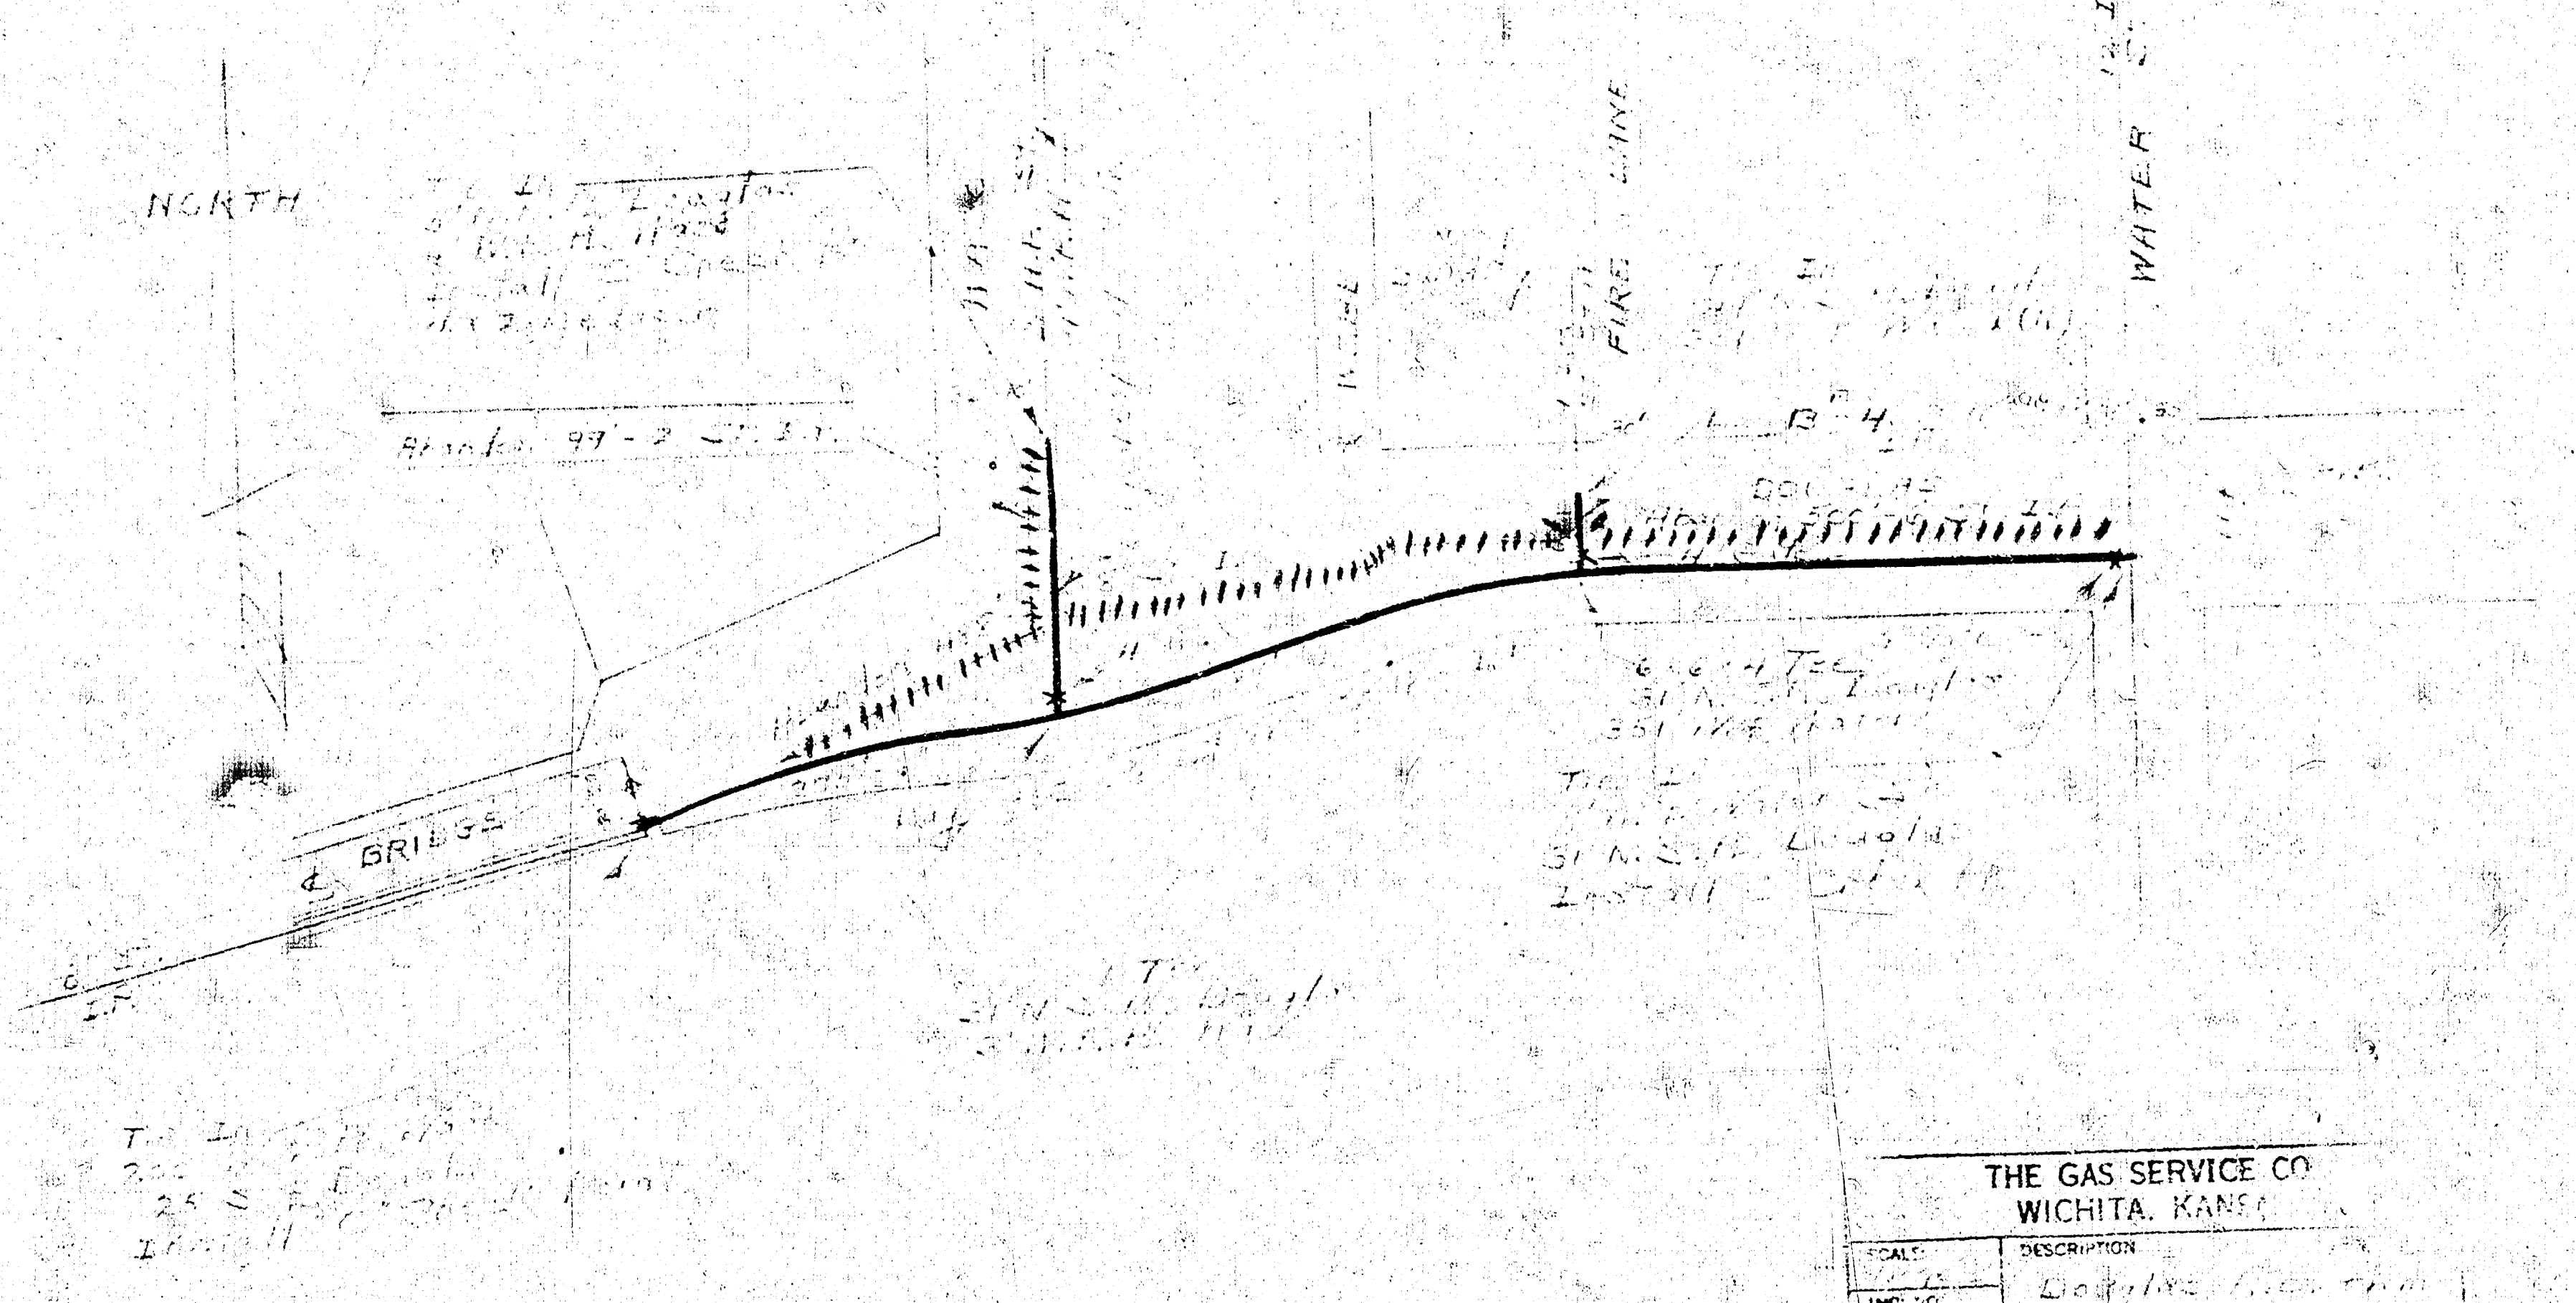

THE GAS SERVICE CO.
WICHITA, KANSAS

SCALE:	DESCRIPTION: [illegible]
INQ. NO.:	
PLAT NO.:	
M. W. O. NO.:	DRAWN BY: [illegible] DATE: [illegible] 67
J. O. NO.:	COMPLETION SKETCH BY: DATE: