
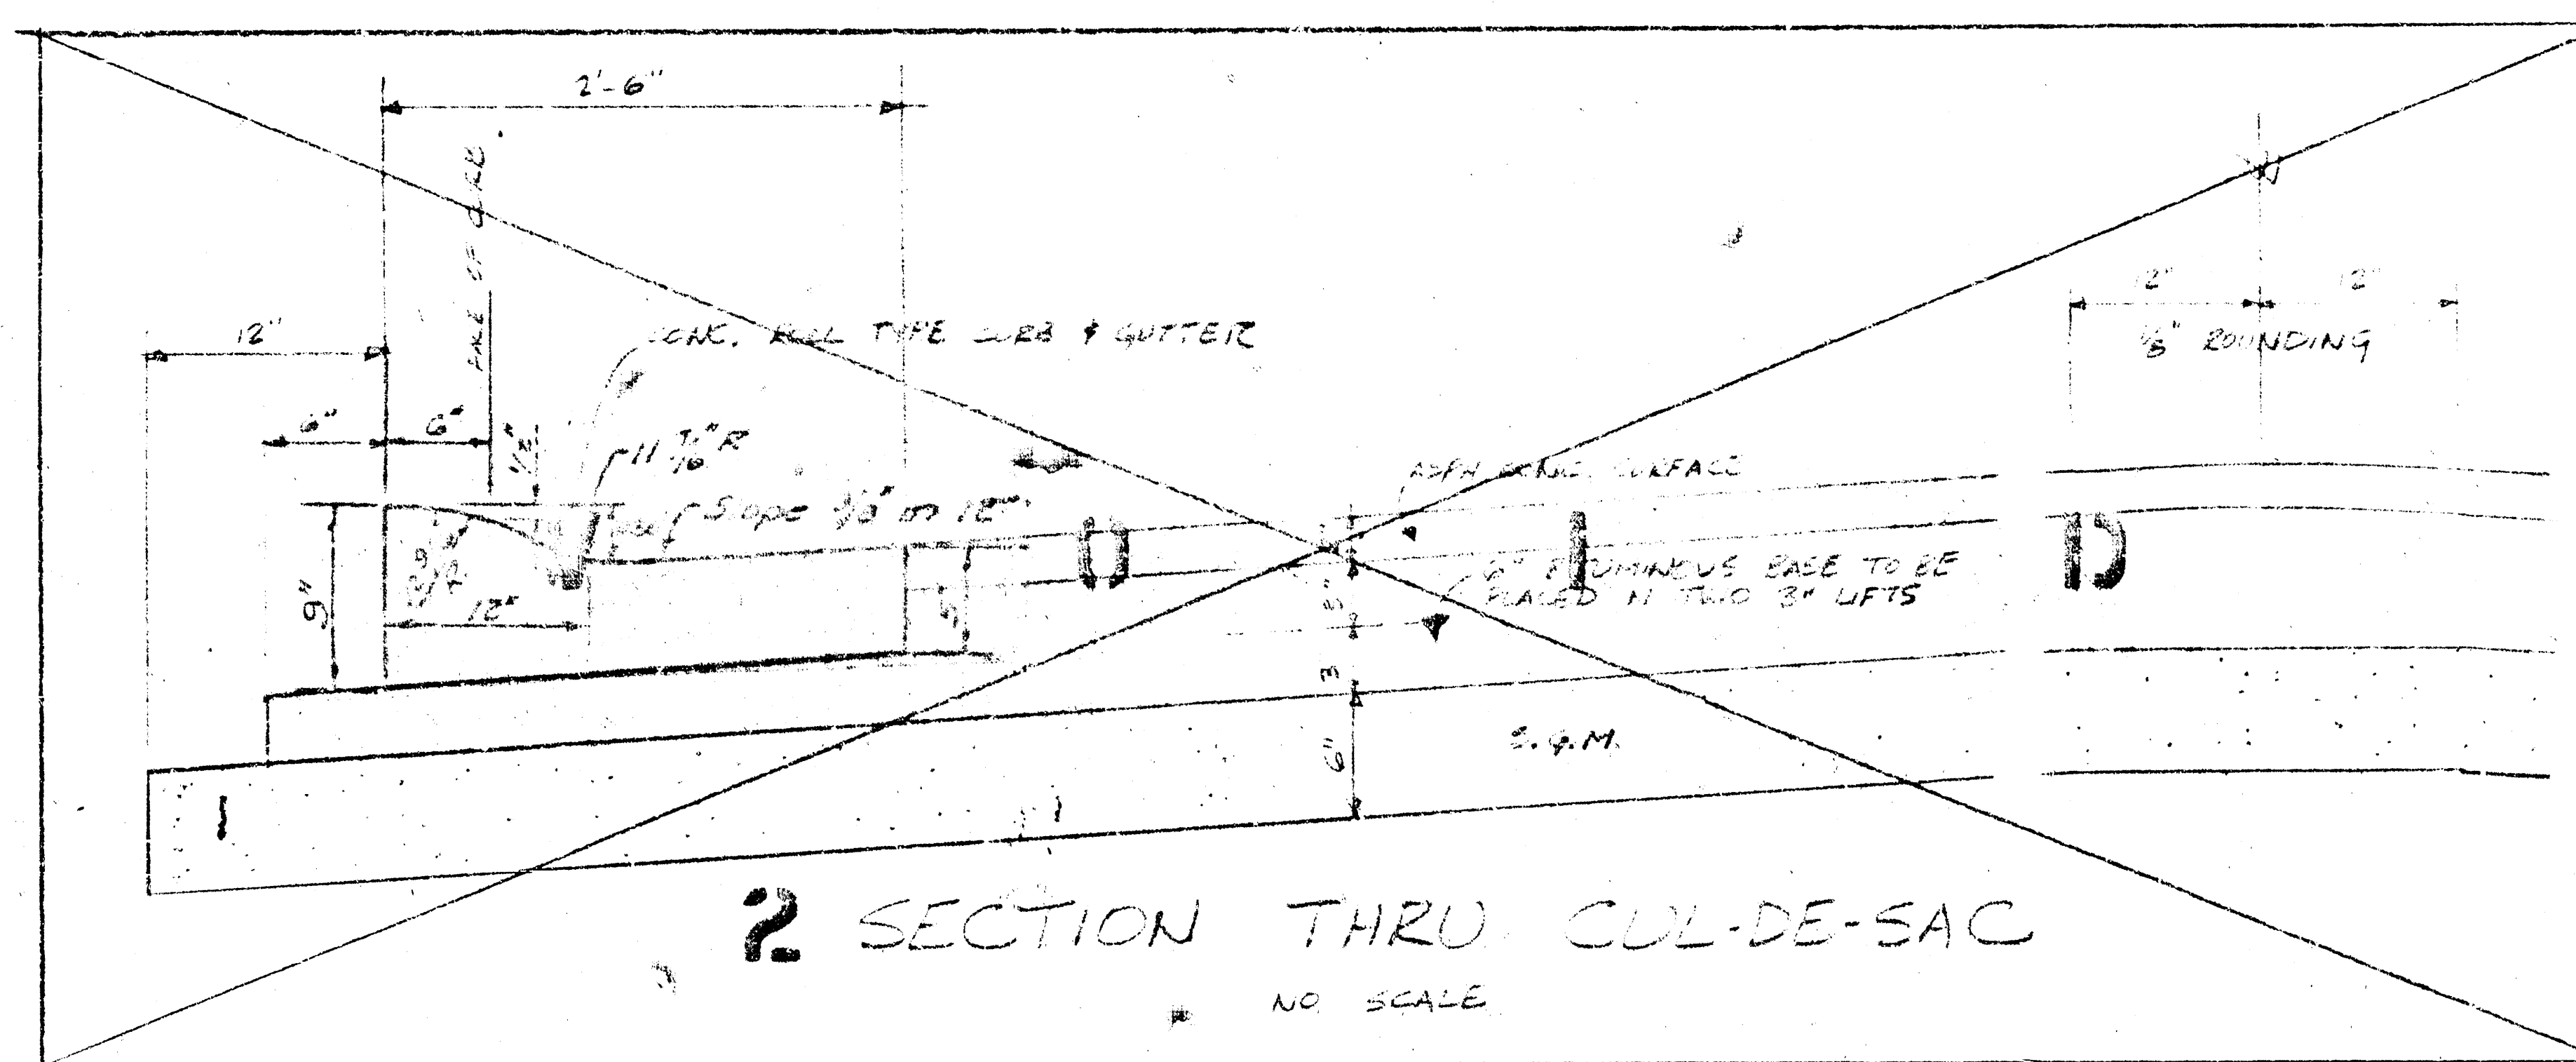


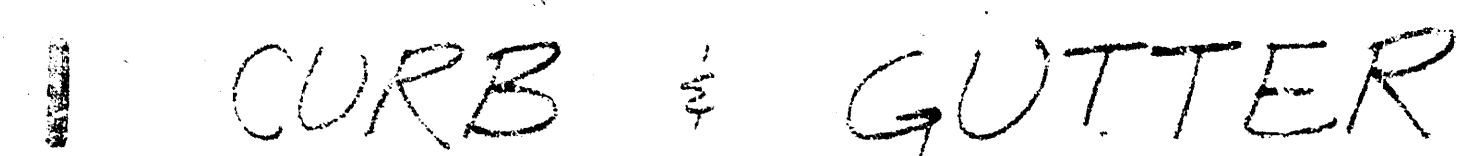

Date. 7-27-7

Engineering Div. *Lee*

This project will be constructed under the supervision of the CITY ENGINEER and conforming to the SPECIFICATIONS of the CITY OF WICHITA. The CONTRACTOR will reimburse the City of Wichita for all cost of Engineering, Plans, and Inspection.

Driveway Approaches

approved w/ signing of
Bonds + Contracts 7-27-78 jpr

472-76-245-80698-000-000-008

