


BM 14611 Top S. Bolt W. Hubward SS Bridge on Eastern Avenue.
 Stationing on a line 3000' W of E.L. Eastern Avenue.



ORME ST.

ST.


1755
 1755
 1755

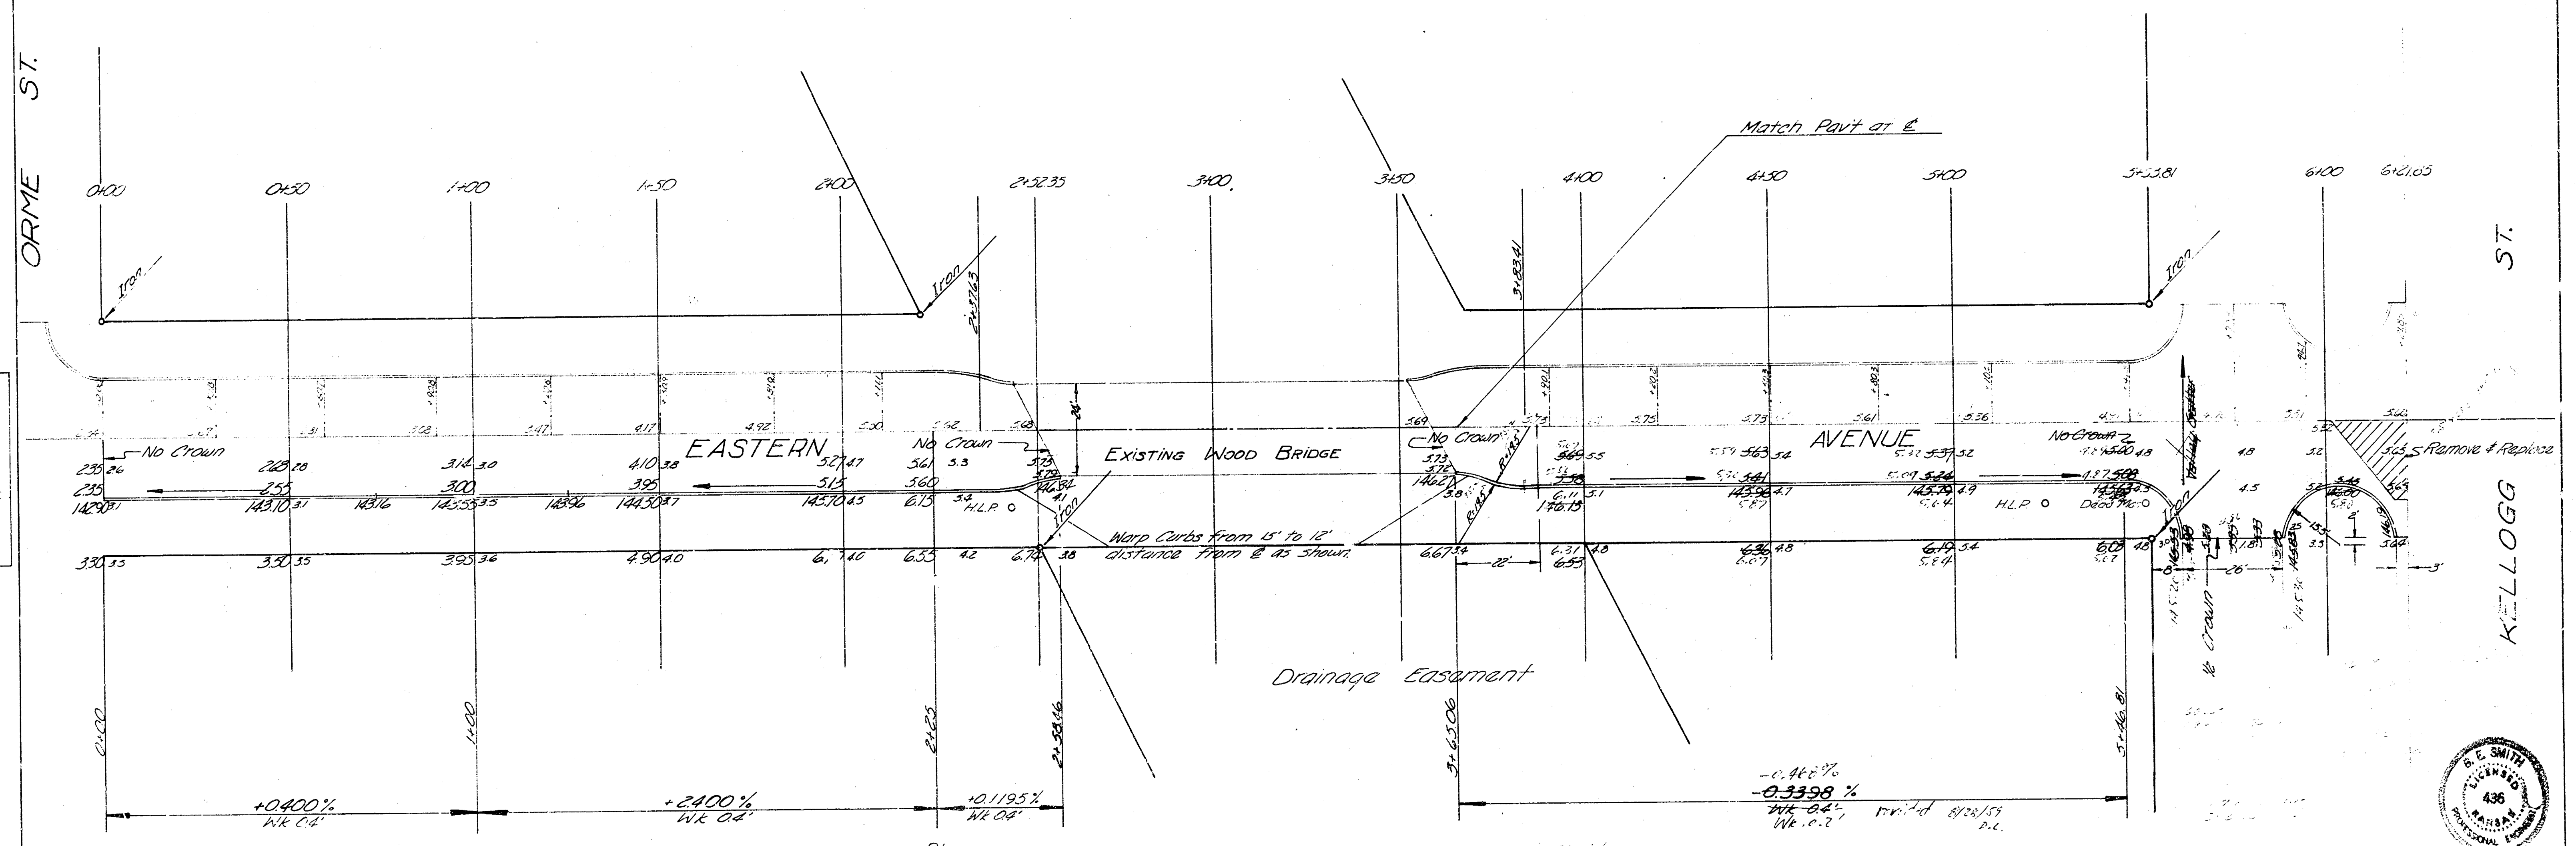


Excavation	Comp. Fill
101.6	2.14
103.5	2.1
113.7	2.35 cu yd

Comp. Fill	Prop. City
4.2	2.3
0.4	2.2
4.6	2.5 cu yd

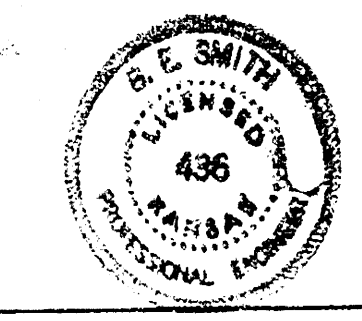

Eastern Ave.
 East 1/2
 SL Weaver-Reimold Add - SL Kellogg
 15' Conc & Cb.
 City of Wichita, Kans.
 B.E. Smith City Engineer
 Date: Aug. 1939, Proj. No. C19-111