


AVE

DOUGLAS

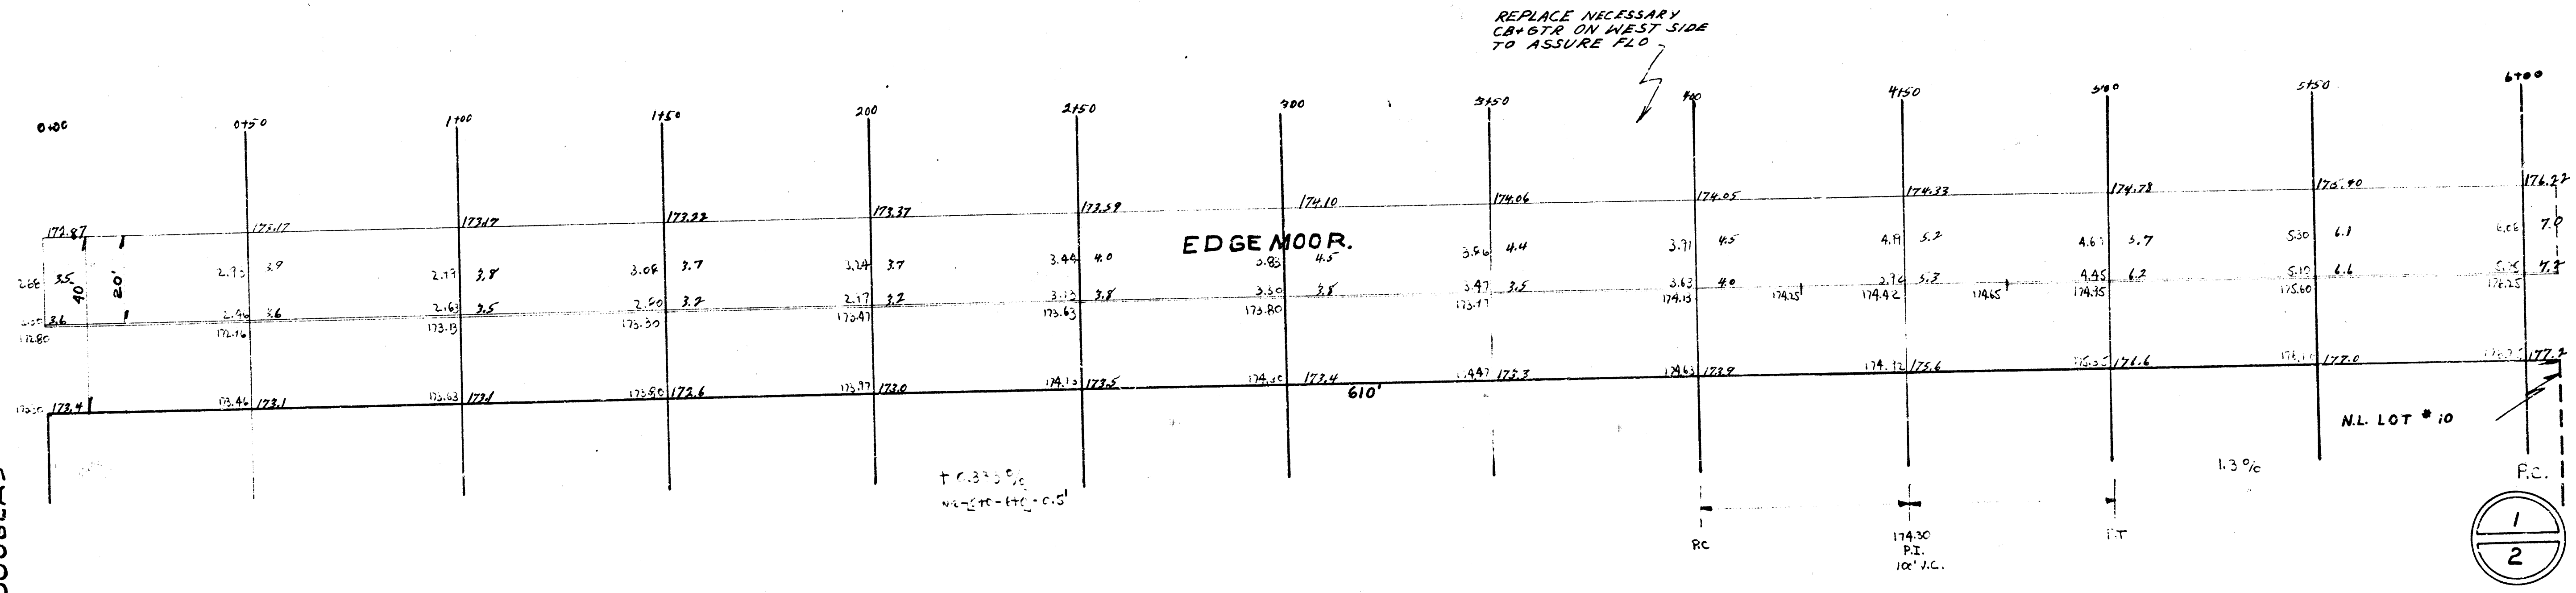

BM 177.41 G in Globe Wch Edgemoor SL 2nd St
BM 173.97 Top Iron Wch Edgemoor SL Douglas

EDGE MOOR
S. L. SECOND
NL DOUGLAS
20' CONC. / CB.
CITY OF WICHITA, KANSAS
L. K. WHITE CITY ENGINEER
JULY 1947

