

H-3



EDGEWOOD E 1/2
 N. L. 9TH TO S. L. 10TH
 15' C & CB
 WIDEN TO 20'
 CITY OF WICHITA, KANSAS
 LK WHITE CITY ENGINEER
 APRIL 1952 PROJ. NO. C-11-303 & C-11-304



B.M. 205.80 "5" in 2-302 Top S. Abrie, White Div. 15' NE E. 9th W Edgemoor
 B.M. 207.40 Top of Iron Post E. Edgemoor, 45' N of B. 10th
 B.M. 203.65 "6" in S. 6666 W. Ch. Edgemoor, S.L. 9th

Property

62.6
 71.3
 88.7
 71.0
 91.3
 89.6
 86.9
 108.7
 105.8
 73.7
 59.8
 114.8
 1111.5
 102%
 1222.7 C.H.



Wk 18'
 -0.234%

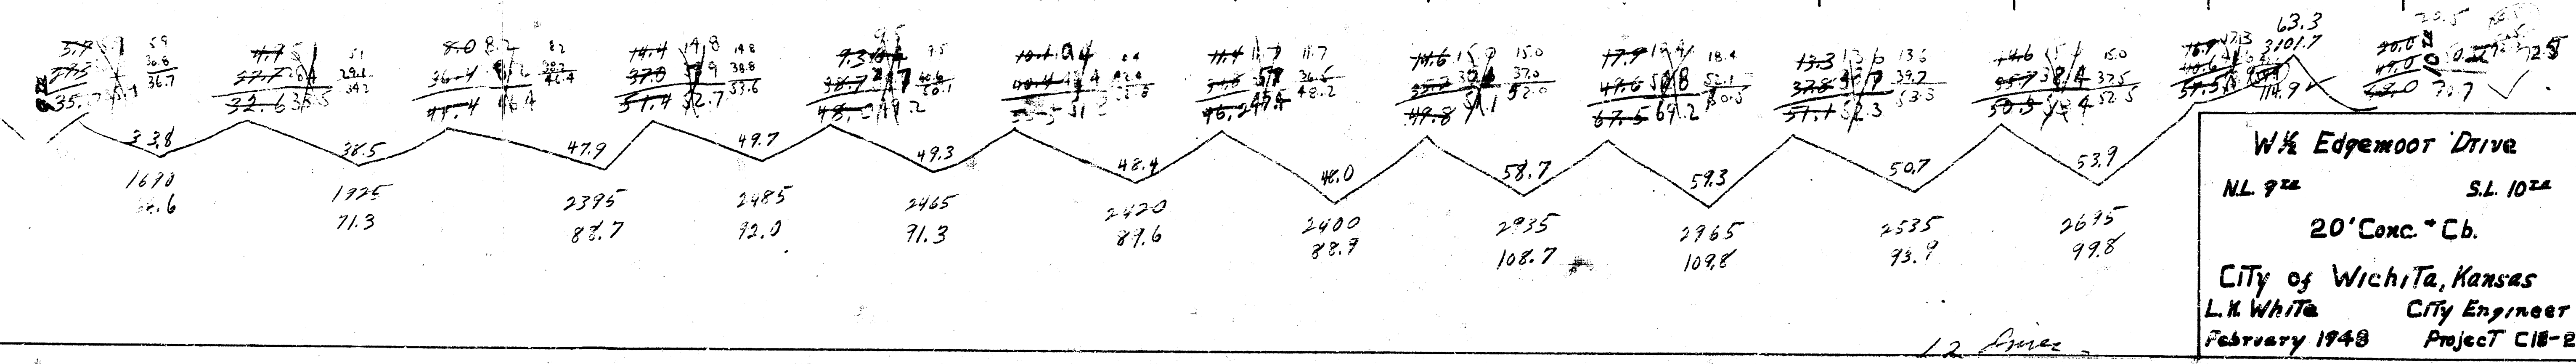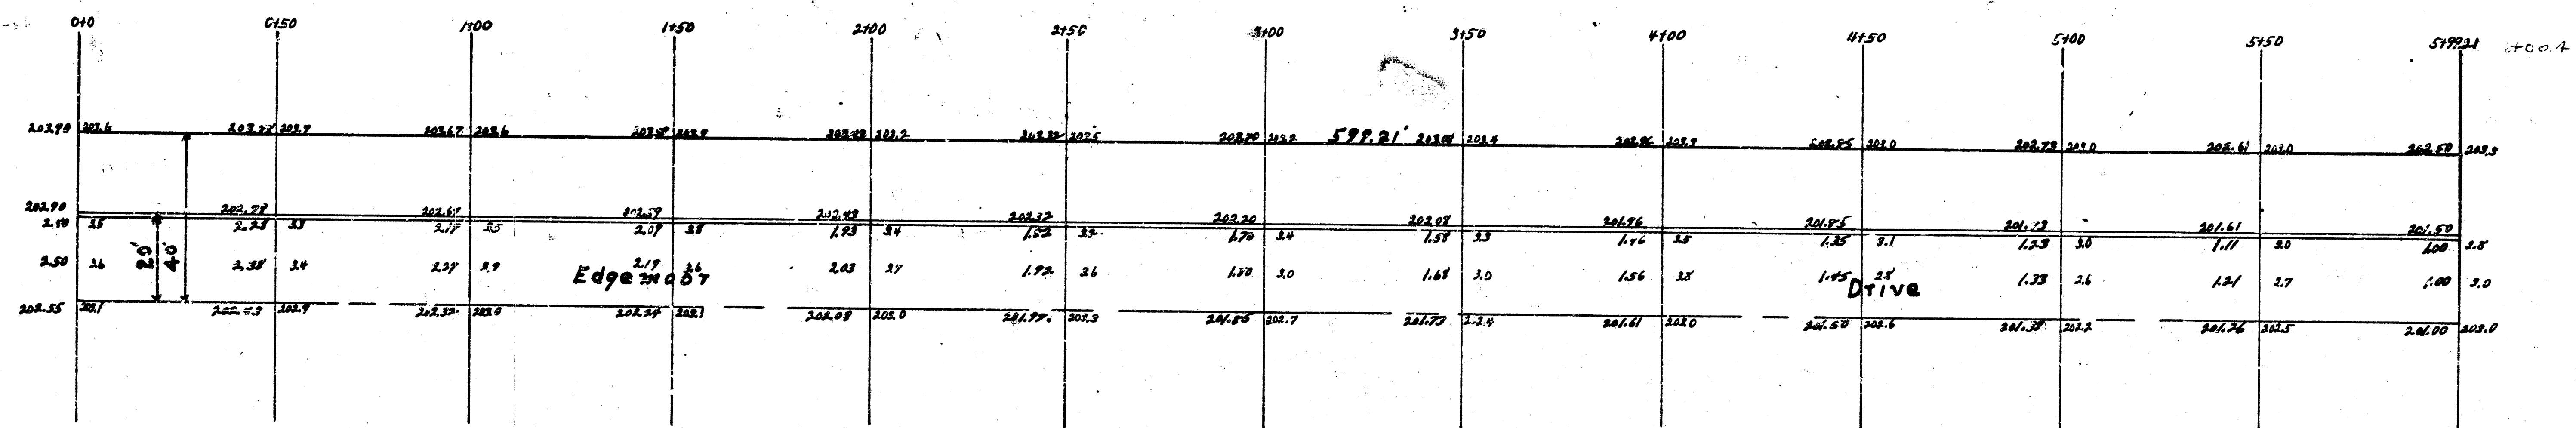

151 14