



B.M. 122.67 "G" in Globe, East of Dougherty, N.L. Edminster
 B.M. 122.13 "D" on East of West St., S.L. Edminster
 B.M. 122.244 Standard G.E. on West St. & 9th.

Stations & chaining East on North prop. line



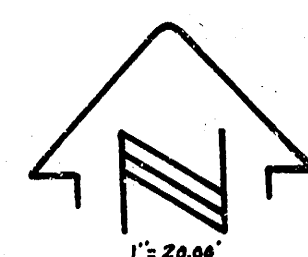


EXCAVATION TOTALS



275.1	Curves Prop. Cut	2443.6	Curves Prop. Cut
27.5	Curves Prop. Cut	344.4	Curves Prop. Cut
302.6	Curves Prop. Cut	2788.0	Curves Prop. Cut

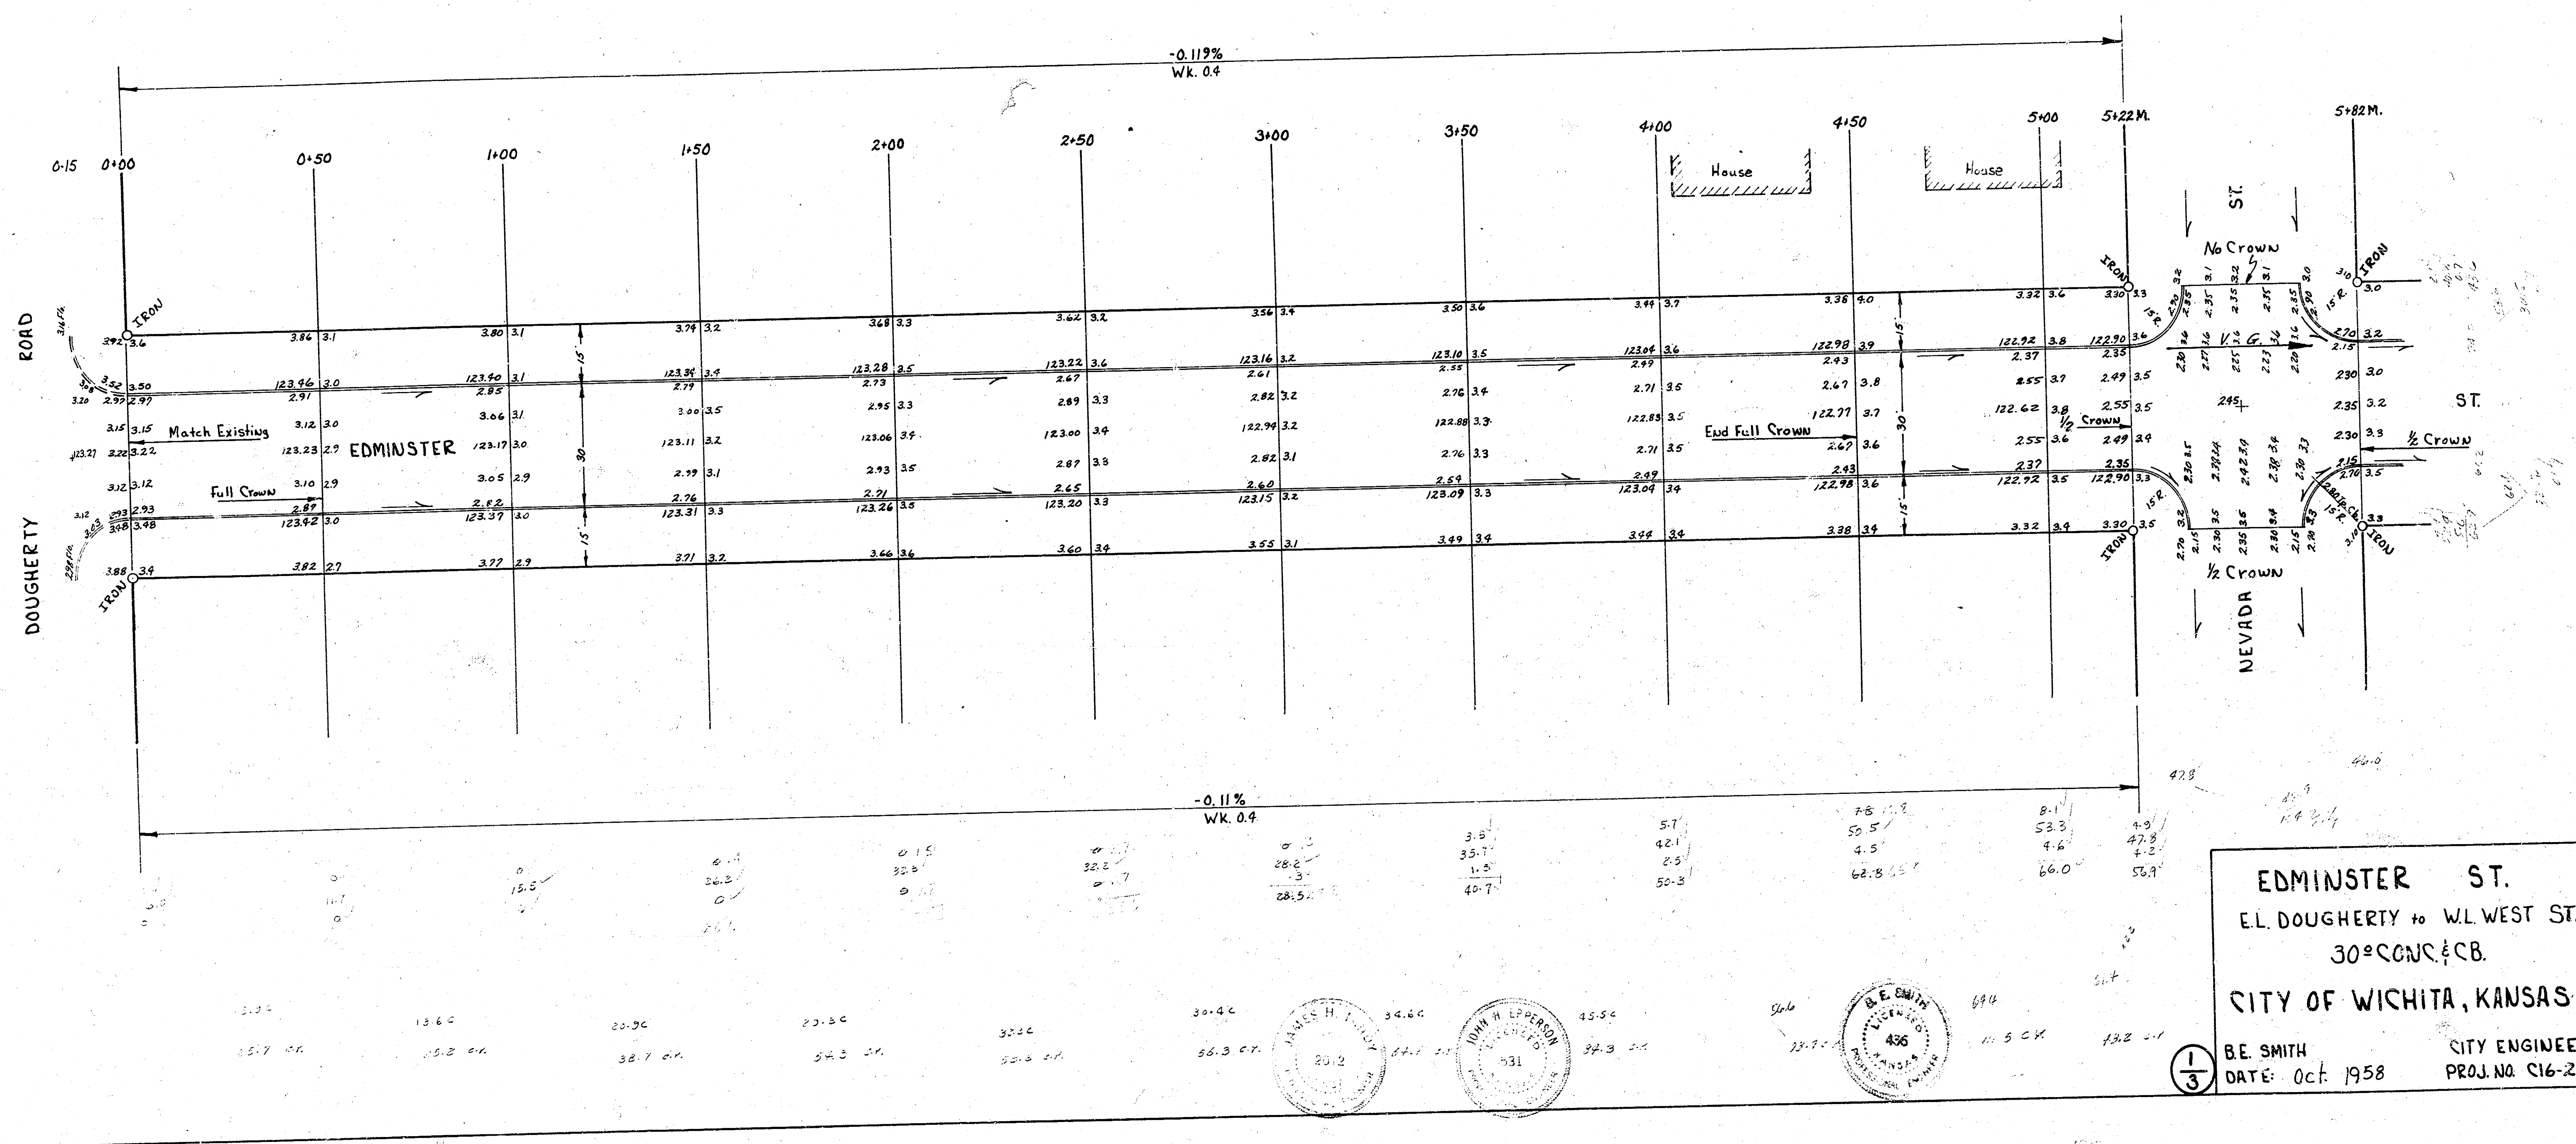


EDMINSTER ST.
 EL. DOUGHERTY to W. WEST ST.
 30' CONC. & CB.
 CITY OF WICHITA, KANSAS
 B.E. SMITH
 DATE: Oct 1958
 CITY ENGINEER
 PROJ. NO. C16-22

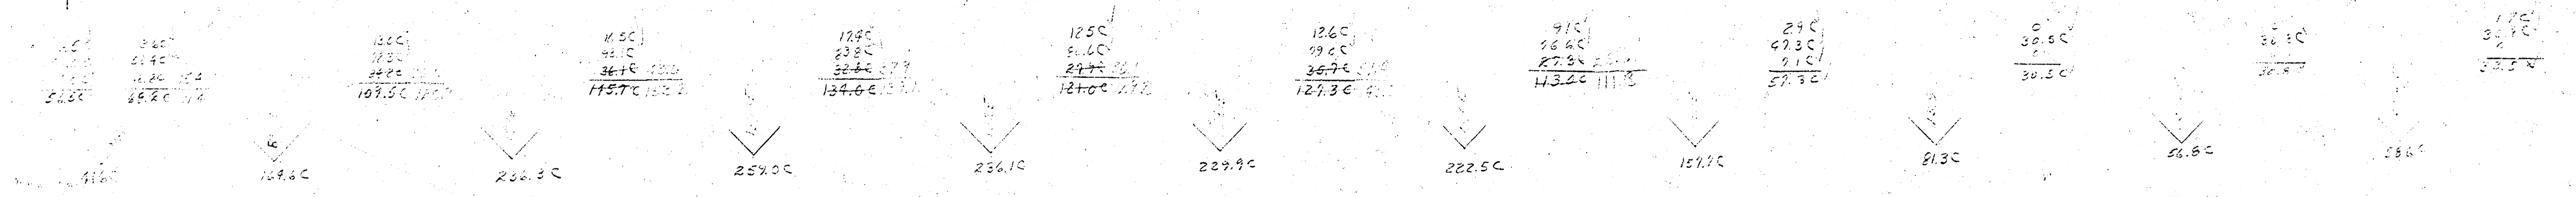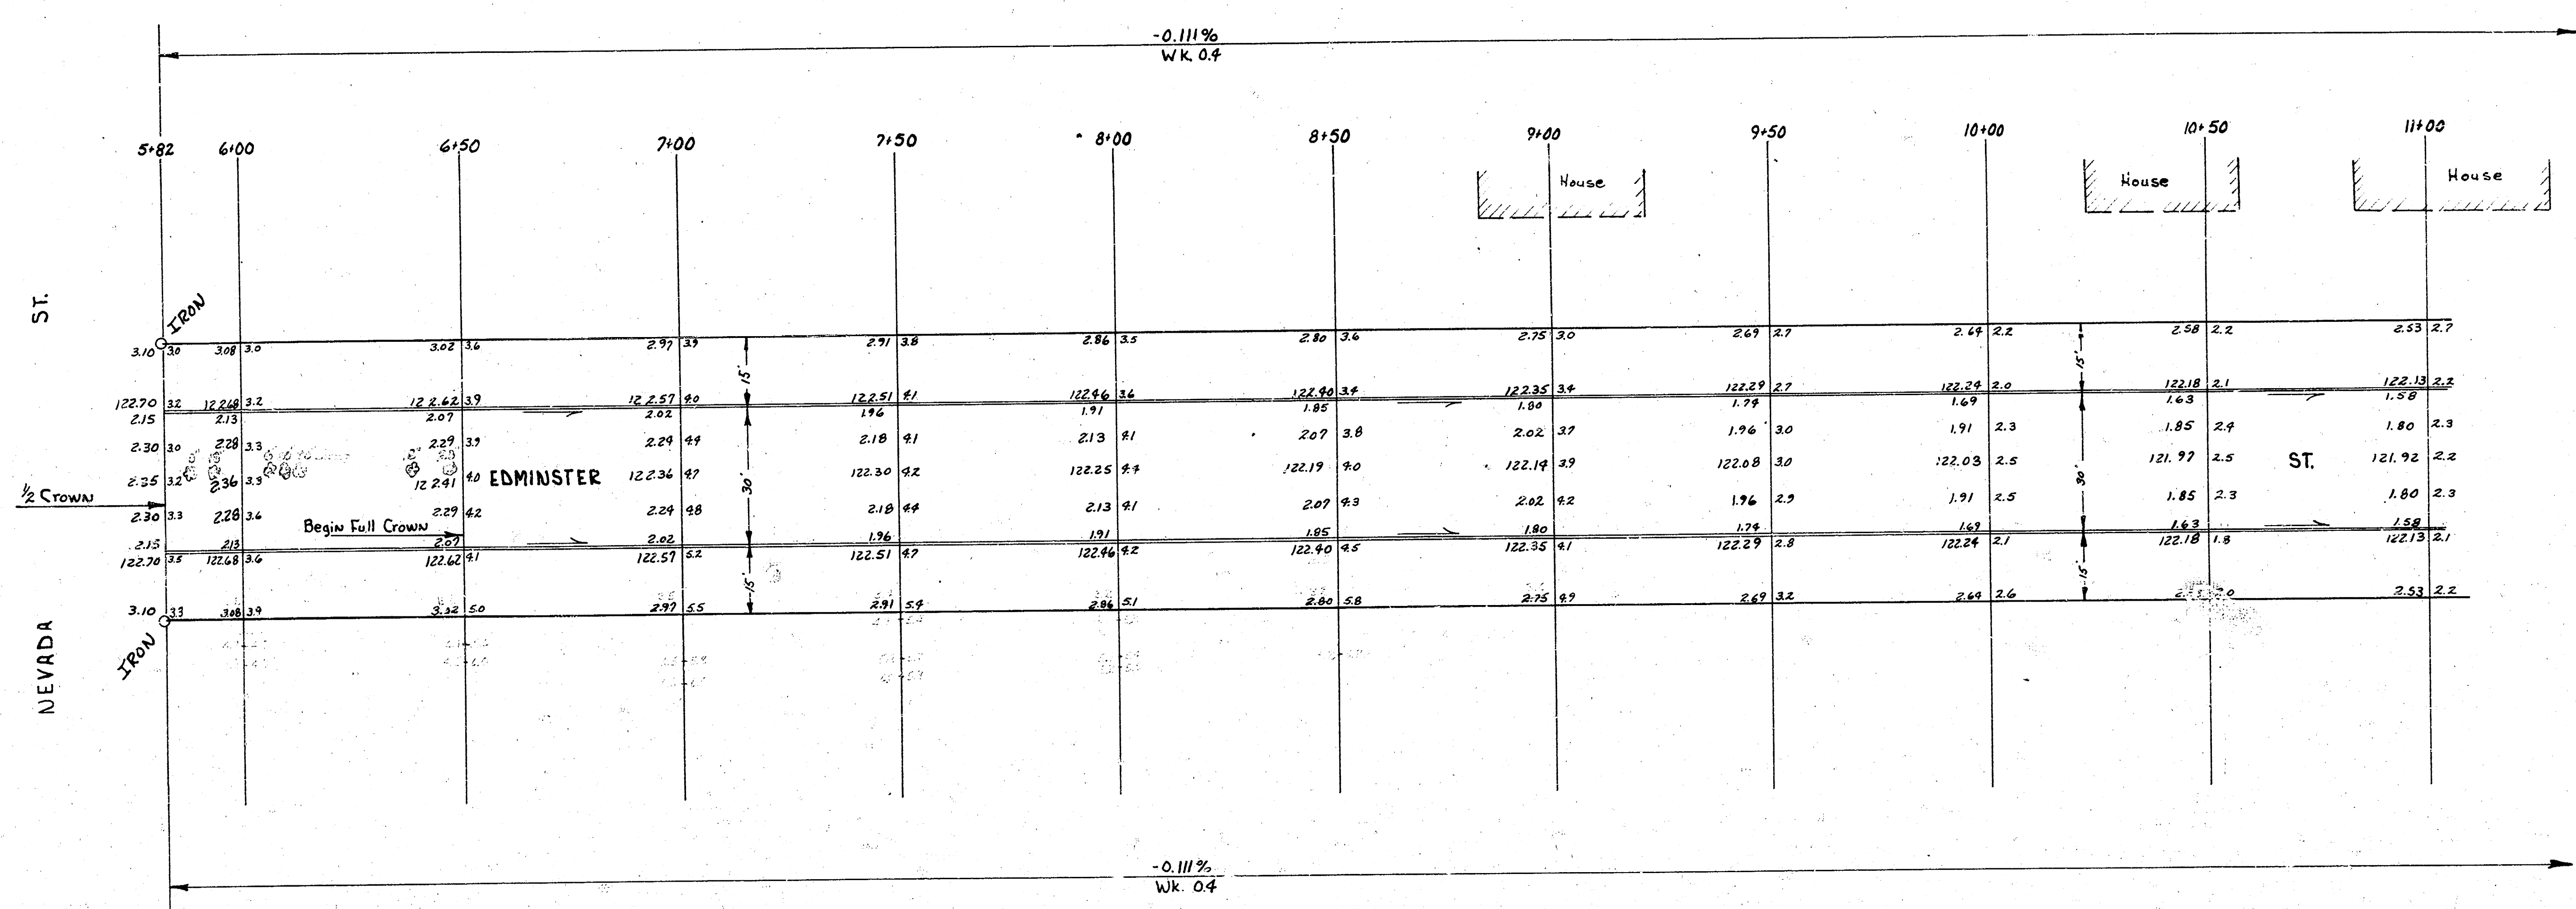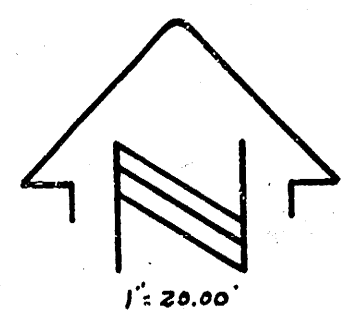

EDMINSTER ST.
Dougherty to West
Proj. No. C16-22

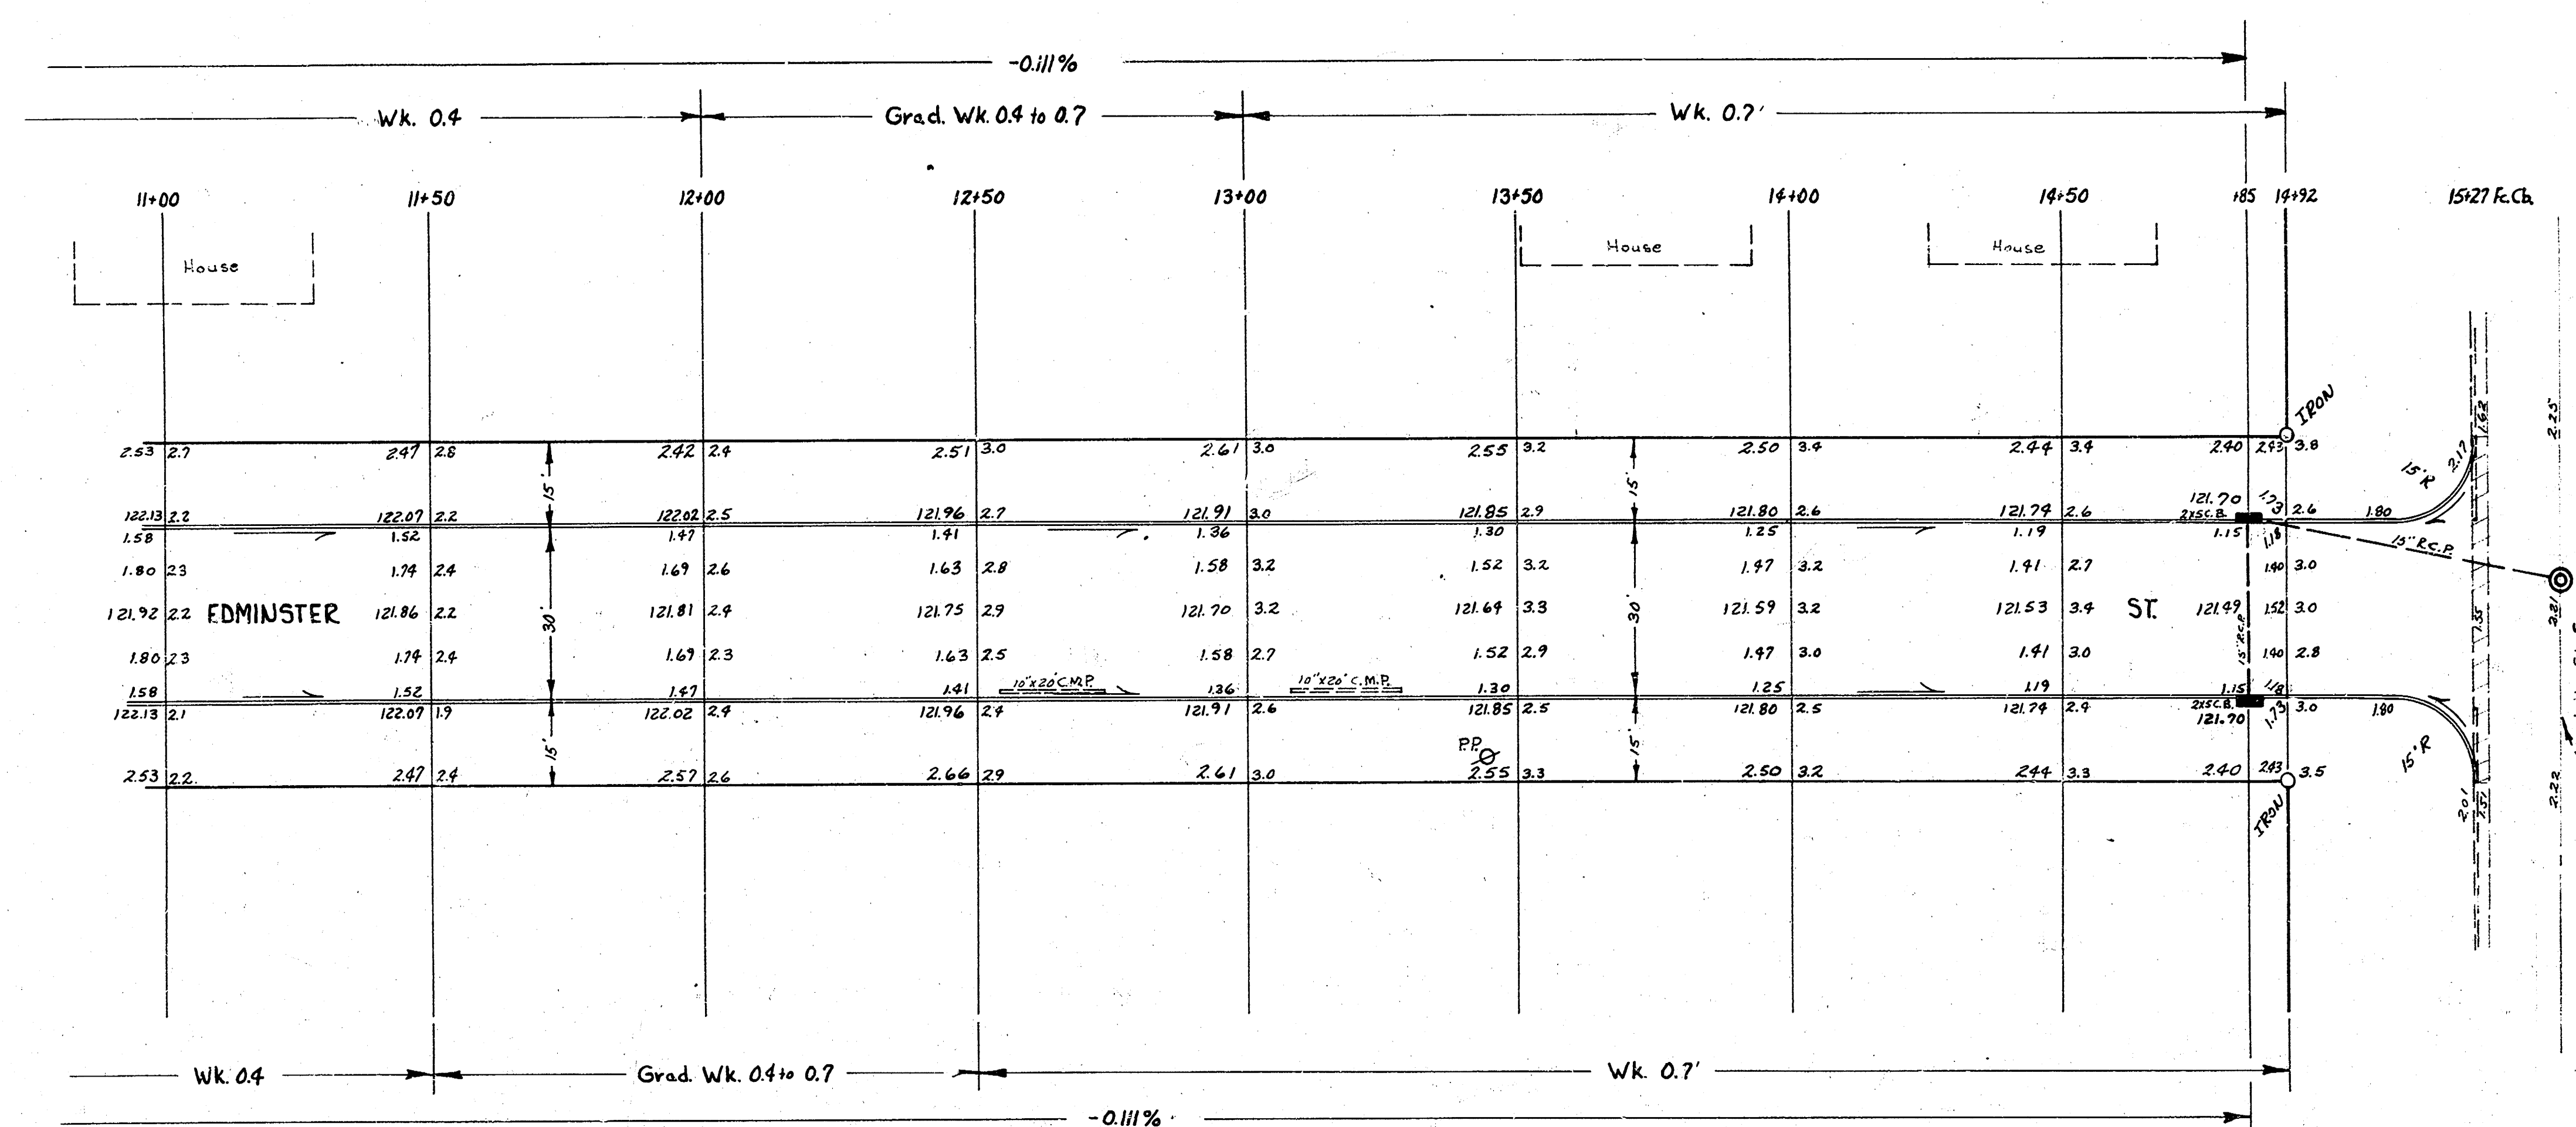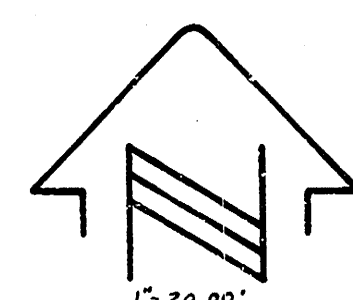

NOTE TO CONTRACTOR & FIELD ENG.
Catch basins & S.W.S. hook-up
to be constructed by others.

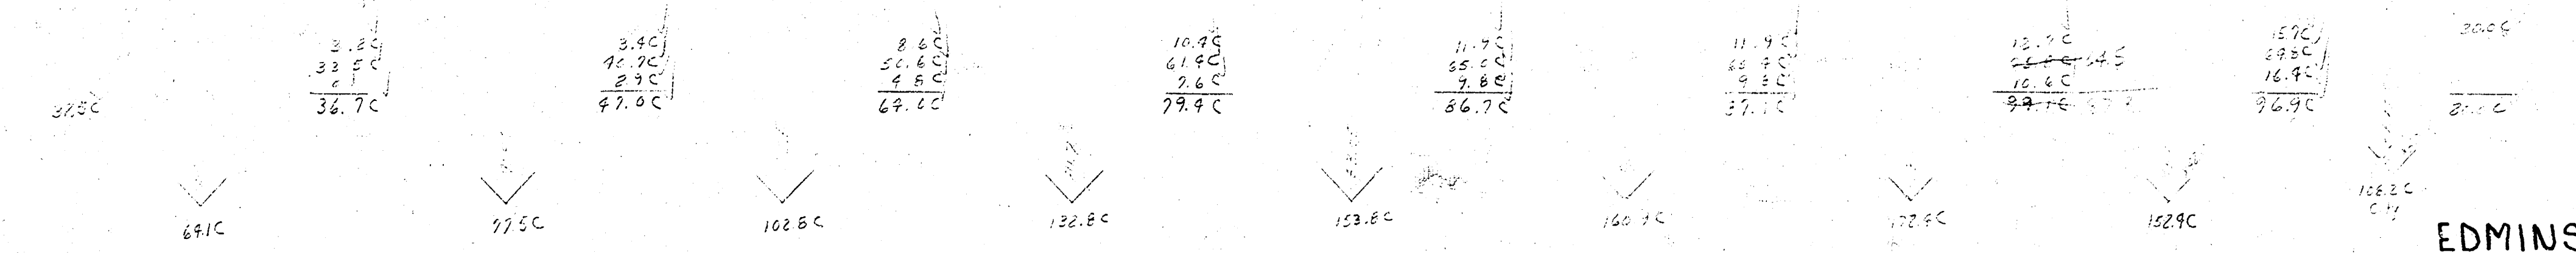

EDMINSTER ST
Dougherty to West
Proj. No. C16-22