B.M. 130.74 N.W. corner conc. step Ho. #2896 Halstead.

B.M. 132.50 S.W. corner conc. porch Ho. #2891 Edwards

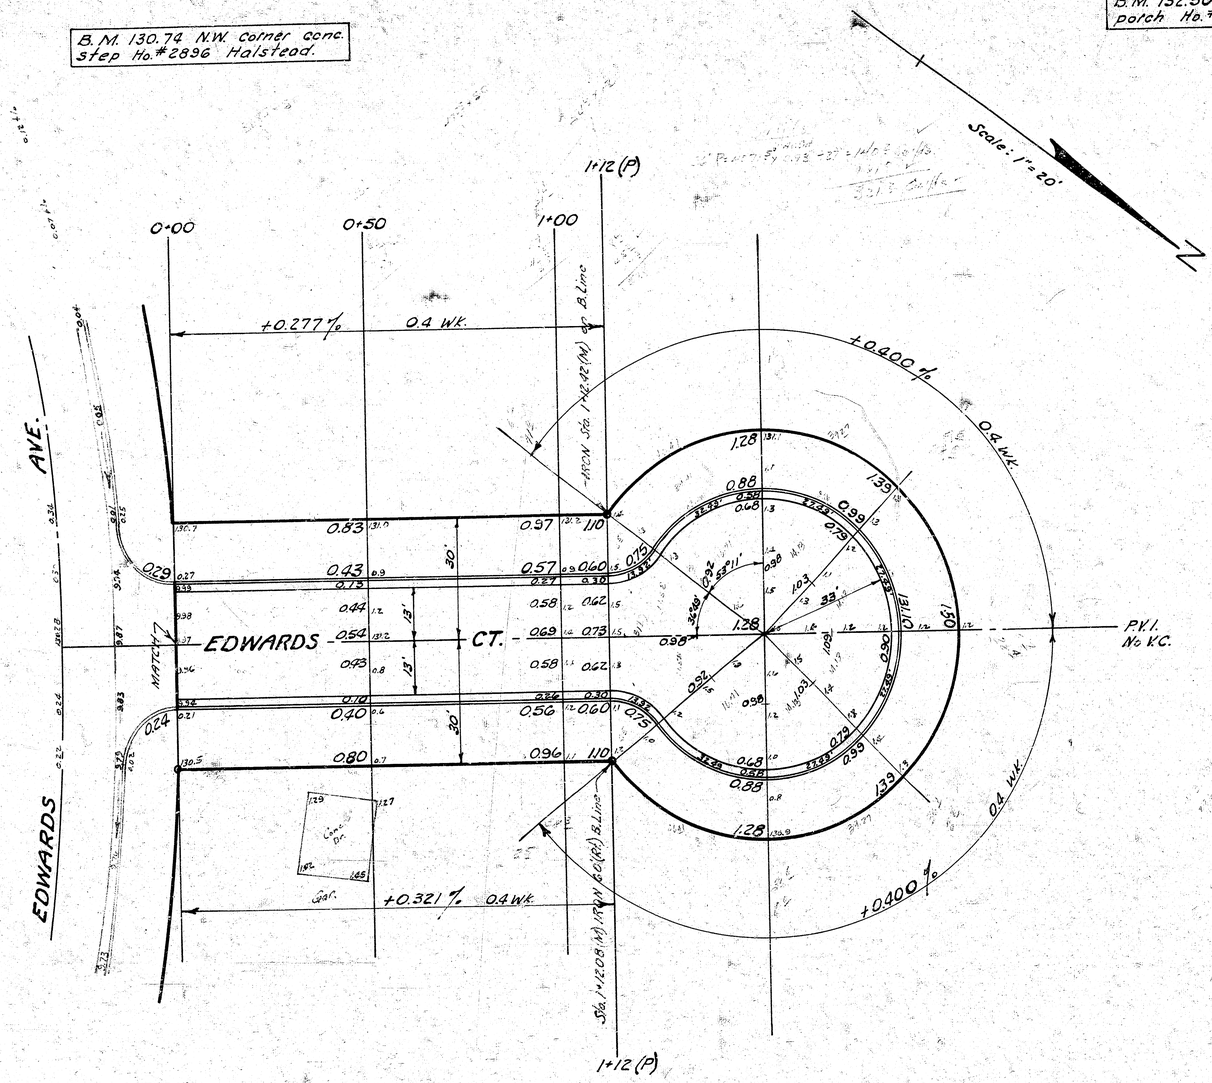

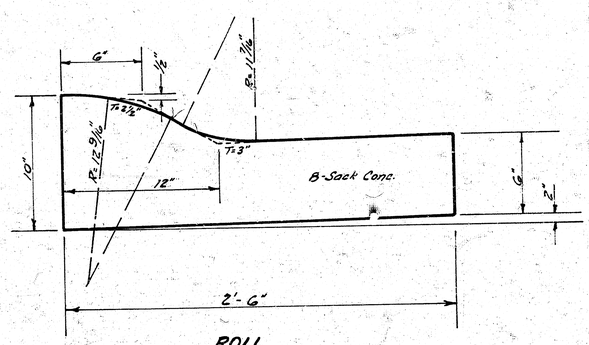

ROLL
CURB & GUTTER DETAIL

NOTE: Depress Curb @ all driveways.

EXCAVATION

	321 Cu. Yds.
+10%	32 "
Total	353 Cu. Yds.

JOHN L. ALLEN LICENSED 821 KANSAS PROFESSIONAL ENGINEER

EDWARDS COURT
NORTH Ct. IN BLK. 1 VALLEY PARK Al
From W.L. Edwards to S & Inc. Cul-de
26'-2'-30' ASPH. CONC.
B.E. SMITH CITY ENGINEE.
CITY OF WICHITA KANSA
Date: July 1966
Proj. No. C13-81