

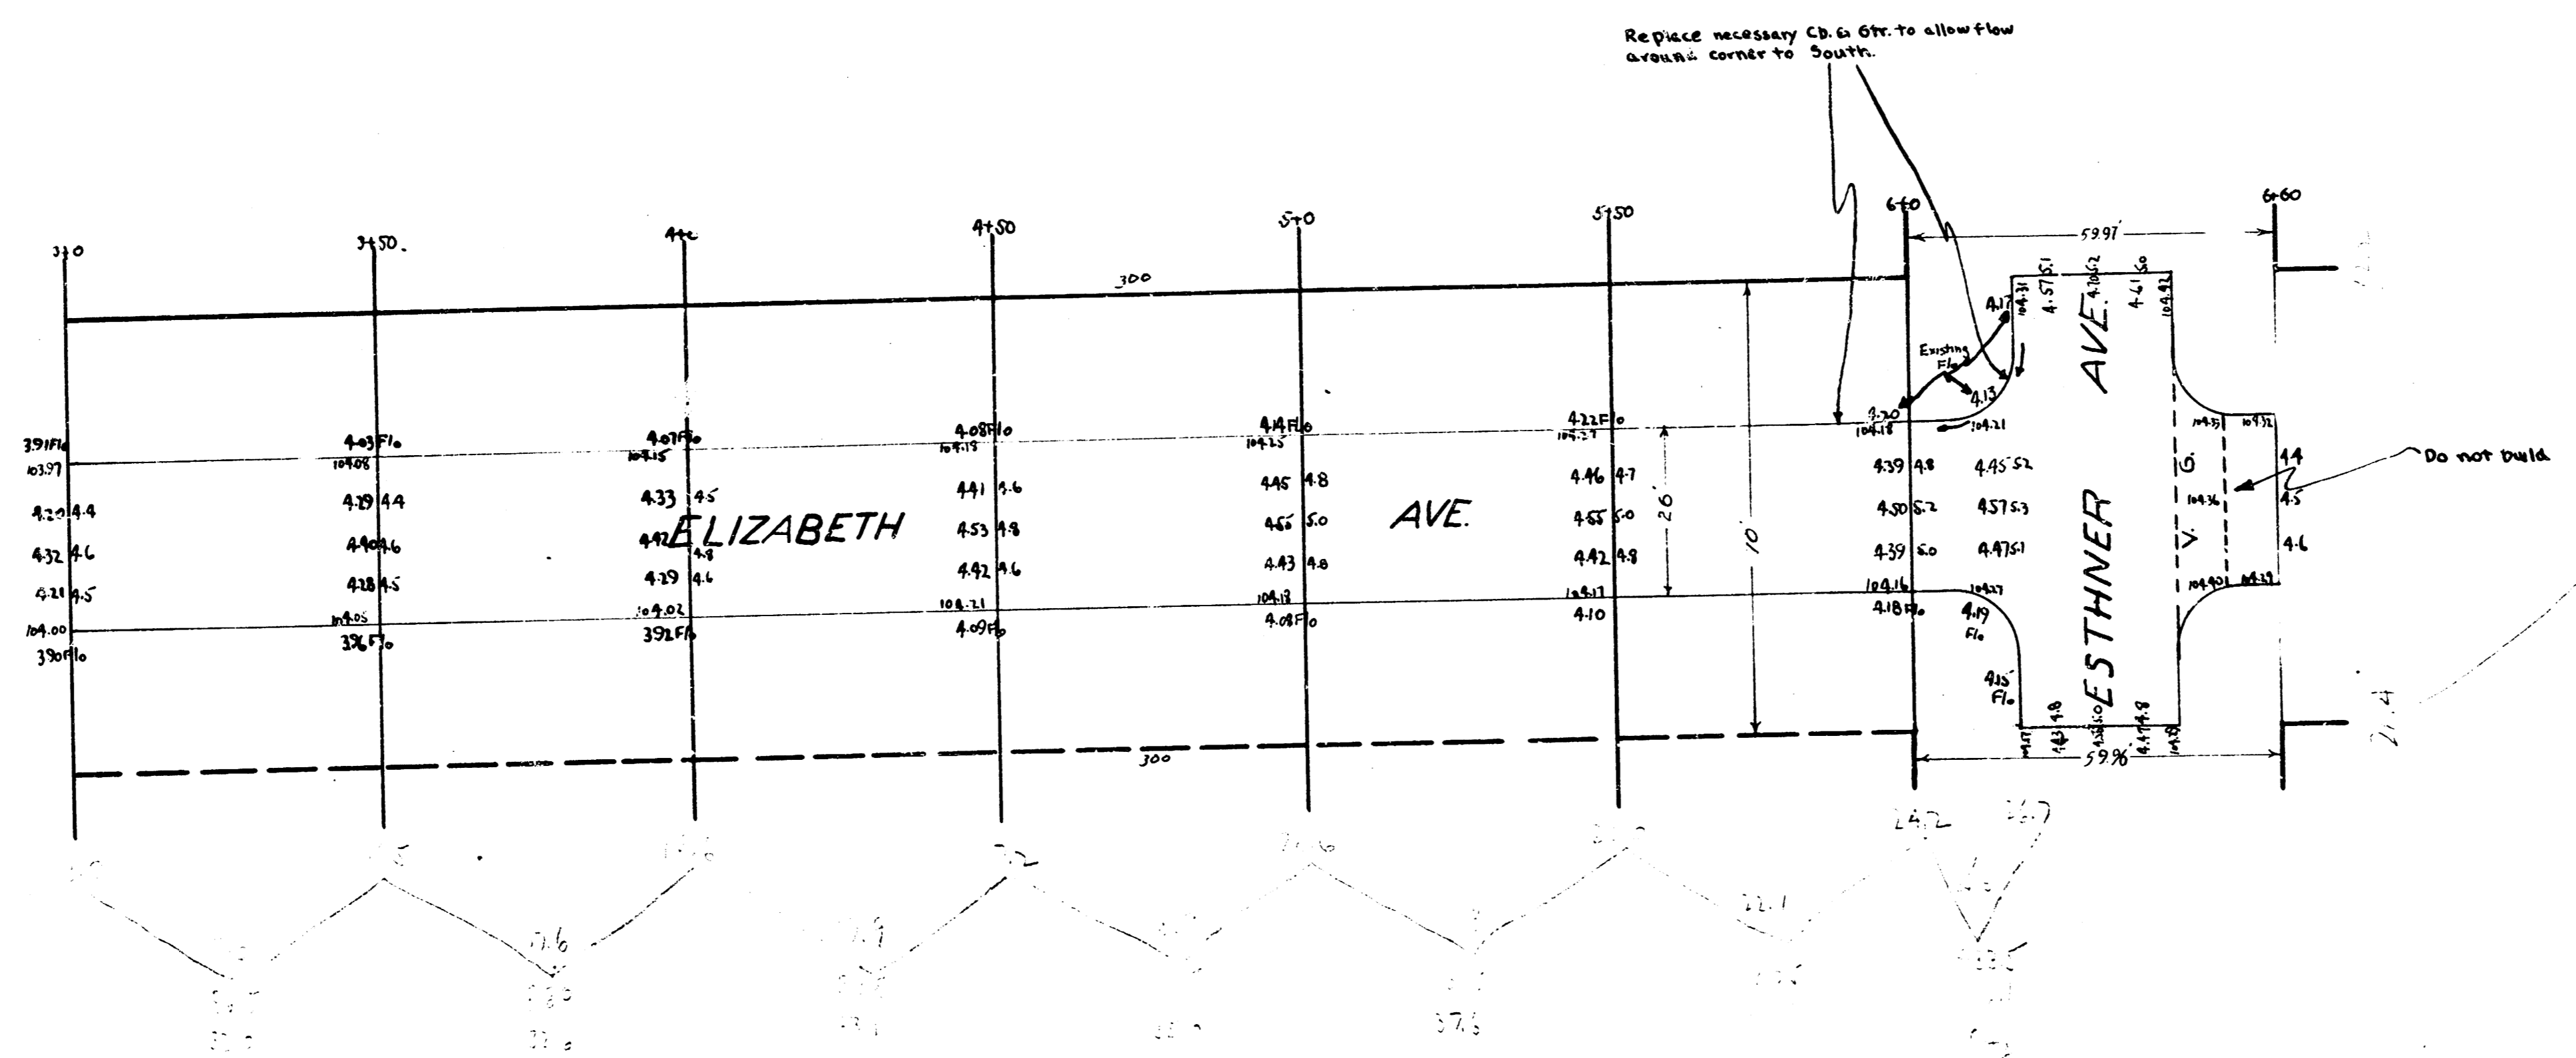


S.M. 10124 S.E. Cor. Conc. Porch N.W. Elizabeth & Dora  
 D.M. 10520 N.Rm. M.H. 100'S.W. Stanton School

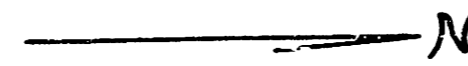


2+00  
 2+25  
 2+50  
 2+75  
 3+00  
 3+25  
 3+50  
 3+75  
 4+00  
 4+25  
 4+50  
 4+75  
 5+00  
 5+25  
 5+50  
 5+75  
 6+00

ELIZABETH AVE  
 N.L. ESTHNER TO S.L. DORA  
 26' CONCRETE  
 CITY OF WICHITA, KANSAS  
 L.K. WHITE CITY ENGINEER  
 JULY 1946

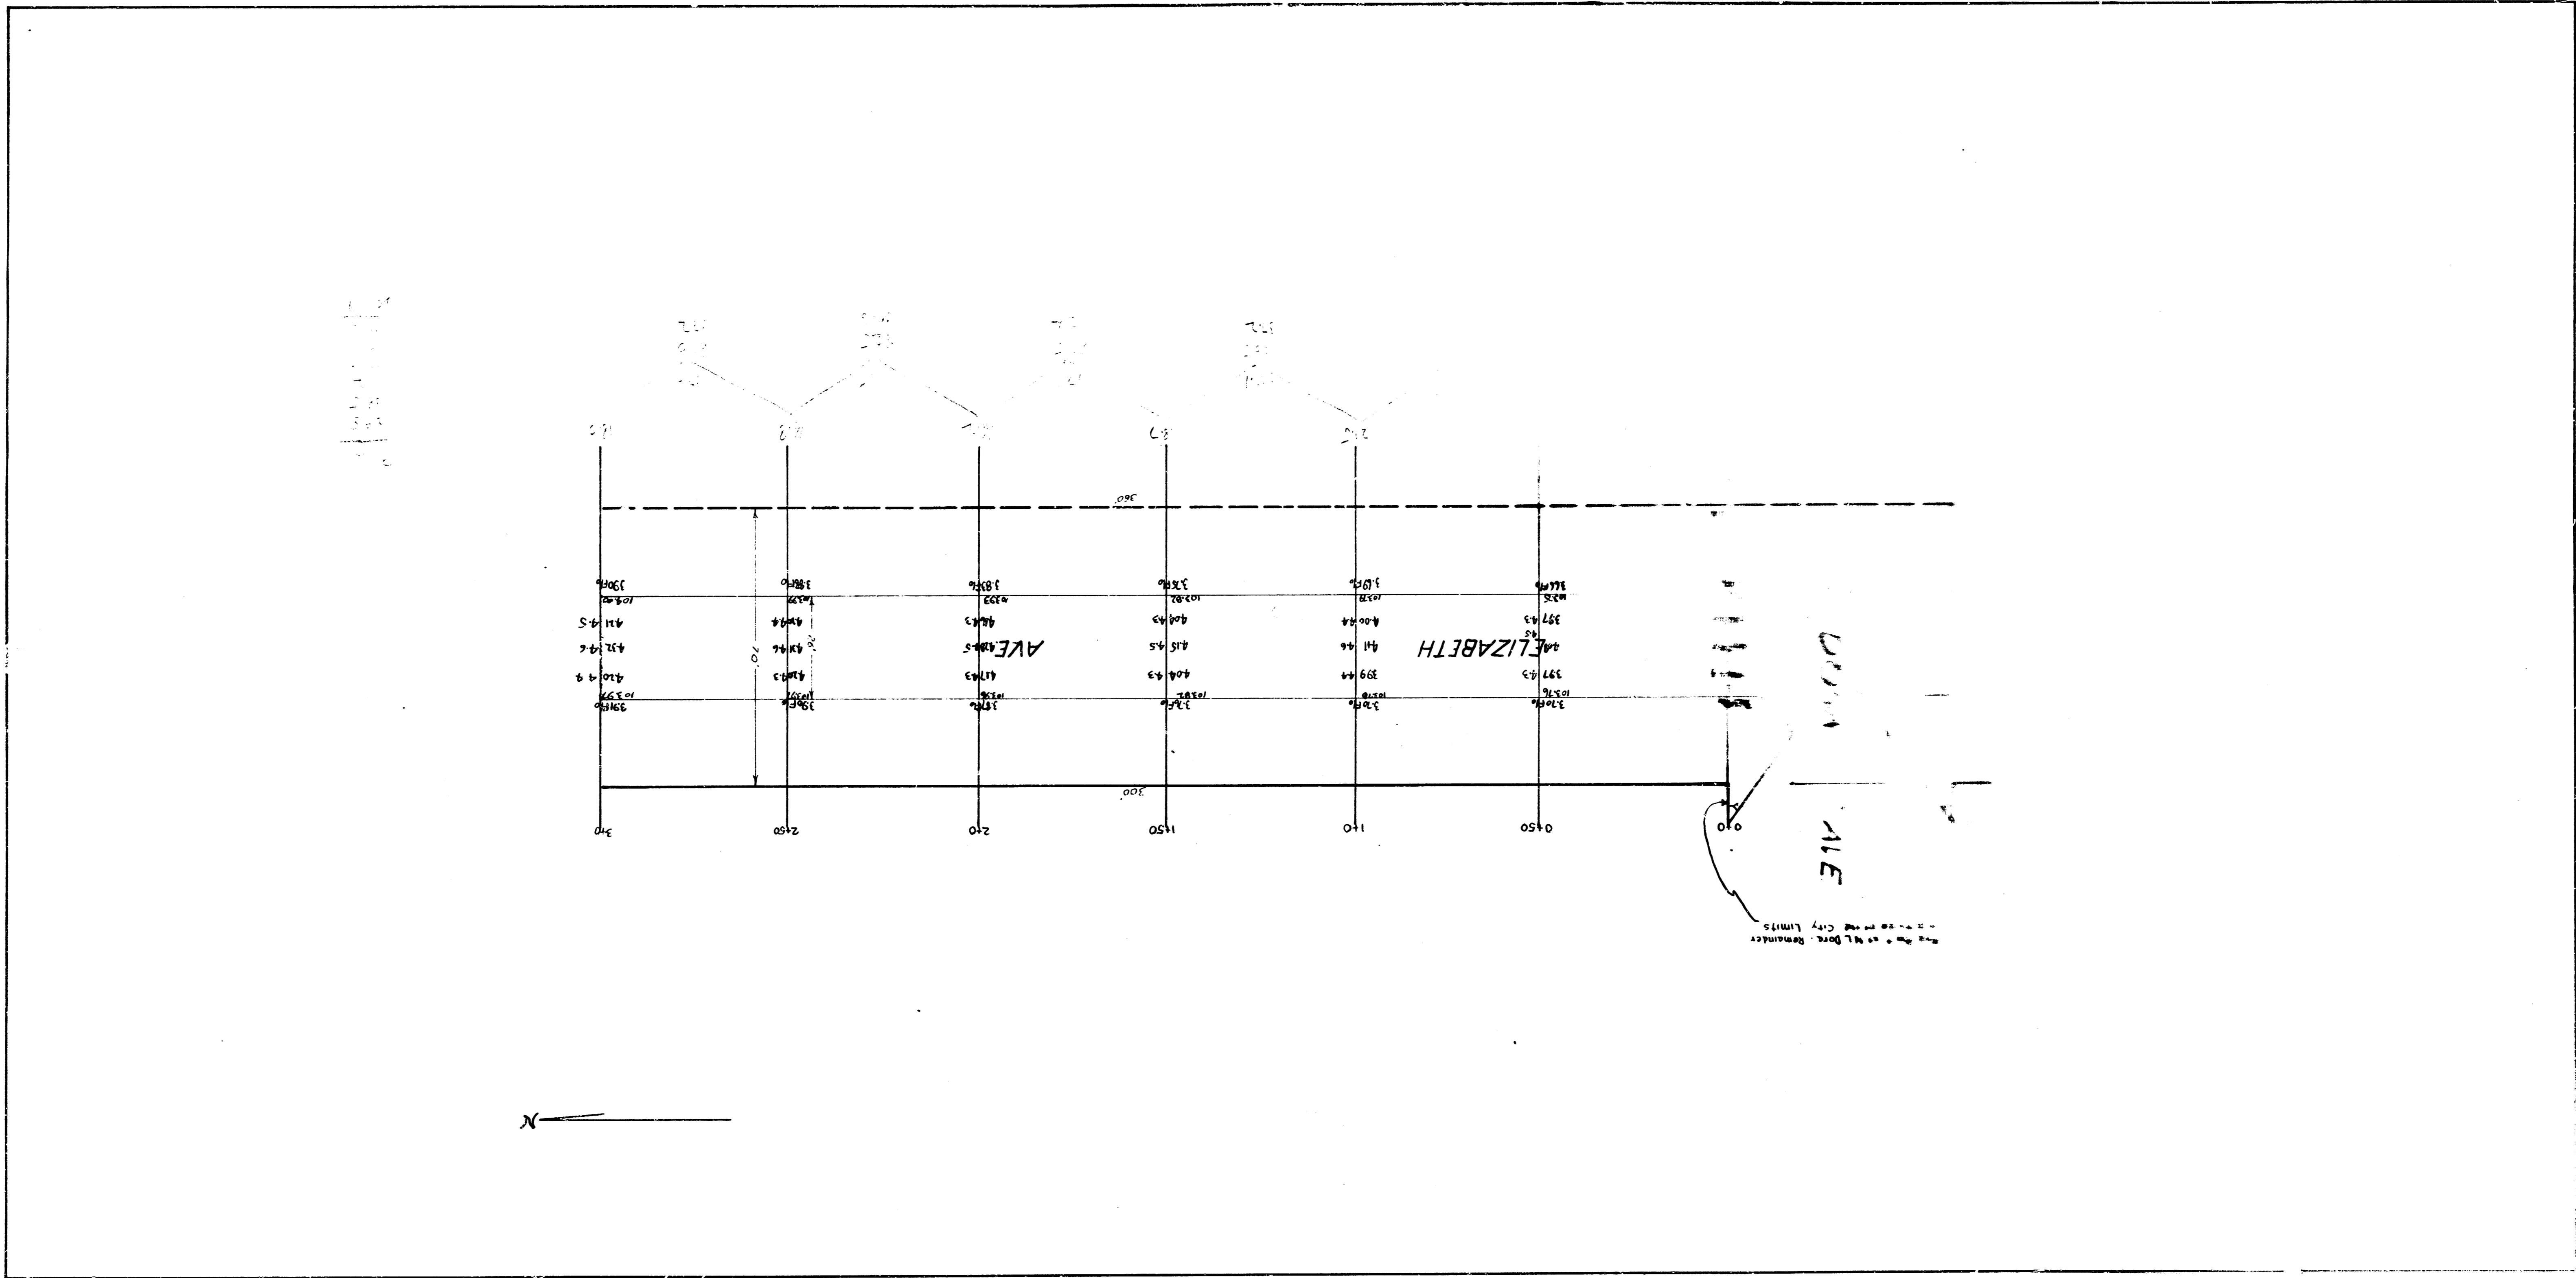

1941  
 ELIZABETH - S.L. ESTHNER TO N.L. DORA.  
 COMB. CURB & GUTTER

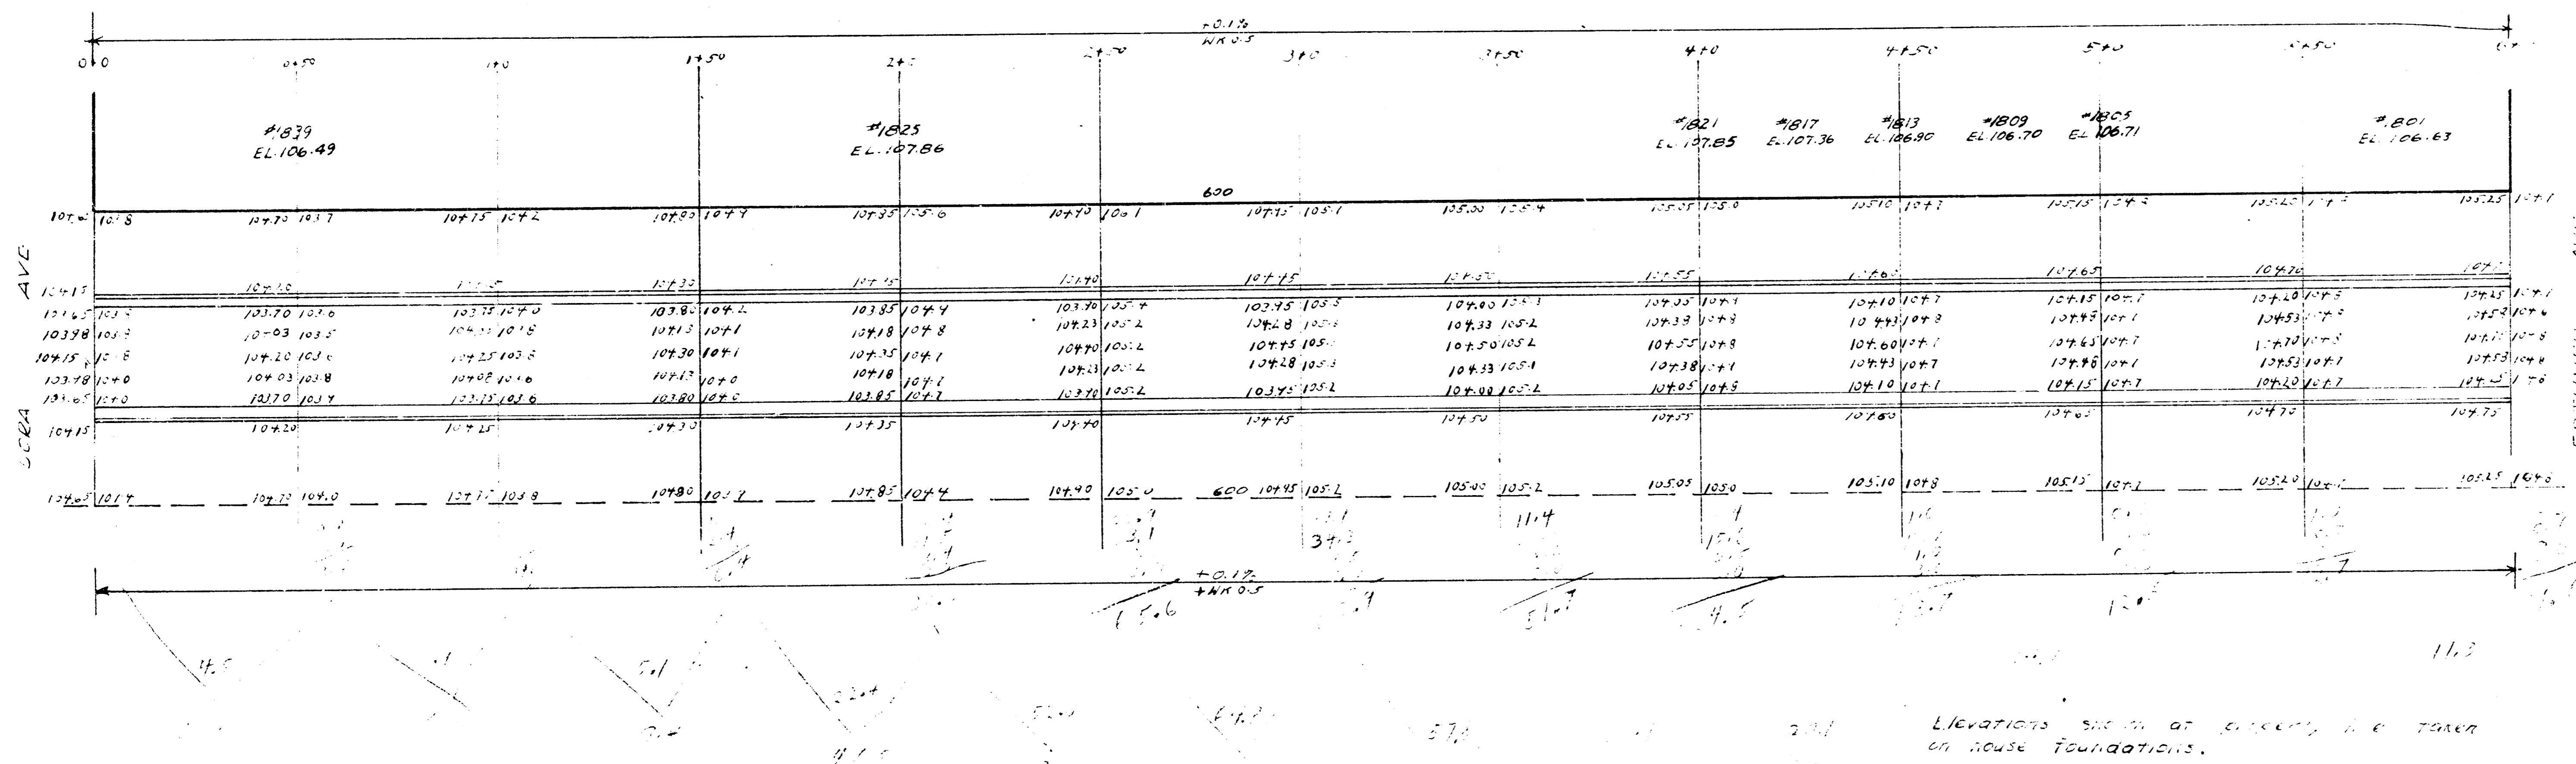

BM 10520 N. RIM 74 W. SIDE SCHOOL 100' SW COR. 3rd COE OF SCHOOL

ELEVATIONS SHOWN AT CURBS, ETC. TAKEN ON HOUSE FOUNDATIONS.

