

4" THICK SIDEWALK

4'-0"

6"

SLOPE 1/4" TO 12" (MIN)

12"







1" EXPANSION JOINT

CURB AND GUTTER

NOTE:
 INSTALL EXPANSION JOINTS
 EVERY 25' AND WHERE
 SIDEWALK JOINS CURB.
 CUT SIDEWALK INTO SQUARES
 NOT TO EXCEED 5 FEET

SIDEWALK DETAILS AT INTERSECTIONS

NO SCALE

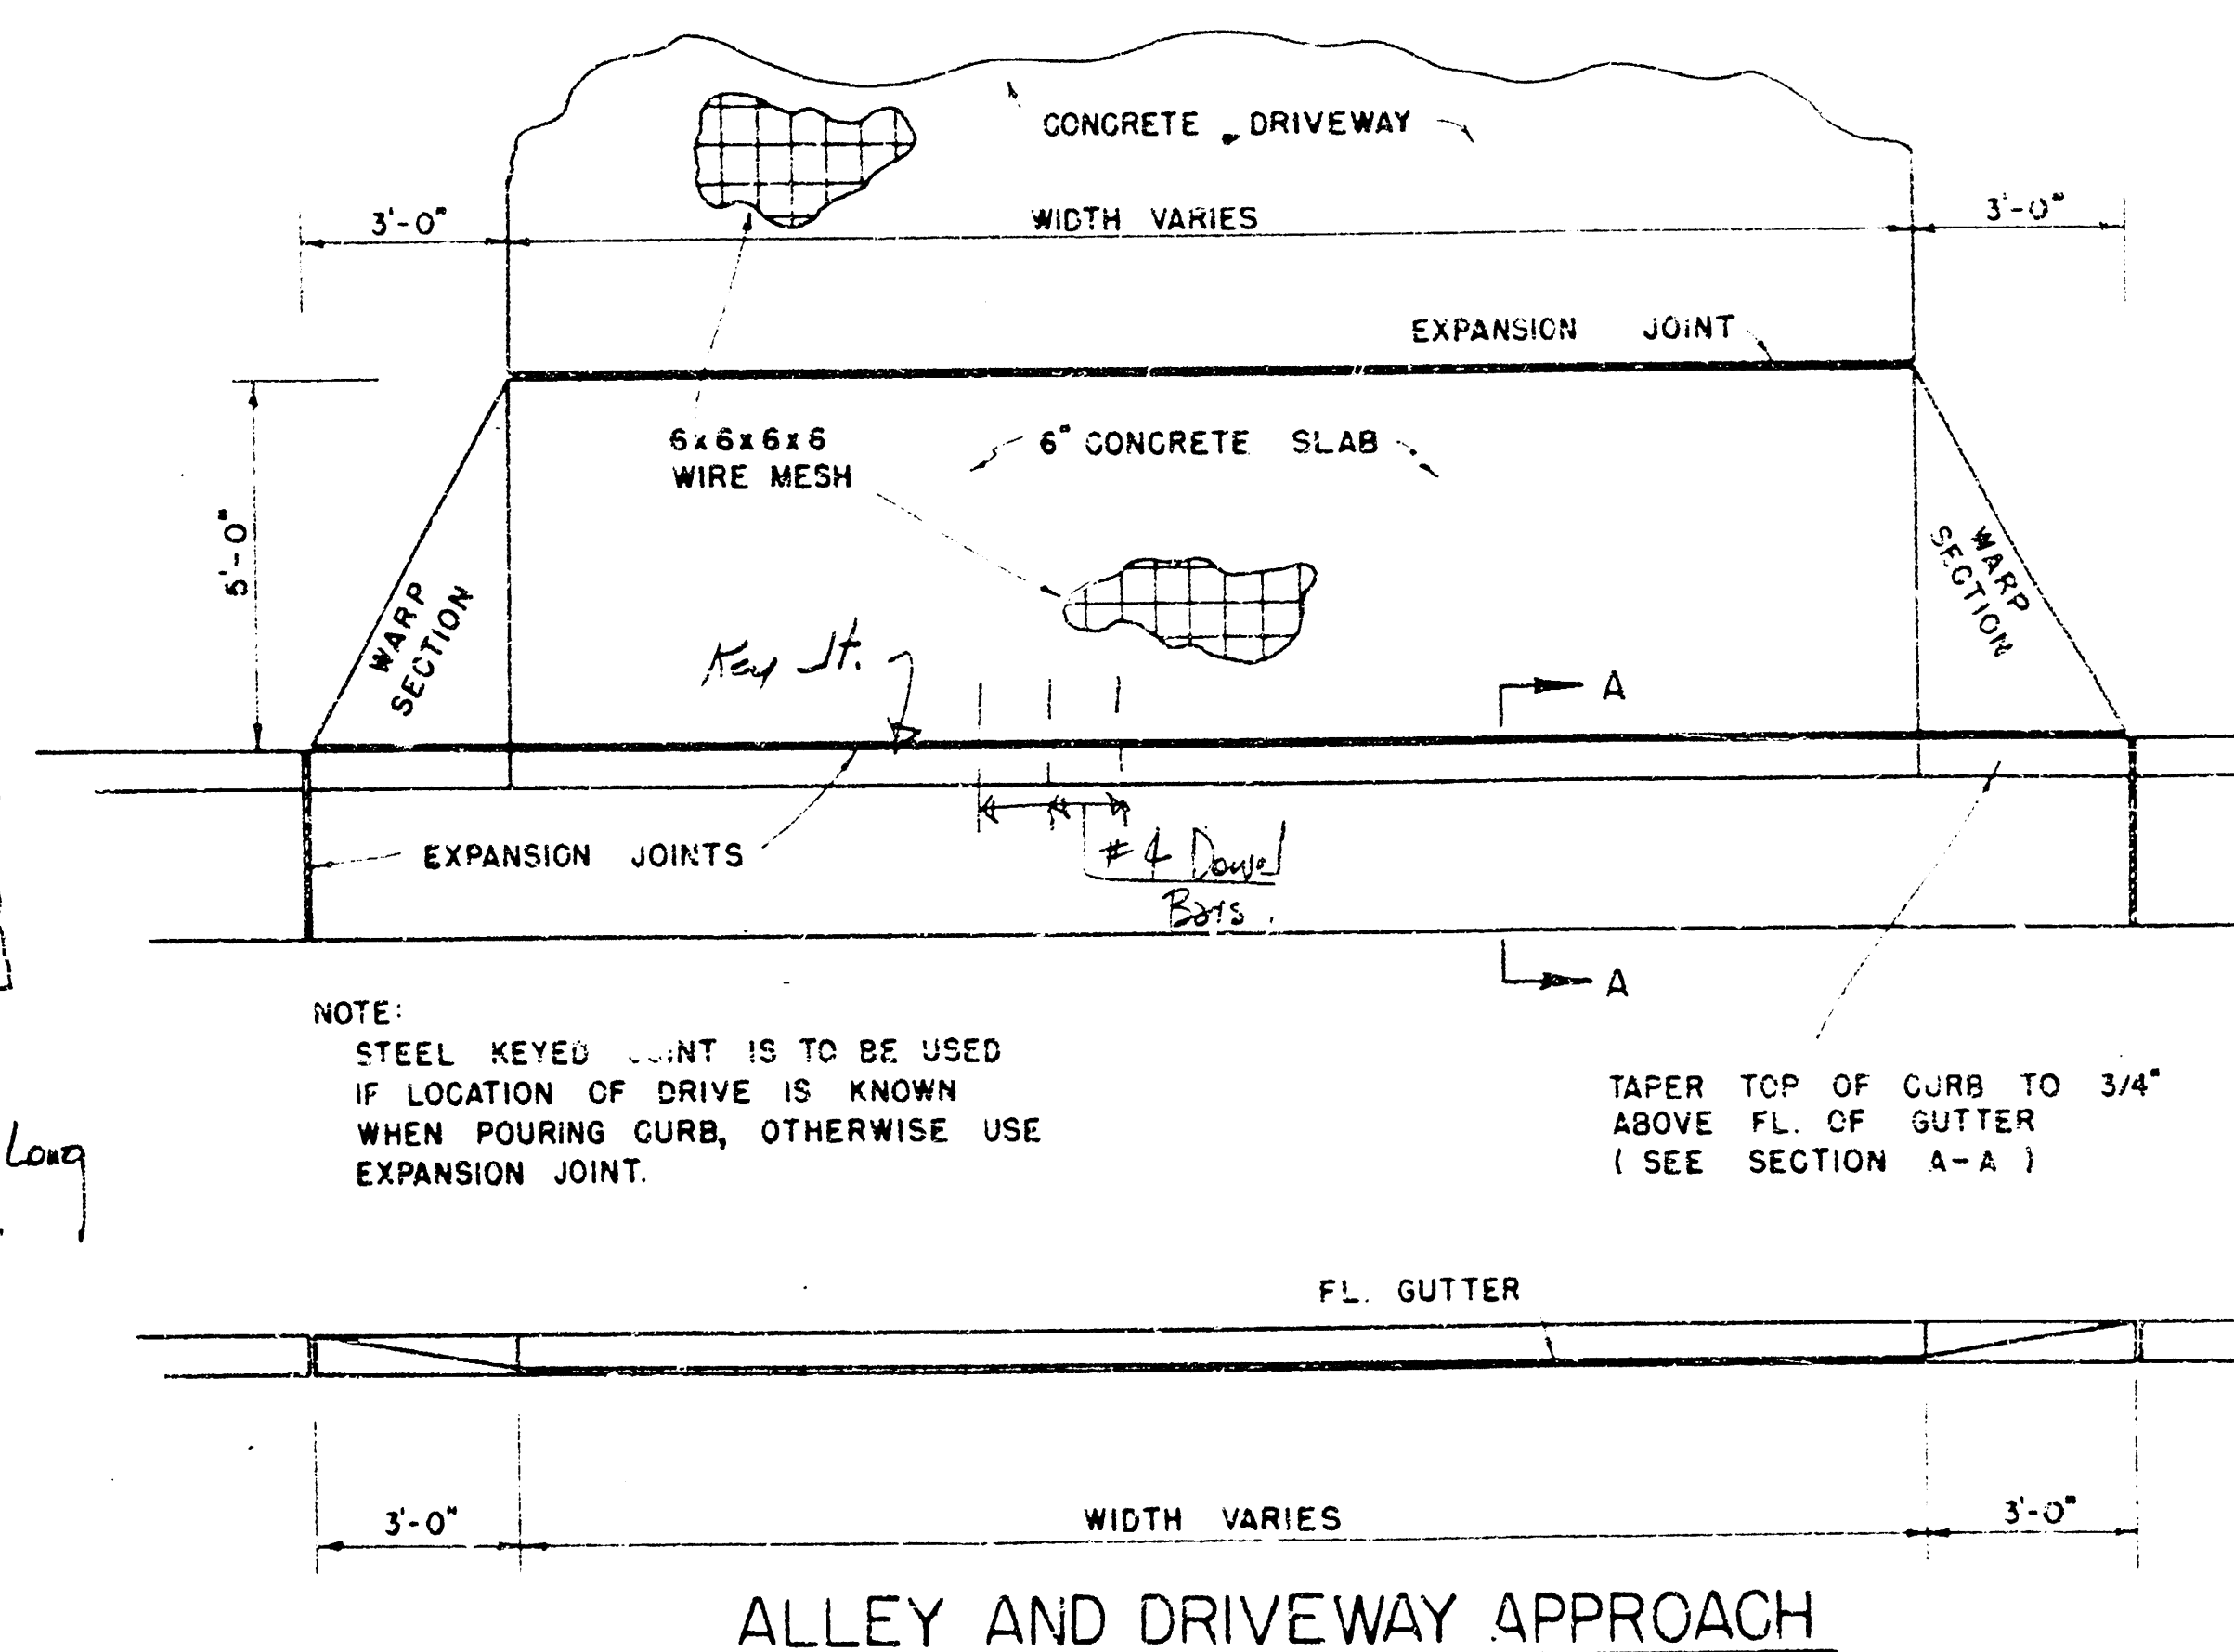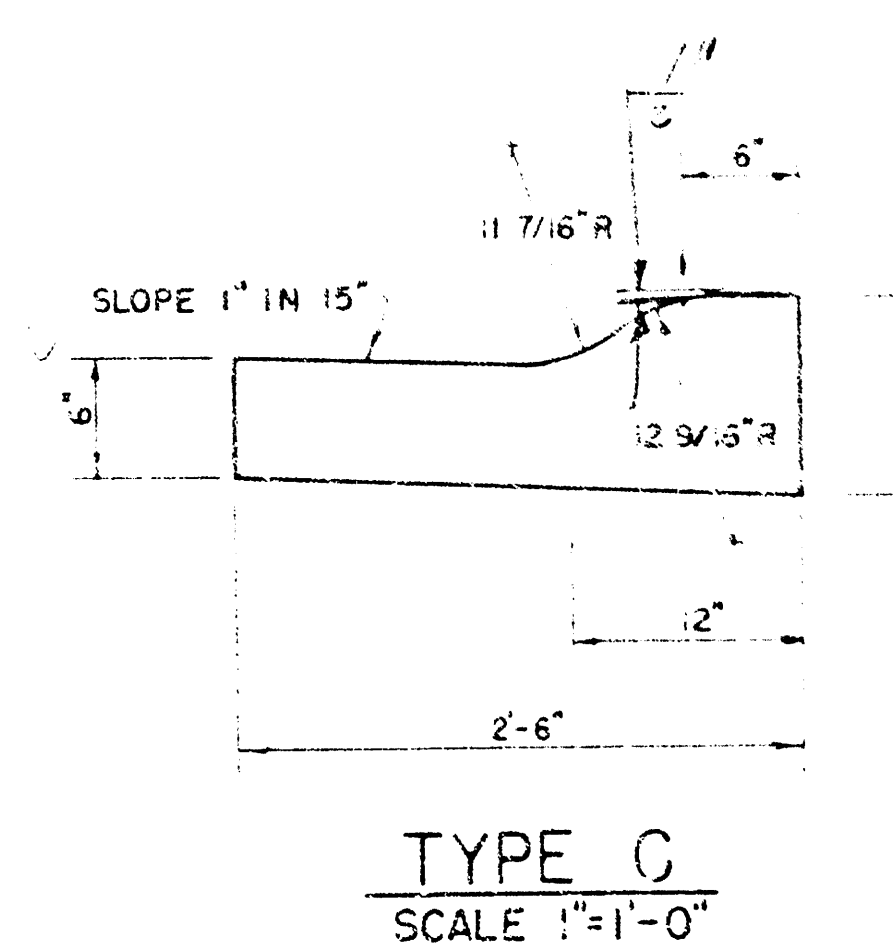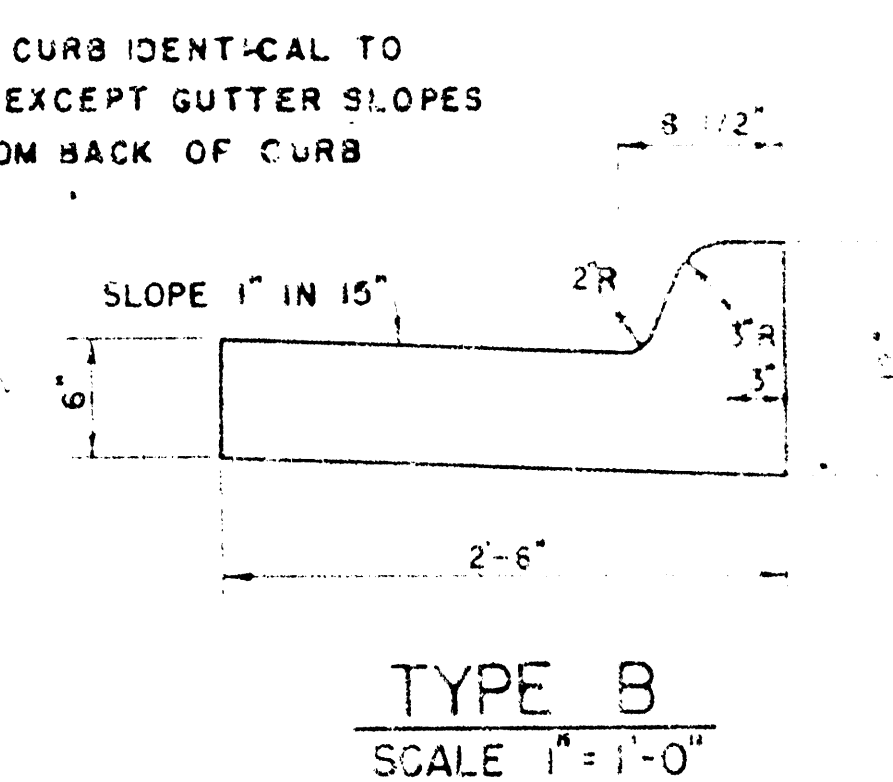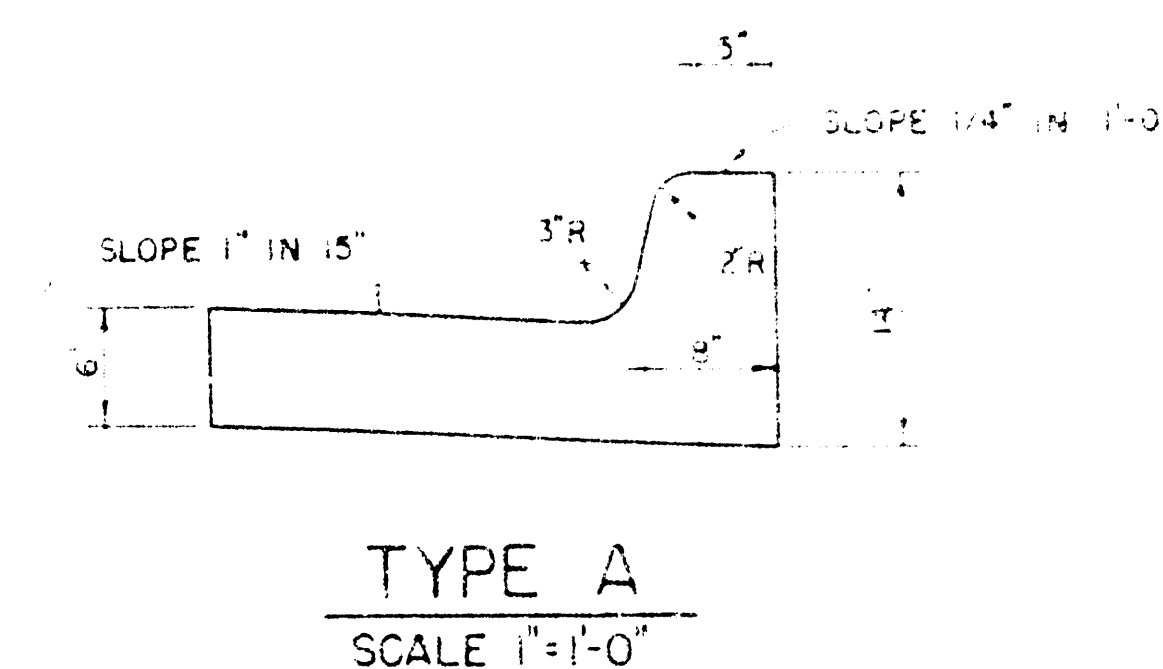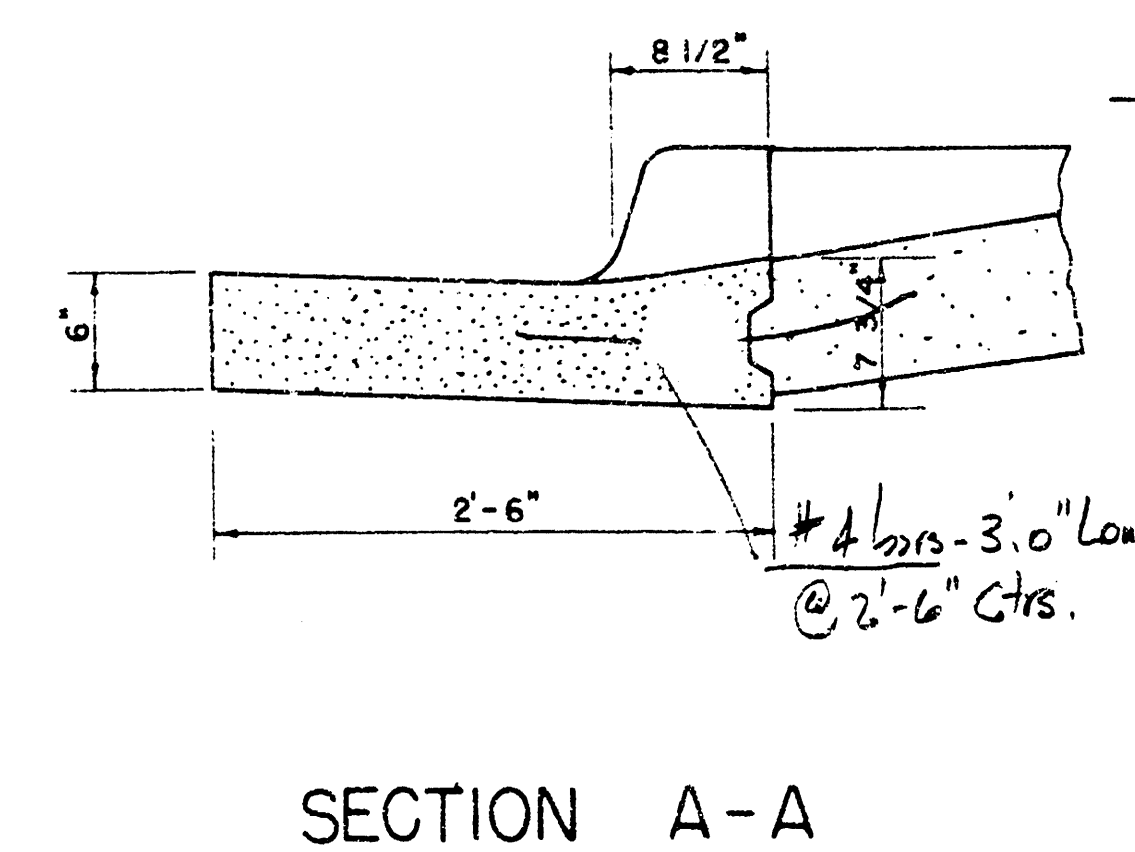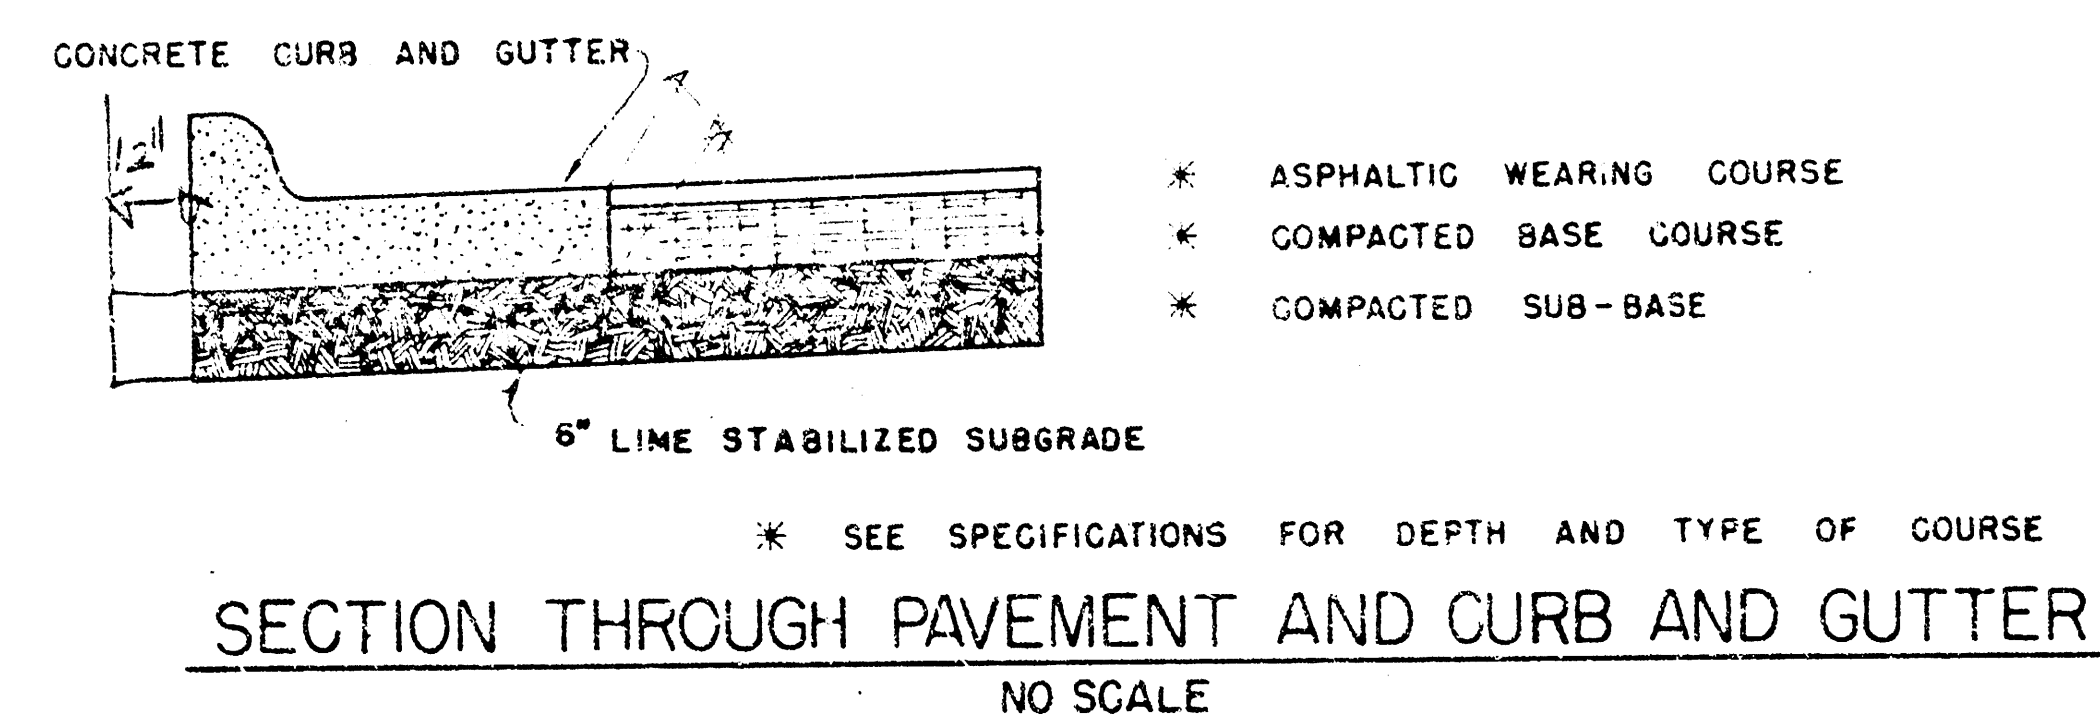

PLANS


STREET IMPROVEMENTS

AULLS FIRST ADDITION

REISS AND GOODNESS ENGINEERS
2160 E. DOUGLAS WICHITA-KANSAS
1975


Kenny Hill

DATE	3-20-75
REVISIONS	
SHEET NO	3 OF 3 SHEETS

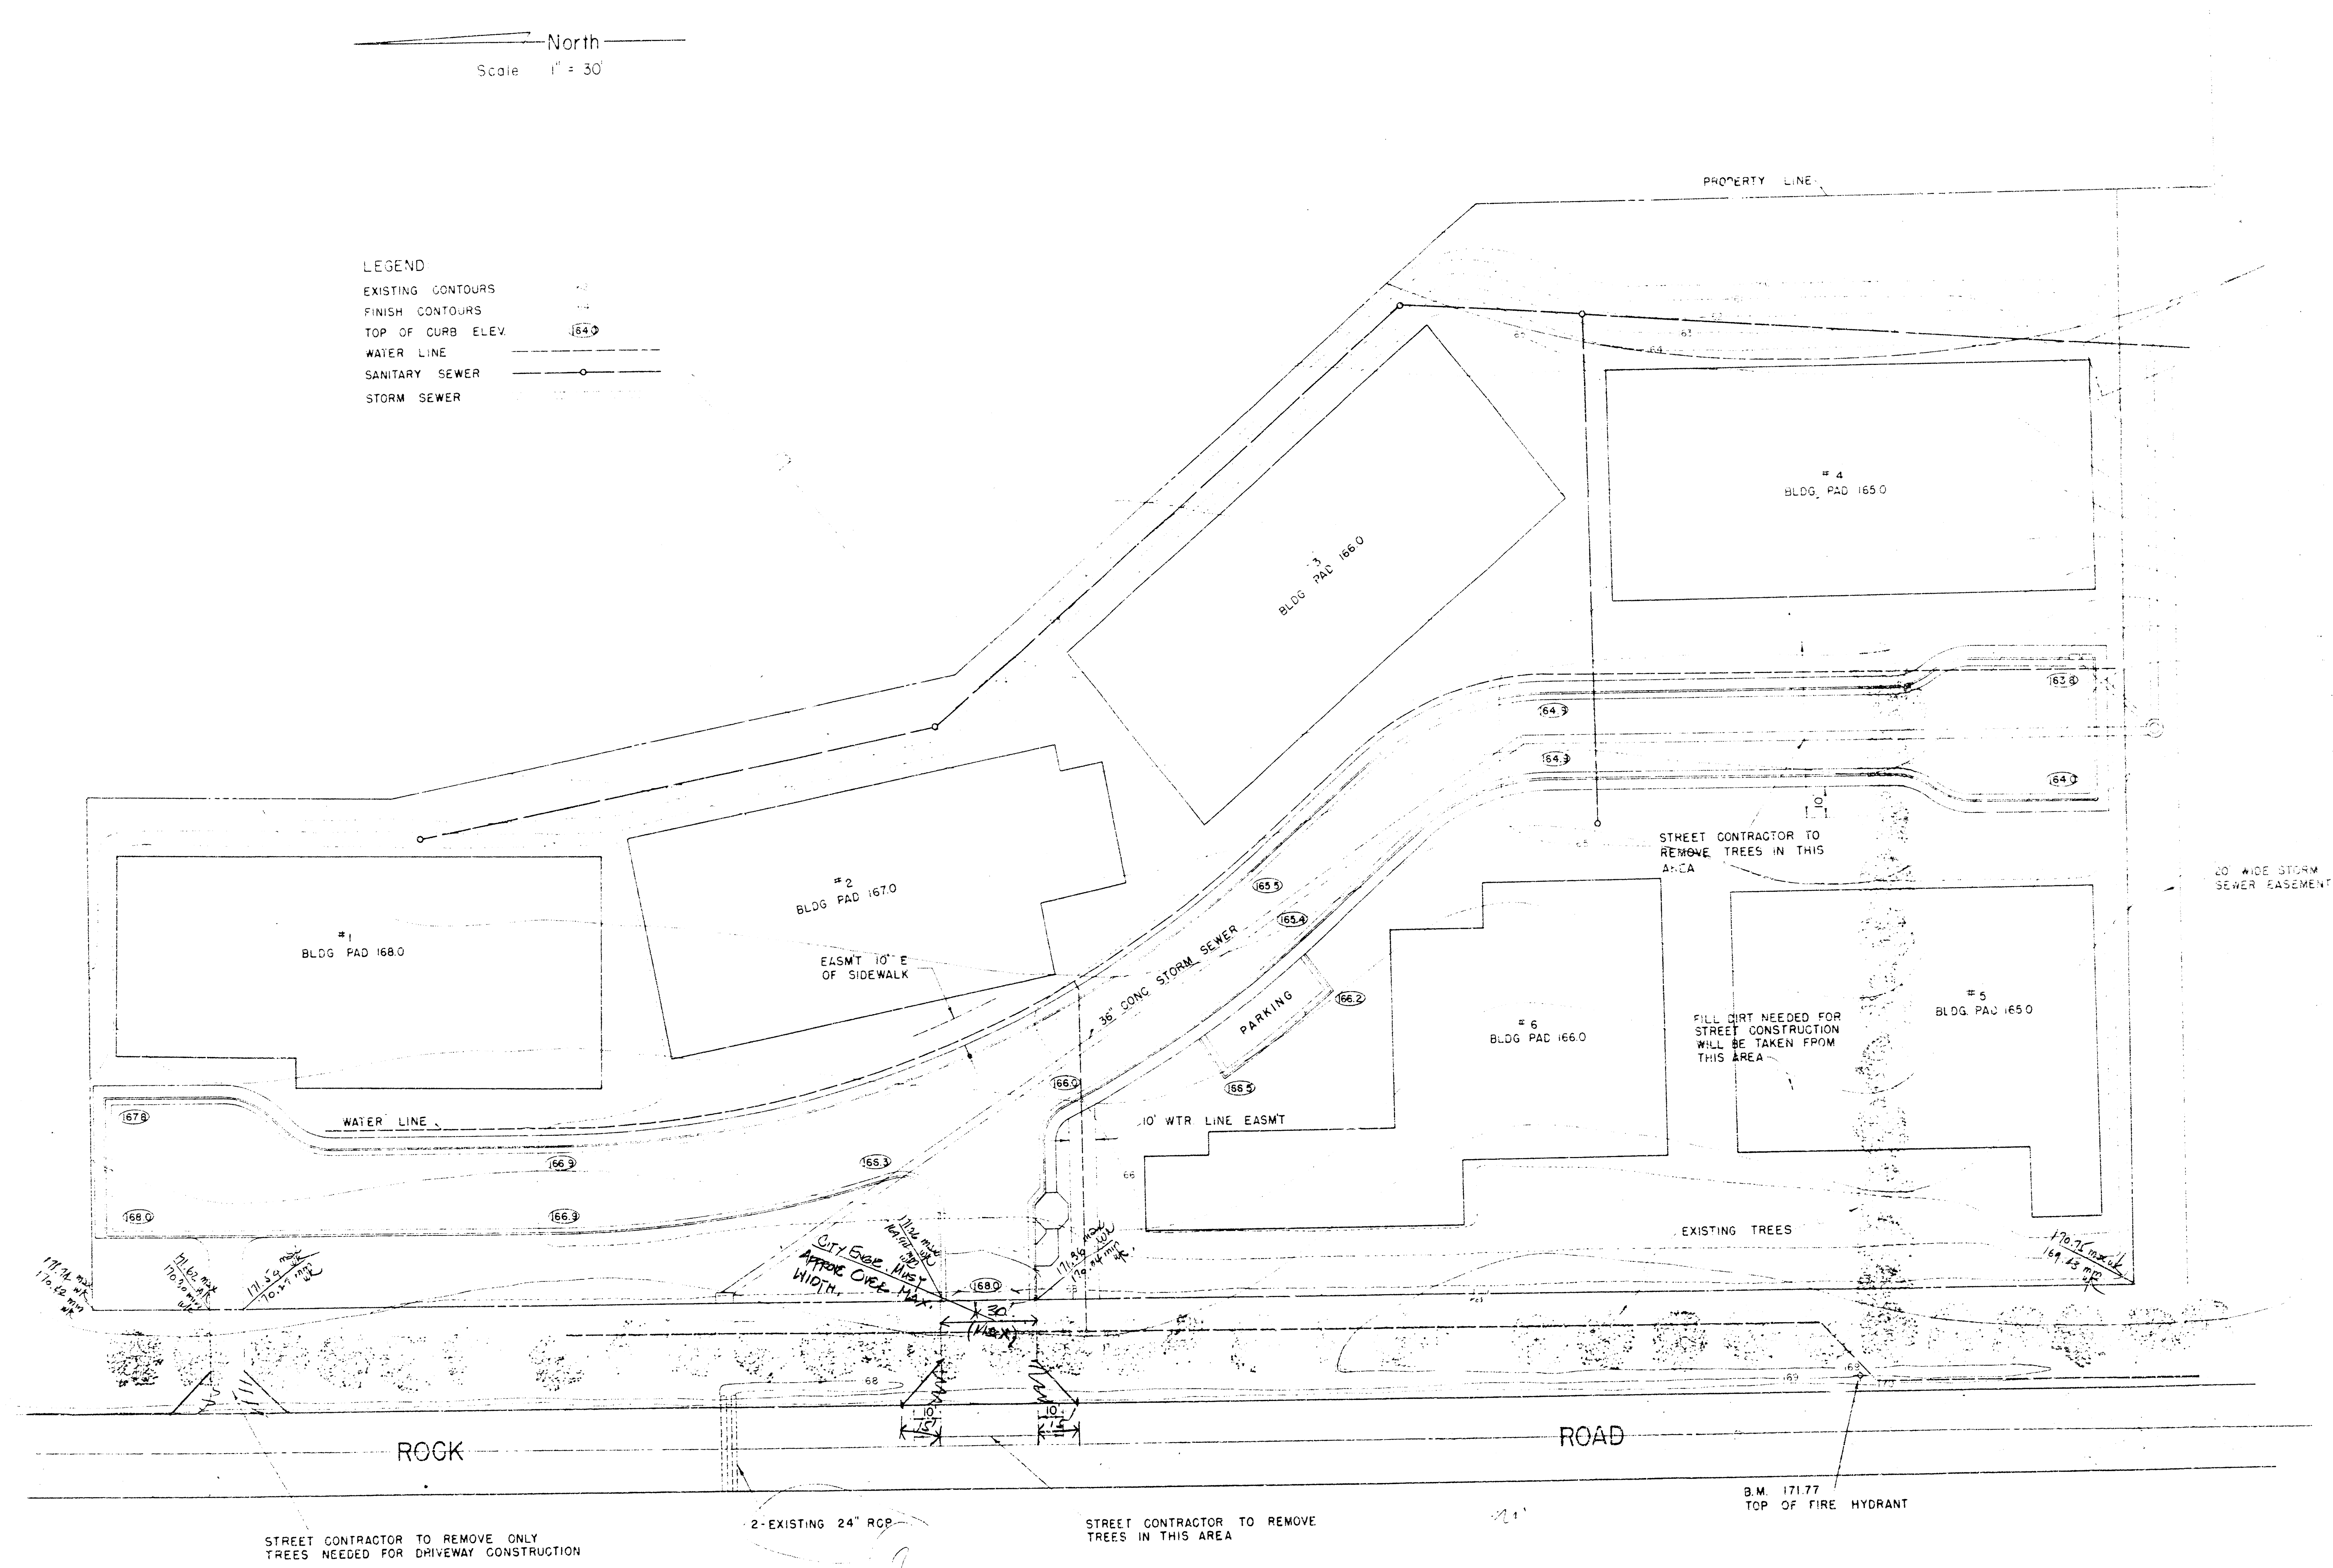

WILLIS & GORDON ENGINEERS

STREET IMPROVEMENTS
VAN BUSKIRK

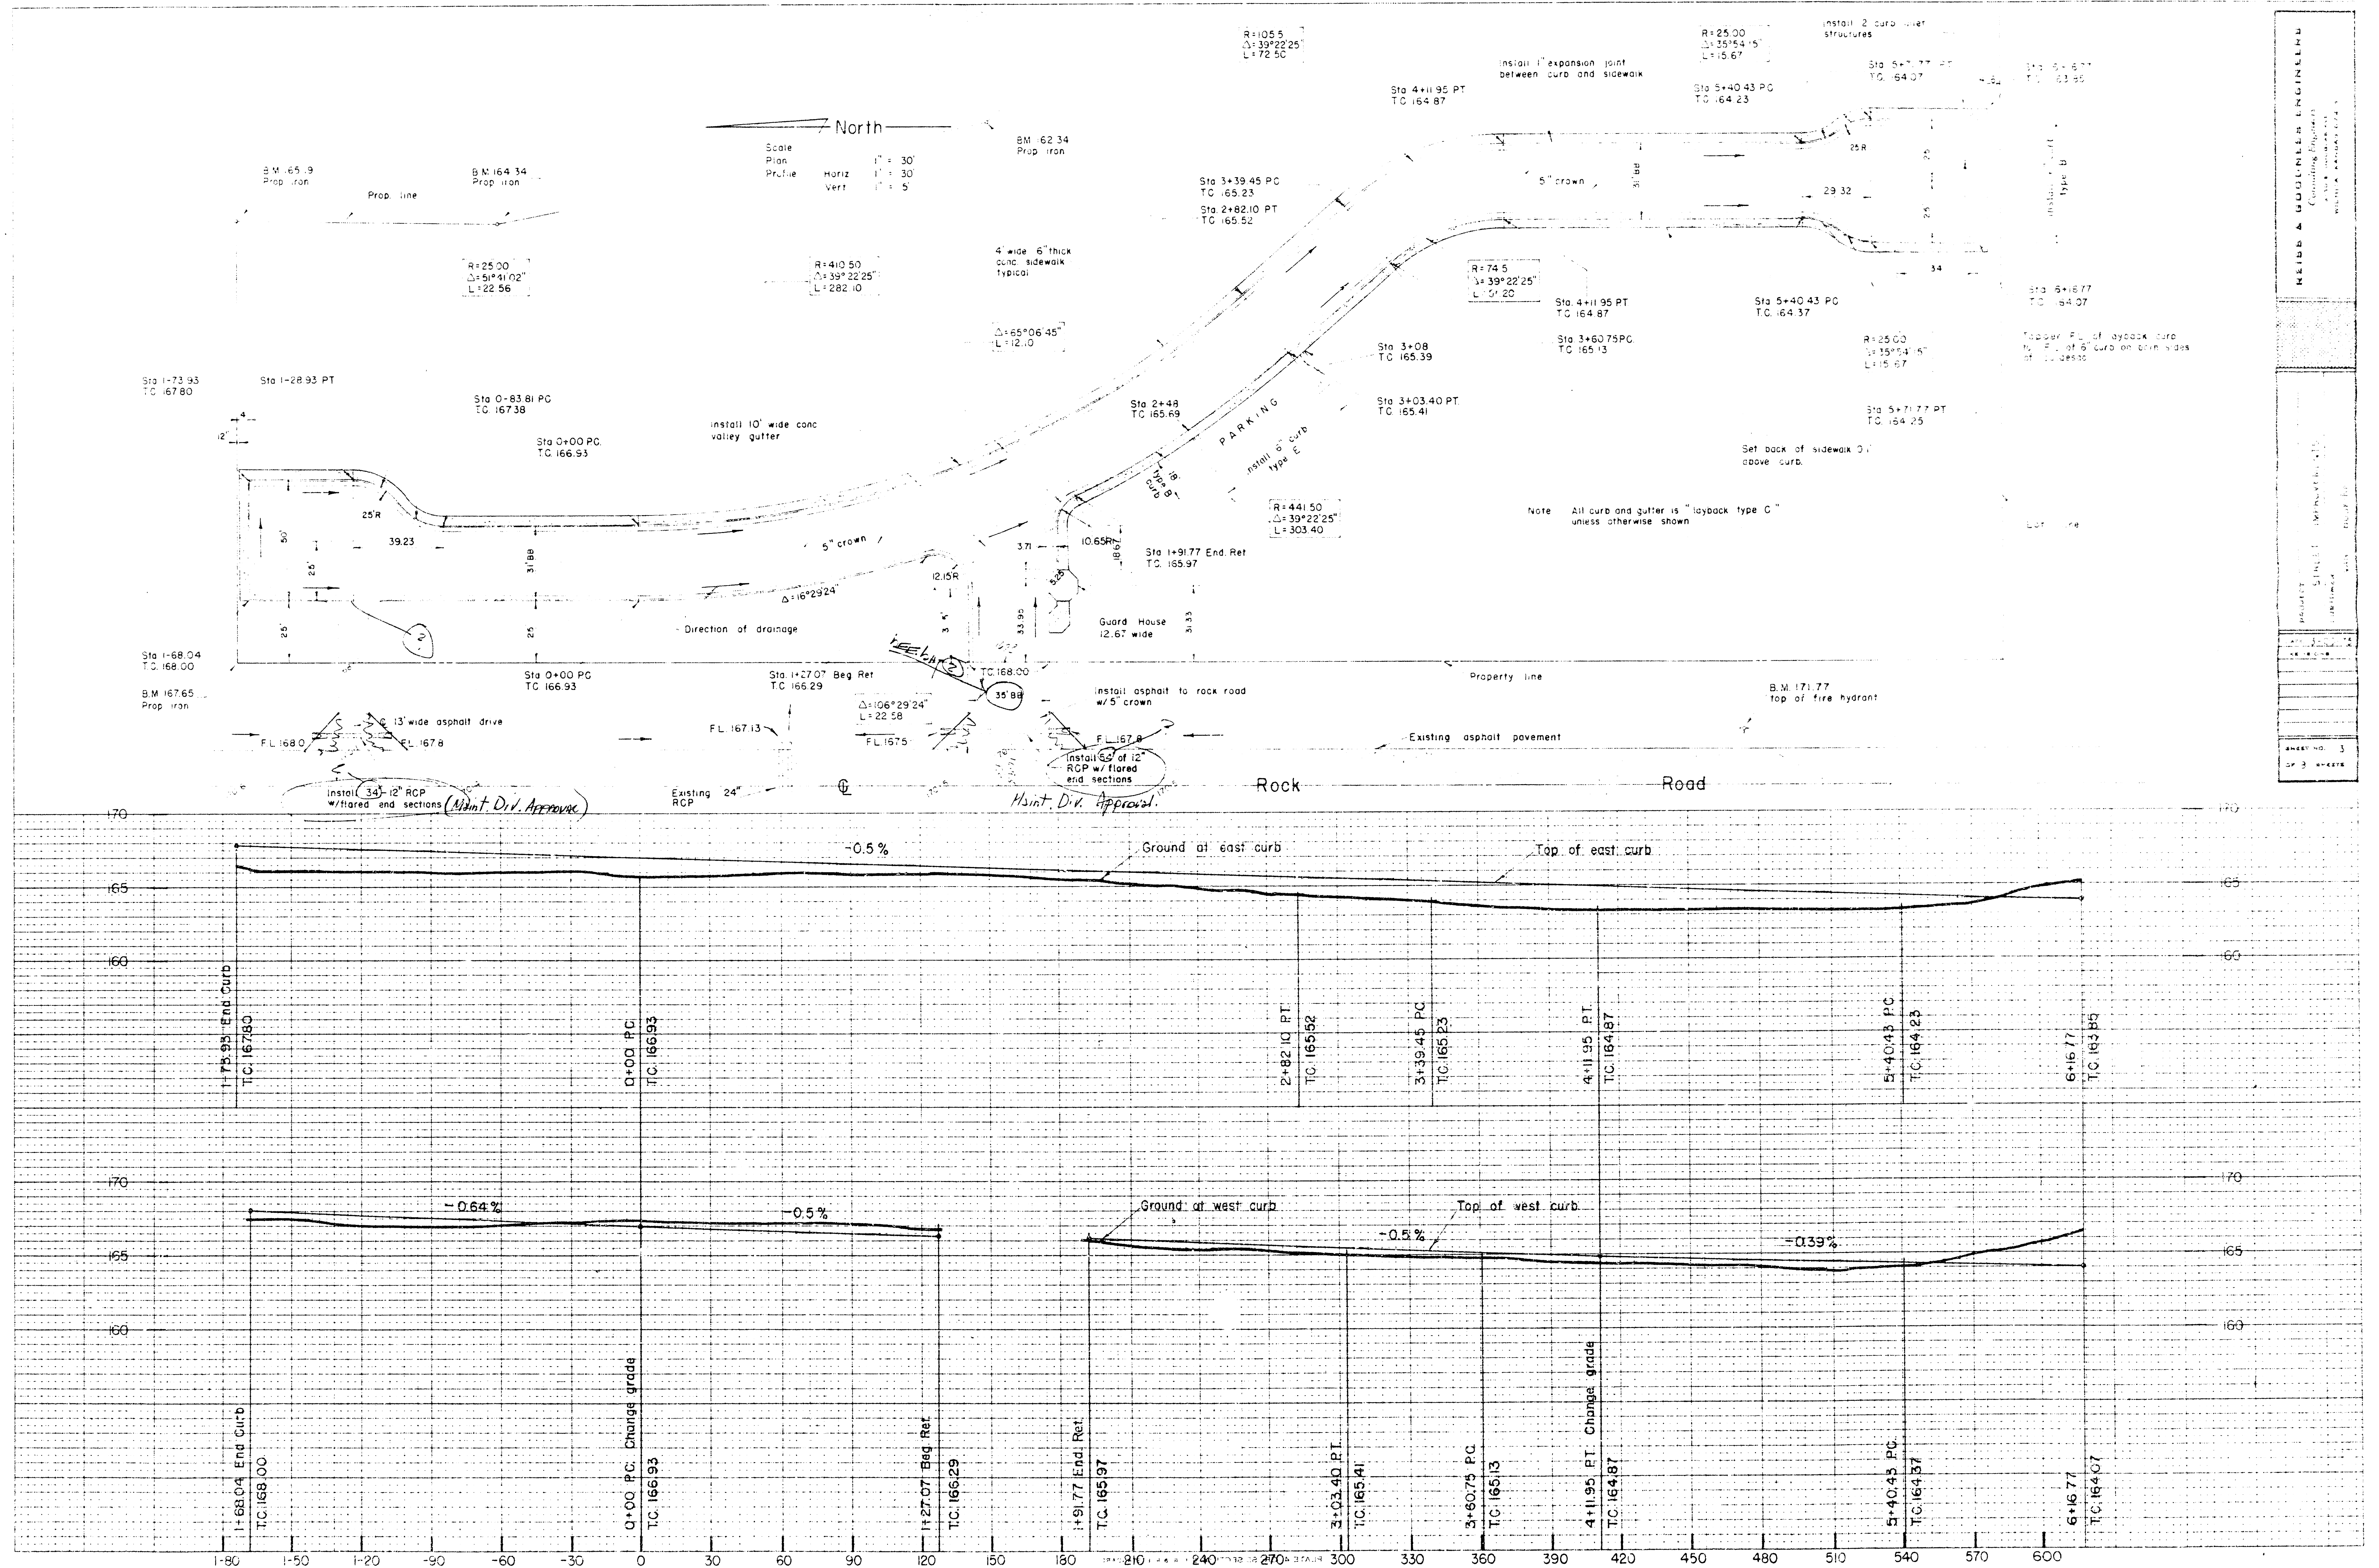



