ANNA ST
NL 12th st to SL 13th st N.

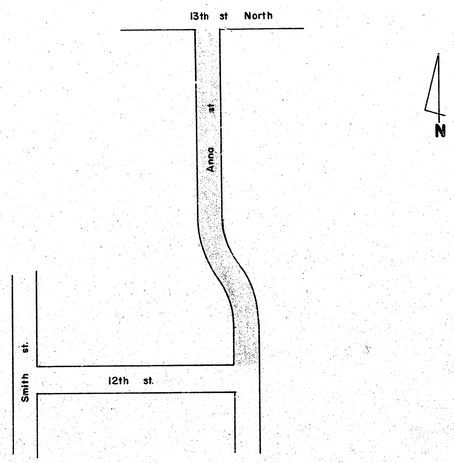

Department of Engineering
City of Wichita, Kansas
R. W. Bruggeman Director Engineering / City Engineer
Proj. no. 472-76-245-81079-000-000-001

STEPHEN R. MACKEY
LICENSED
7714
KANSAS
PROFESSIONAL ENGINEER

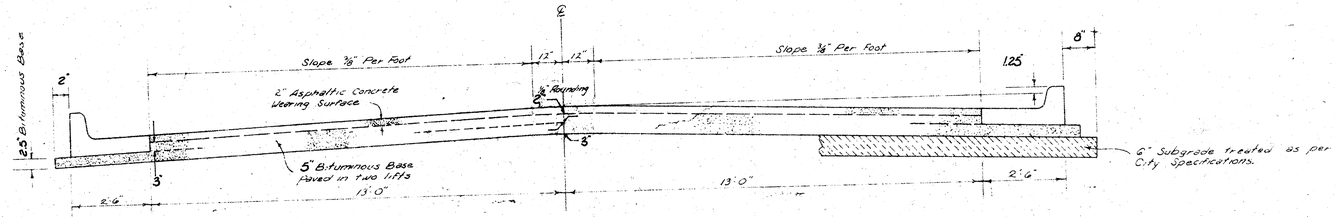

TYPICAL SECTION

31' ASPHALTIC CONCRETE PAVEMENT WITH BITUMINOUS BASE

The A.C. pavement between the Comb. Curb & Gutter shall be paid as Sq. Yds. 7" A.C. Pavement (5" Bituminous Base). The Bituminous Base under the Comb. Curb & Gutter shall be paid as Sq. Yds. 2.5" Bituminous Base.

COMBINED CURB & GUTTER

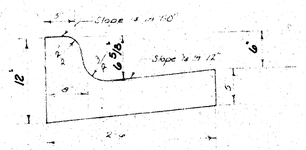

ROLL TYPE CURB & GUTTER

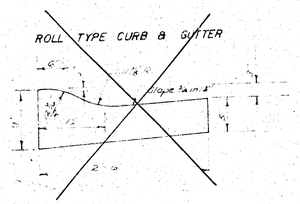

A TACK COAT OF EMULSIFIED ASPHALT (SS-1H) SHALL BE APPLIED AT AN APPROXIMATE RATE OF 0.05 GALLONS PER SQ. YD. BETWEEN LIFTS OF ASPHALTIC MATERIALS WHEN ORDERED BY THE ENGINEER. TACK COAT WILL NOT BE PAID FOR DIRECTLY AND SHALL BE CONSIDERED AS SUBSIDIARY TO PRICE BID FOR ASPHALTIC PAVEMENT.

BITUMINOUS BASE AND ASPHALTIC CONCRETE WEARING SURFACE SHALL BE PLACED WITH A LAYDOWN MACHINE HAVING AUTOMATIC CONTROLS FOR CROWN AND GRADE. CONSTRUCTION JOINTS IN EACH LIFT SHALL BE STAGGERED A MINIMUM DISTANCE OF 1' WITH JOINTS IN PRECEDING LIFTS AND SUCH THAT A JOINT WILL BE CONSTRUCTED ON THE PAVEMENT CENTERLINE IN THE TOP LIFT.

DETAIL OF TRANSVERSE CONSTRUCTION JOINTS

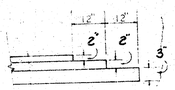

TRANSVERSE CONSTRUCTION JOINTS SHALL BE CONSTRUCTED IN FLEXIBLE BASE PAVEMENTS AT LOCATIONS WHERE PAVEMENT TEMPORARILY ENDS TO FACILITATE FUTURE PAVEMENT CONSTRUCTION AS SHOWN BY DETAIL. THE COST OF CONSTRUCTING THE TRANSVERSE CONSTRUCTION JOINTS SHALL NOT BE MEASURED OR PAID FOR DIRECTLY BUT SHALL BE INCLUDED IN THE BID PRICE FOR SQUARE YARDS OF ASPHALTIC CONCRETE PAVEMENT.

CITY OF WICHITA, KANSAS

DEPARTMENT OF — ENGINEERING

DATE. _____

2/6

FILMED FROM THE BEST AVAILABLE COPY.....

BASELINE ON EAST ℄

B.M. 1269.34 City Std. @ Baker & 13TH
B.M. 1380 N.E. Cor. Conc. Porch Ho.# 1355 N. Anna, On S.W. Cor. Anna & 13TH

No More Than 22-20' Drives To Be Constructed On This Project.

N

Scale 1" = 20'

Δ 37°09'00" | 231.99' | 77.96' | 150.41' | L.C. 147.80'

CURVE DATA BASED ON ℄ R. | 18°34'30"

STA.	ARC	S. Ch.	S. Ex.	DEFLECTION ANGLE	TOTAL DEFLECTION
0+90				0°00'00"	0°00'00"
1+00	10.00	7.71	9.70	1°14'06"	1°14'06"
1+03.90	3.90	3.01	3.78	0°28'53"	1°42'59"
1+25	21.10	16.27	20.40	2°36'20"	4°19'19"
1+30	5.00	3.86	4.85	0°37'03"	4°56'22"
1+50	20.00	15.43	19.39	2°28'11"	7°24'33"
1+75	25.00	19.28	24.23	3°05'14"	10°29'47"
2+00	25.00	19.28	24.23	3°05'14"	13°35'01"
2+25	25.00	19.28	24.23	3°05'14"	16°40'15"
2+40.91	15.91	11.89	14.94	1°54'11"	18°34'26"

Δ 37°09'00" | 171.99' | 57.80' | 111.51' | L.C. 109.57'

CURVE DATA BASED ON ℄ R. | 18°34'30"

STA.	ARC	S. Ch.	S. Ex.	DEFLECTION ANGLE	TOTAL DEFLECTION
2+40.91				0°00'00"	0°00'00"
2+50	9.59	12.54	2.98	1°35'51"	1°35'51"
2+75	25.00	32.66	25.99	6°09'51"	5°45'42"
3+00	25.00	32.68	25.99	6°09'51"	9°55'33"
3+25	25.00	32.68	25.99	6°09'51"	18°05'24"
3+38.12	13.12	17.16	13.45	2°11'07"	16°16'31"
3+51.92	13.80	18.05	14.36	2°17'55"	18°34'26"

THE CONTRACTOR SHALL BE RESPONSIBLE FOR PRESERVING PROPERTY IRONS. THE CONTRACTOR SHALL BE REQUIRED TO RE-ESTABLISH ANY PROPERTY IRONS WHICH ARE DAMAGED OR DESTROYED BY HIS CONSTRUCTION OPERATIONS. SUCH IRONS SHALL BE RE-ESTABLISHED BY A LICENSED LAND SURVEYOR OR A LICENSED PROFESSIONAL ENGINEER IN ACCORDANCE WITH STATE LAWS.

SUB-GRADE

TYPE OF SUB-GRADE TREATMENT SHALL BE DETERMINED BY THE FIELD ENGINEER. SUB-GRADE TREATMENT MAY CONSIST OF LIME TREATMENT, CEMENT TREATMENT, SUB-GRADE MODIFICATION, OR ANY COMBINATION OF THESE.

EARTHWORK PROPERTY

EXCAVATION	17699 CY
+10%	177.0 CY
TOTAL	19469 CY

MANIPULATION (6" LIFT) 27324 SY

*Trees to be removed are marked as shown unless in the opinion of the Engr. can be saved, shall be spared.

ANNA st
NL 12th st to SL 13th st
Dept. Engineering
City of Wichita Kansas
R.W. Bruggeman Dir. Eng./ City Eng.
Proj. no. 472-76-245-81079-000-000-001

SURVEY CLASS: ESR CADNET
PLAN BY: HOWELL BK. 17 & 100
CALC BY: HOWELL
CHECKED

FILMED FROM THE BEST AVAILABLE COPY .....

SURVEY CLASS ERR CARDS
PLAN NO. DATE 12-6-60
PLAN BY E. HOWELL
CHECKED

SCALE 1" = 20'

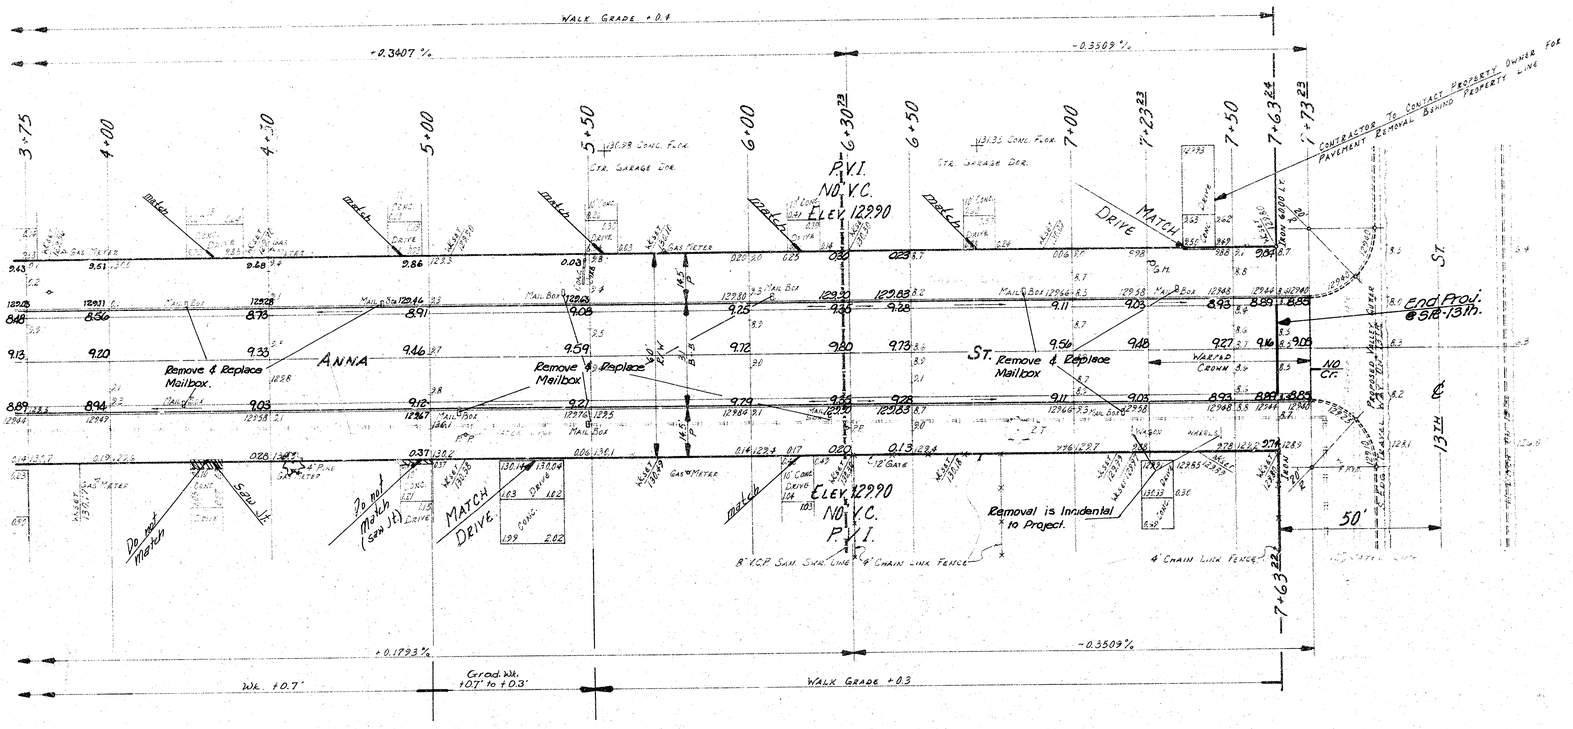

FILMED FROM THE BEST AVAILABLE COPY .....

81073.

ALL PROPERTY

MEASURED QUANTITIES FOR FINAL ESTIMATES ON PAVING

Form KB-066

STREET NAME Anna St. FROM NL 12th st TO SL 13th st CONTRACTOR MID KANSAS CONSTR. KIND OF PAVEMENT 7" 10W/2" BIT

Sta.	Width	Dist.	Av. Width	Area	Square Yards Pavement
SQ. YDS. 7" AC W/ 5" BIT					
0+00	26.0				
7+63 45	26.0	763.45	26.0		
		1 x 0.86			
		19,851.62			2,205.75 SY
SQ. YDS MANIP					
		3.17 x 1,526.9			
		1 x 19,851.62			
		24,691.893			2,743.55 SY
SQ. YDS. 2 1/2" BIT. BASE					
		2.67 x 1,526.9 ÷ 9			= 453.05 SY
TONS CEMENT					
(42 #/SY)					
CALC = 57.6 T					
TICKETS = 58.3 T (USE)					

End Area At Station	End Area Area	Dist.	Av. Area	Volume	Cubic Yards Excavation
		Excavation (PROD.)			
0+00	408				
		50	57.4	106.3	X
+50	739				
		40	96.2	142.5	X
+90	1184				
		8.7	126.4	40.7	X
1+00	1343				
		26.1	158.5	153.2	X
+30	1826				
		17.4	180.6	116.4	X
+50	1786				
		21.8	165.0	133.2	X
+25	1513				
		"	145.9	117.8	X
2+00	1404				
		21.8	140.3	113.3	X
+25	1401				
		13.4	141.1	70.0	X
+40 41	1420				
		11.3	139.5	58.4	X
+50	1369				
		29.4	118.1	128.6	X
+75	992				
		"	78.4	85.4	X
3+00	575				
		29.4	58.4	63.6	X
+25	593				
		31.0	68.5	80.2	X
+51 92	777				
		23.1	66.1	56.6	X
+75	545				
		25	49.6	45.7	X
4+00	442				
		50	43.0	79.6	X
+50	417				
		"	39.4	73.0	X
5+00	370				
		"	29.8	55.2	X
+50	226				
		"	13.5	25.0	X
6+00	43				
		"	2.8	5.2	X
+50	1.2				
		"	2.1	3.9	X
7+00	2.9				
		50	3.2	5.9	X
+50	3.4				
		13.2	2.4	1.2	X
+63 23	1.3				
		10'	0.9	~~0.0~~ 0.3	
+73 23	0.5				
				~~1969~~ 1761.2	

6" DRIVE

LS	450	SQ. FT. W/ 6" OR REM.
	188	2.5 x 10 } 55 SF
	283	3 x 10 }
	340	OVERHAUL (SEE PROJ. MEMO)
	296	1,176 / 3,798 x 48 x 2.64 } = 58.76
	291	x 36 x 15.84 } = 264.40
	245	x 3,714 x 31.68 } = 54,554.61
	217	$0.05 x 54,877.77 = $2,743.89
	330	
	378	
RS	288	CHECK 1,761 / 3,798 x (118,356.4 x .05)
	203	= 2,743.85
	333	
	323	
	208	
	327	
	307	
	190	
	337	
	304	
	374	
	6,212 SF	

7-10-81

~~50~~

RET. WALL REM.
55 LF (PLAN)

Measured By	GREENE
Date	AUG 82
Book No.	11-A
Finaled By	TATE

	58-10 MANIP	TONS CEMENT	2 1/2" BIT.	Steel	Square Yards 7" Pavement REC	Int. Cb.	C & G	Sep. Cb.	Sep. Gtr.	6" Wk.	6" Dr.	Cubic Yards Excavation	M & R REP.	LG. TR. REM.	SM. TR. REM.	RET. WL/WKDR REM.	RET. WL/WKDR REM.	Insp.	Publ.	Abstr.	Appre.
Property	2,744	58	453		2,206		1526.5				6,212	1,761	21	1	9	55	55				
City	~	~	~		~		~				~	~	~	~	~	~	~				
Totals																					5/6
Unit Prices																					
Total Cost																					

FILMED FROM THE BEST AVAILABLE COPY.....

TATE
AUG 82

STATEMENT OF COST

PROJ. NO. 472762458107900000

P.E. $1,856.00

FOR CONSTRUCTION OF: ANNA ST. ~ N.L. 12TH to S.L. 13TH

WORKING DAYS ~ OK

QUANTITIES PROP.	QUANTITIES CITY	QUANTITIES TOTAL	UNIT PRICE	CONSTRUCTION ITEM	COSTS PROP.	COSTS CITY	COSTS TOTAL
2,206	0	2,206	9.37	SQ YDS. 7" R.C. PVMT (5" BIT. BASE)	20,670.22	0.00	20,670.22
453	↑	453	3.35	SQ YDS. 2½" BITUMINOUS BASE	1,517.55	↑	1,517.55
1,527		1,527	6.00	LIN. FT. COMB. CURB & GUTTER	9,162.00		9,162.00
1,761		1,761	2.17	CU. YDS. EXCAVATION	3,821.37		3,821.37
6,212		6,212	2.65	SQ. FT. 6" DRIVE	16,461.80		16,461.80
2,744		2,744	1.00	SQ. YDS. MANIPULATION	2,744.00		2,744.00
58		58	78.39	TONS CEMENT	4,546.62		4,546.62
21		21	30.00	MAILBOXES REMOVED & REPL.	630.00		630.00
52		55	0.10	LIN. FT. RETAINING WALL REMOVED	5.50		5.50
55		55	0.35	SQ. FT. WK & DR. REMOVED	19.25		19.25
1	↓	1	1.00	LARGE TREE REMOVED	1.00	↓	1.00
9	0	9	0.75	SMALL TREES REMOVED	6.75	0.00	6.75
			L.S.	OVERHAUL	2,743.89		2,743.89
				SUBTOTAL	62,329.95	0.00	62,329.95
				ENGINEERING AND INSP.	6366.37	-	6366.37
				ADMINISTRATION	934.95	-	934.95
				STREET NAME SIGNS	-	53.75	53.75
				PUBLICATION	110.96	-	110.96
				ABSTRACTING	8.25	-	8.25
				CONSTRUCTION COST	69,750.48	53.75	69,804.23
				TEMP. NOTE INT.	4663.73	-	4663.73
	6/83			TOTAL COST	#74,414.21	# 53.75	#74,467.96

FILMED FROM THE BEST AVAILABLE COPY .....